

CENTRAL MAPPING AUTHORITY
Department of Lands

Trigonometrical Survey of N.S.W.

RECONNAISSANCE and MAINTENANCE REPORT 2010

STATION EUCLUNDURM (P) TS 6062

This Trig. Station has been:-

Note: Cross out word or words which do not apply

1. ~~Completely cleared to permit 360° vision to surrounding trig.~~

2. Cleared by lanes bearing from Trig. Mast

3. Trig. Mast & Vanes have been painted white & black respectively.

4. The Trig. was unpiled/~~not supplied~~, ~~dimensions now being~~ Steel Plug should be explicit, e.g. Steel plug, Brass plug, Bolt, G.I. Pipe

Description of mark Steel Plug m above rock/concrete 0.02 m above G.L.

Height of mark 0.02 m above rock/concrete m above G.L.

Height of Top Vanes to Top Mark 3.02 m. Diameter of Vanes (vertical) 0.02 m.

Height of Cairn 1.10 m. Diameter of Cairn 0.10 m.

Length of Mast 3.04 m. (~~approximate if not supplied~~)

5. A SSM 100 set in ~~conc/rock~~ has been placed 4.526 m. bearing 100 °M from Trig. Mast

6. A set in conc/soil has been placed m. bearing °M from Trig. Mast

7. A set in conc/soil has been placed m. bearing °M from Trig. Mast

8. A set in conc/rock has been placed m. bearing °M from Trig. Mast

9. Connection to m. bearing °M

10. Connection to m. bearing °M

11. Connection to m. bearing °M

12. Connection to m. bearing °M

13. Diff. Ht. SSM 100 is 0.13 m. above TRIG. PLUG

14. Diff. Ht. is m. above below

15. Diff. Ht. is m. above below

16. Diff. Ht. is m. above below

Prepared by: L.M. HAYES

Noted on U.T.M. Card

Checked: C. STAPLEY

Co: PARULIP

Map Sheet: GUILGONG

Inspected by: L.M. HAYES

Authority: DEPT OF LANDS


Ph: EUCLUNDURM

No: 6833

Date: 21-5-75

Field Book: 6833 (R.C.S.A.)

Beacon Diagram

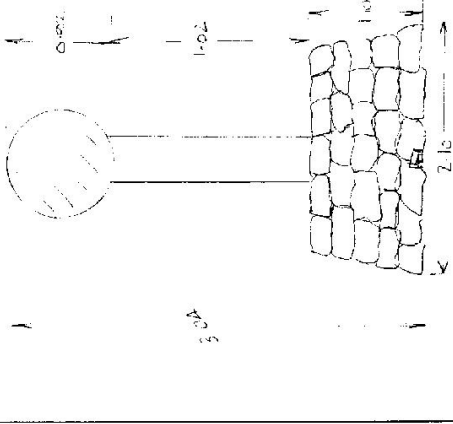

Date

Notes

Record of Station

Inspected, CORRECTLY General Book 6833


Checked

STATION **ELBUNDURU TS 6062**

Owners Name..... Current Occupant.....


Address..... Address.....

Access 21-5-1975

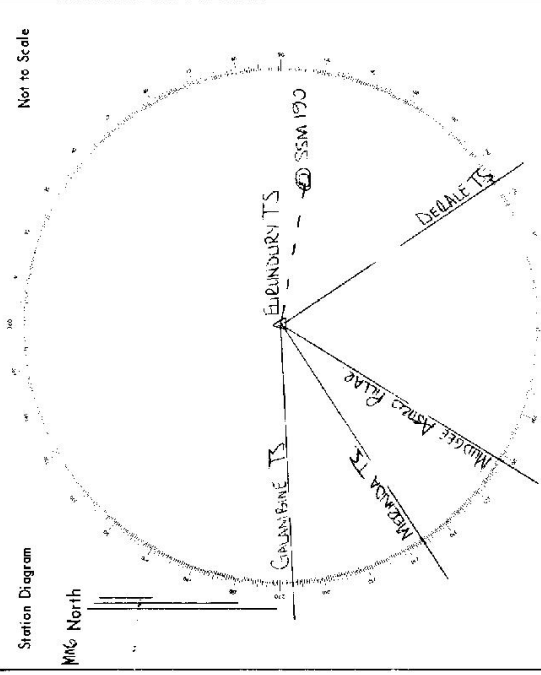

List of Observed Directions:-

Standpoint: TRIG PULLA		Standpoint: TRIG PULLA	
Station	Direction	Station	Direction
MERINDA TS	350 57 068	MUDDEE ASTILO KALLA	350 57 068
GALAMBANE TS	30 11 176	MEZINDA TS	24 20 286
DEBALE TS	260 58 447	GALAMBANE TS	54 32 115
MUDDEE ASTILO KALLA	350 59 068	SSM 190	282 23 135
New 1975 Trig Pulla			
Station	Direction	Station	Direction
DEBALE TS	350 57 068		
MERINDA TS	14 16 286		
GALAMBANE TS	170 27 442		

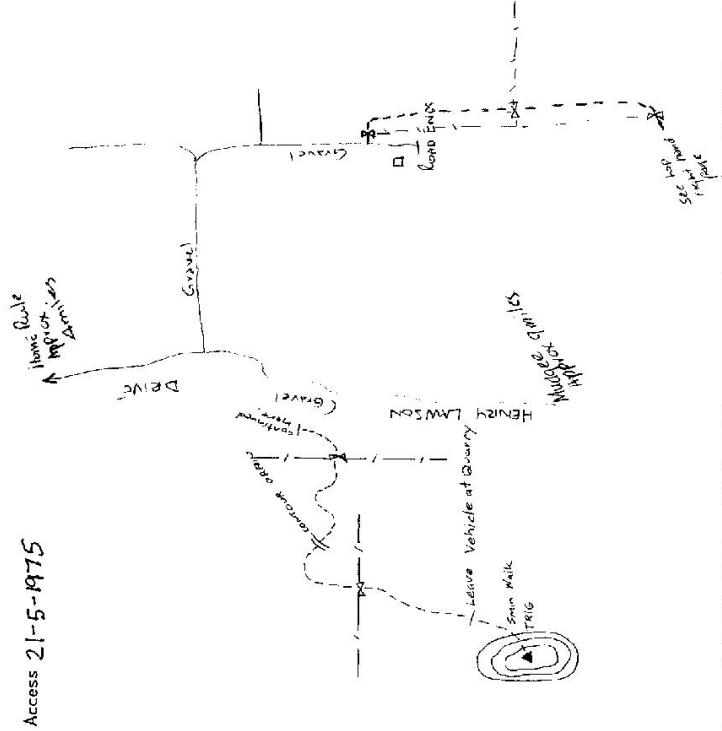

GEODETTIC SURVEY OF N.S.W.

CENTRAL MAPPING AUTHORITY

GEODETTIC STATION RECONNAISSANCE and MAINTENANCE REPORT

Description:

1. Cleared by ~~hoses~~ bearing 360° Note: Cross out word or words which do not apply
 2. Mast & Vanes have been painted white & black respectively. ✓
 3. The station/pillar was ~~unpainted~~ not unpainted/constructed on 21.3 19.7.3, dimensions now being:
 Description of mark **ST. PILLAR** should be explicit, e.g., S/Steel Pillar Plate, Steel plug, Brass plug, Bolt, G.I. Pipe
 Height of mark 3.46 m. above ~~rock~~ ^{below} ~~concrete~~; Mark is 3.71 m. ^{above} ~~below~~ G.L.
 Height of Top Vanes to Top Mark/Pillar plate 1.925 m. Diameter of Vanes (vertical) 0.747 m.
 Height of Cairn m. Diameter of Cairn m. Name Plate found/not found/placed.
 Length of Mast 1.505 m. (approximate if not unplied)
 4. A. **BRASS PLATE** set in ~~conc~~ ~~rock~~ has been ~~placed~~ found, bearing 272° m from Mast/~~Plug~~/Pillar
 5. A. **S.S.M** set in ~~conc~~ ~~rock~~ has been ~~placed~~ found, bearing 135° m from Mast/~~Plug~~/Pillar
 6. A. **S.S.M** set in ~~conc~~ ~~rock~~ has been ~~placed~~ found, bearing 106° m from Mast/~~Plug~~/Pillar
 7. A. set in ~~conc~~ ~~rock~~ has been placed/ found, bearing m from Mast/~~Plug~~/Pillar
 8. Action required:

STANDPOINT: **ROOF TOP PILLAR**

Mark	Direction	Horiz. Distance	Height Difference	Mark	Direction	Horiz. Distance	Height Difference
DERALE GS	359	59.60	above standpt.	DERALE GS	359	59.60	above standpt.
BRASS PLATE	65	55.08	below standpt.	WYALDRA (Plate)	219	32.20	below standpt.
WYALDRA (Plate)	219	31.46	below standpt.	PILLAR PLATE	245	55.25	above standpt.
S.S.M	343	54.58	below standpt.	S.S.M	318	45.60	above standpt.
			above standpt.				below standpt.
			below standpt.				above standpt.
			above standpt.				below standpt.

STANDPOINT: **BRASS TRIG. PLUG**


Mark	Direction	Horiz. Distance	Height Difference
ROOF TOP PILLAR	135	0.00	above standpt.
TRIG. PLUG	106	0.00	below standpt.
WYALDRA GS	146	0.00	above standpt.

Prepared by:

Checked:

ST 2738-1

Noted on U.T.M. Card

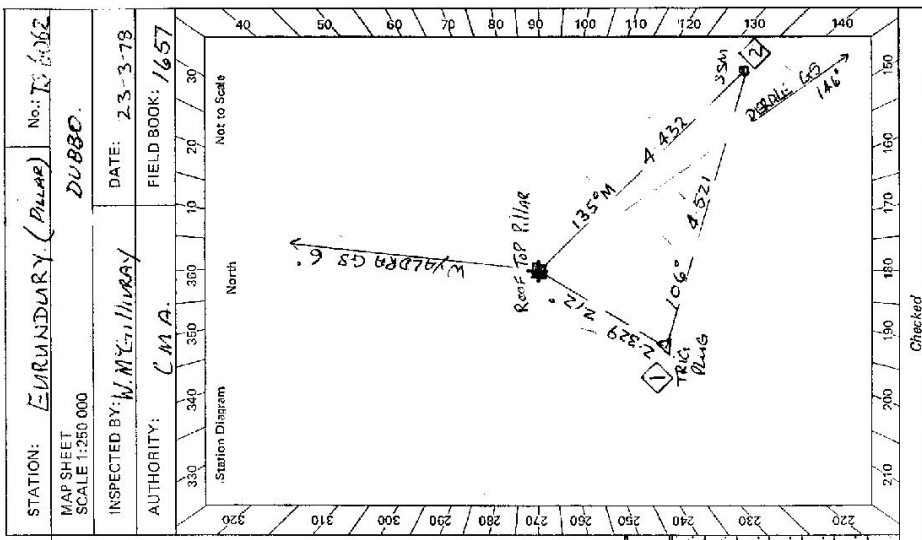

Checked

Station Diagram

North

Not to Scale

FIELD BOOK: 1657

DATE: 2-3-78

INSPECTED BY: W. McILHAY

AUTHORITY: C.M.A.

MAP SHEET SCALE 1:250 000

STATION: EMUNDARY (Pillar)

No: TS 6062


St 2733-2 D. West, Government Printer

STATION **EURANDURRY (Pillar) TS 6062**

Owner's Name:
 Address:
 Phone:

Current Occupant:
 Address:
 Phone:

Access Report of 21.05.1975 was found suitable/~~unsuitable~~.
ACCESS

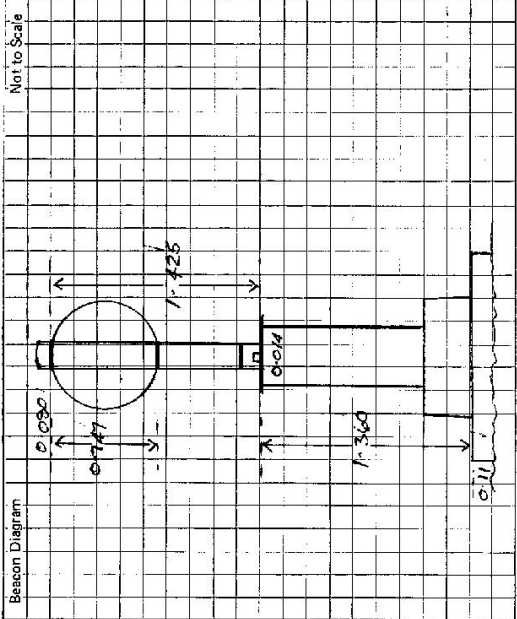

This section to be completed by officer constructing pillar.

Original station mark found/~~not found~~.
 Description of mark: **BRASS PLUG IN ROCK**
 Original beacon found/~~not found~~.
 Description of beacon: **CRACK MASS & VAINES**
 Height Top of Vanes to Top Mark: **2.000** m.
 Height of mark: **0.05** m. above rock/~~below~~ m. below G.L.
 Diameter of Vanes **0.17** m. Height of Cairn **1.00** m.
 Original Beacon has/~~has not~~ been destroyed by me.

Date	Record of Station

CENTRAL MAPPING AUTHORITY

GEODETIC SURVEY OF M.S.W.

GEODETIC STATION RECONNAISSANCE and MAINTENANCE REPORT

STATION: EURUNDURY C.S.O.P No.: 6062

- Description:
- Cleared by lanes bearing 360° ^{found} from Trig. Mast
 - Mast & Vanes have been painted white & black respectively.
 - The station/pillar was unpiled/~~not unpiled~~/~~not placed~~ on 8-2-79, dimensions now being: Description of mark. ~~Brass/Steel~~ ^{above} ~~Pillar~~ should be explicit, e.g., S/Steel Pillar Plate, Steel plug, Brass plug, Bolt, G.I. Pipe


MAP SHEET SCALE 1:250 000 DUBBO

INSPECTED BY: K. ZAHERA DATE: 8-2-79

AUTHORITY: C.M.A. FIELD BOOK: -

- Height of mark 1.360 m. ^{above} ~~mark~~ ^{concrete}; Mark is 1.371 m. ^{above} G.L.
- Height of Top Vanes to Top Mark/Pillar plate 1.425 m. Diameter of Vanes (vertical) 0.717 m.
- Height of Cairn 1.505 m. Diameter of Cairn 1.25 m. Name Plate found/~~not found~~/~~placed~~ ^{As} ~~Below~~
- Length of Mast 1.505 m. (approximate if not unpiled)
- A. ~~Brass~~ ²⁰⁵ set in ~~stone~~/~~rock~~ has been ~~placed~~/~~found~~, bearing 212° M from ~~Mast/Pillar~~ Pillar
 - A. ~~SSM~~ set in ~~stone~~/~~rock~~ has been ~~placed~~/~~found~~, bearing 35° M from ~~Mast/Pillar~~ Pillar
 - A. ~~SSM~~ set in ~~stone~~/~~rock~~ has been ~~placed~~/~~found~~, bearing 126° M from ~~Mast/Plug/Pillar~~ Pillar
 - A. set in conc/~~rock~~ has been placed/~~found~~, bearing 126° M from Mast/Plug/Pillar

Station Diagram

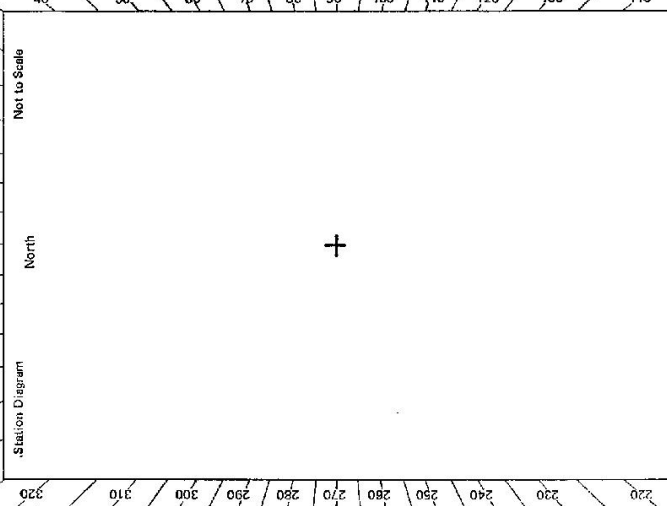

Action required: Mz

Mark	Direction	Horiz. Distance	Height Difference	Mark	Direction	Horiz. Distance	Height Difference
			above standpt.				above standpt.
			below standpt.				below standpt.
			above standpt.				above standpt.
			below standpt.				below standpt.
STANDPOINT: 6 Station 219/79

Prepared by: M. Hyman 23-2-79 Checked: 6 Station 219/79

Noted on U.T.M. Card

Checked

GEODETTIC SURVEY OF N.S.W.

CENTRAL MAPPING AUTHORITY

GEODETTIC STATION RECONNAISSANCE and MAINTENANCE REPORT


STATION: EURUNDURY No.: 6062

MAP SHEET SCALE 1:250 000 DUBBO 1:250,000

INSPECTED BY: A. WOODRUFF DATE: JUNE 1979

AUTHORITY: C.M.A. FIELD BOOK: 174Z

- Description:
- Note: Cross out word or words which do not apply*
- Cleared by lanes bearing..... from Trig. Mast
 - Mast & Vanes have been painted white & black respectively.
 - The station/pillar was unpiled/not unpiled/constructed on..... 19....., dimensions now being:
Description of mark..... should be explicit, e.g., S/Steel Pillar Plate, Steel plug, Brass plug, Bolt, G.I. Pipe
Height of mark.....m. ^{above} rock/concrete; Mark is.....m. ^{above} G.L. _{below}
 - Height of Top Vanes to Top Mark/Pillar plate.....m. Diameter of Vanes (vertical).....m.
 - Height of Cairn.....m. Diameter of Cairn.....m. Name Plate found/not found/placed.
 - Length of Mast.....m. (approximate if not unpiled)
 - A.....set in conc/rock has been placed/found, bearing.....° M from Mast/Plug/Pillar
 - A.....set in conc/rock has been placed/found, bearing.....° M from Mast/Plug/Pillar
 - A.....set in conc/rock has been placed/found, bearing.....° M from Mast/Plug/Pillar
 - A.....set in conc/rock has been placed/found, bearing.....° M from Mast/Plug/Pillar
 - Action required:.....

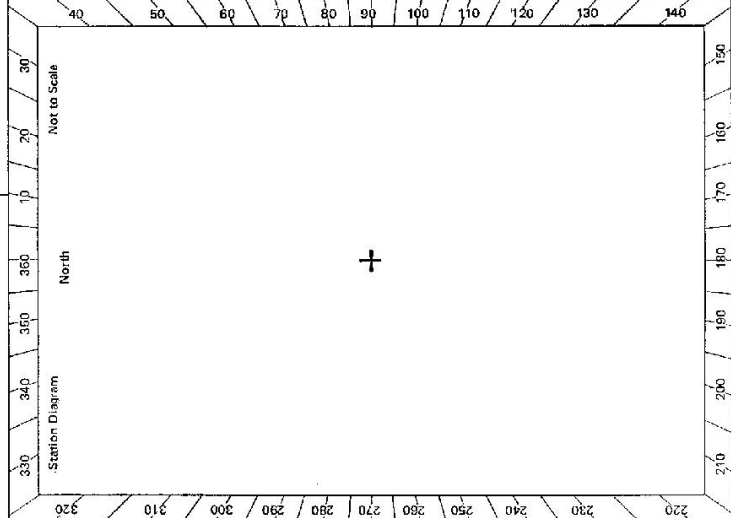


STANDPOINT:		STANDPOINT:		STANDPOINT:		STANDPOINT:	
Mark	Direction	Hor. Distance	Height Difference	Mark	Direction	Hor. Distance	Height Difference
			standpt. above				standpt. above
			standpt. below				standpt. below
			standpt. above				standpt. above
			standpt. below				standpt. below
Prepared by: P. CARR 8/2/80 Checked: Noted on U.T.M. Card

St. 2733-2 D. West, Government Printer

STATION **EURUNDURY TS 6062**

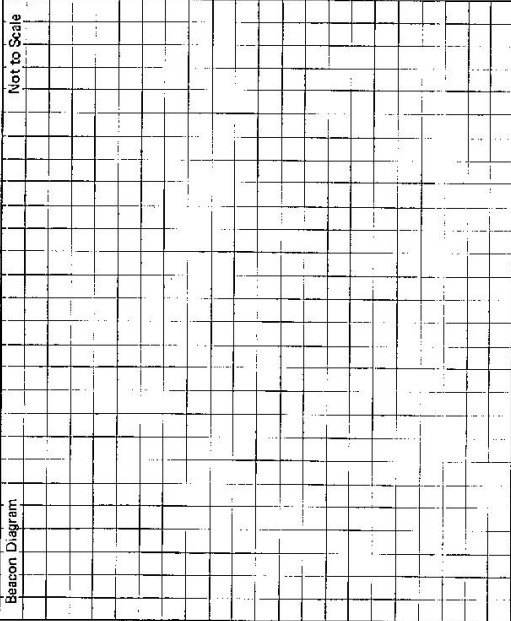

Owner's Name:
 Address:
 Phone:
 Current Occupant:
 Address:
 Phone:

June 1919
 Access Report of/19..... was found suitable/unsuitable.
ACCESS

Km
 0.0 MUDGEE PO. HEAD EAST ALONG MARKET ST.
 0.15 TURN LEFT TOWARDS CASSILLIS.
 1.9 TURN LEFT TOWARDS HOME RULE.
 3.3 TAKE RIGHT FORK. HENRY LAWSON DRIVE TOWARDS HOME RULE.
 7.3 SEE HENRY LAWSON MEMORIAL ON R.H.S.
 9.9 END OF BITUMEN.
 14.8 TURN RIGHT TOWARDS ST. FILANS.
 16.1 TURN RIGHT.
 17.1 TURN LEFT AND THEN IMMEDIATELY RIGHT THRU AT BENT GATE AT FENCE CAR FOLLOW TRACK STRAIGHT AHEAD.
 17.5 GO THROUGH GATE STRAIGHT AHEAD.
 17.8 TURN LEFT THROUGH GATE AND FOLLOW TRACK.
 18.1 TAKE RIGHT FORK. PASS BOULDER ON RIGHT.
 18.3 PASS THROUGH GATE AND FOLLOW TRACK TO RIGHT.
 18.5 STOP AT END OF TRACK. 10 min WALK WITH LEAD TO TRIG.

This section to be completed by officer constructing pillar.
 Original station mark found/not found.
 Description of mark:
 Original beacon found/not found.
 Description of beacon
 Height Top of Vanes to Top Markm.
 Height of markm. above G.L. below
 Diameter of Vanesm. Height of Cairnm.
 Original Beacon has/has not been destroyed by me.

Date	Record of Station