

CENTRAL MAPPING AUTHORITY
 GEODETIC SURVEY OF N.S.W. Batch Id: 1545
 GEODETIC STATION RECONNAISSANCE and MAINTENANCE REPORT


Description:
 1. Cleared by Janes bearing.....
 2. Mast & Vanes have been painted white & black respectively.
 3. The station/pillar was unpiled/not unpiled/constructed on.....19....., dimensions now being:

STATION: THIELE G5 (7029/1099) No.: 6067
 MAP SHEETS SCALE 1:250 000
 INSPECTED BY: G. DICKSON
 AUTHORITY: L.I.C.
 DATE:
 FIELD BOOK: 2105

Note: Cross out word or words which do not apply
 from Trig. Mast

Description of mark..... should be explicit, e.g., S/Steel Pillar Plate, Steel plug, Brass plug, Bolt, G.I. Pipe
 Height of mark.....m. above below rock/concrete; Mark is.....m. above below G.L.
 Height of Top Vanes to Top Mark/Pillar plate.....m. Diameter of Vanes (vertical).....m.
 Height of Cairn.....m. Diameter of Cairn.....m. Name Plate found/not found/placed.
 Length of Mast.....m. (approximate if not unpiled)

4. A.....set in conc/rock has been placed/found, bearing.....° M from Mast/Plug/Pillar
 5. A.....set in conc/rock has been placed/found, bearing.....° M from Mast/Plug/Pillar
 6. A.....set in conc/rock has been placed/found, bearing.....° M from Mast/Plug/Pillar
 7. A.....set in conc/rock has been placed/found, bearing.....° M from Mast/Plug/Pillar
 8. Action required:.....

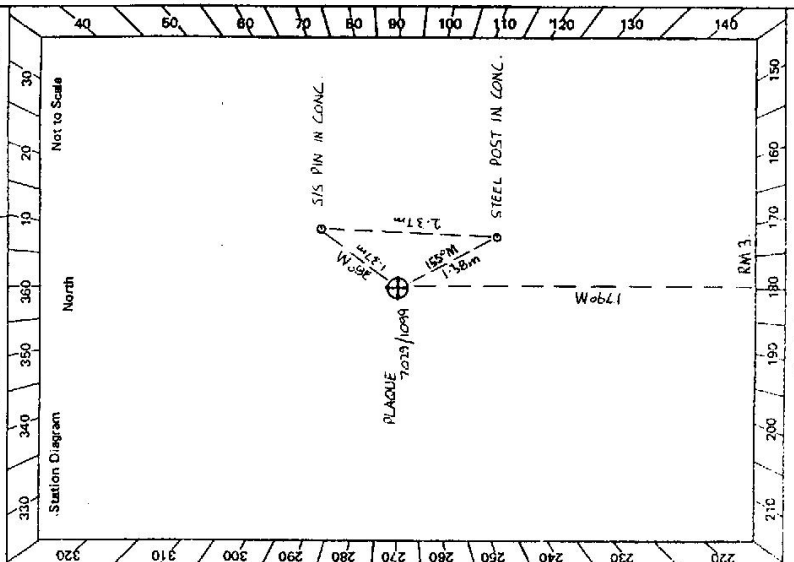

STANDPOINT:				STANDPOINT:			
Mark	Direction	Horiz. Distance	Height Difference	Mark	Direction	Horiz. Distance	Height Difference
			above standpt.				above standpt.
			below standpt.				below standpt.
			above standpt.				above standpt.
			below standpt.				below standpt.
Prepared by: G. Dickson
 Checked: C. Heath 1/2/97. g.d.
 Noted on U.T.M. Card
 Checked

