

CENTRAL MAPPING AUTHORITY

GEODETIC SURVEY OF N.S.W.

GEODETIC STATION RECONNAISSANCE and MAINTENANCE REPORT

Description:

1. Cleared by lanes bearing  $41^{\circ} 16' 31.0''$  Note: Cross out word or words which do not apply

2. Mast & Vanes have been painted white & black respectively. ✓

3. The station/pillar was ~~replaced~~ constructed on  $1918$ , dimensions now being: Description of mark  $1.359$  m. above ~~rock~~ <sup>above</sup> ~~concrete~~ <sup>above</sup> G.L. Mark is  $1.460$  m. above G.L.

Height of Top Vanes to Top Mast/Pillar plate  $1.465$  m. Diameter of Vanes (vertical)  $0.750$  m.

Height of Cairn  $0$  m. Diameter of Cairn  $0$  m. Name Plate ~~found~~/not found/placed.

Length of Mast  $0$  m. (approximate if not unpiled)

4. A ~~Brass Plug~~ set in conc/rock has been ~~placed~~/found, bearing  $214^{\circ}$  from Mast/Plug/Pillar

5. A ~~Copper Nail~~ set in conc/rock has been placed/~~found~~, bearing  $243^{\circ}$  from Mast/Plug/Pillar

6. A ~~Iron Nail~~ set in conc/rock has been placed/found, bearing  $0^{\circ}$  from Mast/Plug/Pillar

7. A ~~Iron Nail~~ set in conc/rock has been placed/found, bearing  $0^{\circ}$  from Mast/Plug/Pillar

8. Action required: ~~None~~ <sup>None</sup> ~~None~~ <sup>None</sup>


STANDPOINT: ~~Pillar Plate~~ <sup>Brass Plug</sup>

STATION: ~~None~~ <sup>Pillar</sup> No.: ~~6071~~

MAP SHEET SCALE 1:250 000

INSPECTED BY: ~~L.O. BOWEN~~ <sup>W. SINGLES</sup> DATE: ~~SIM. MAXWELL~~

AUTHORITY: ~~None~~ <sup>None</sup> FIELD BOOK: ~~None~~ <sup>None</sup>

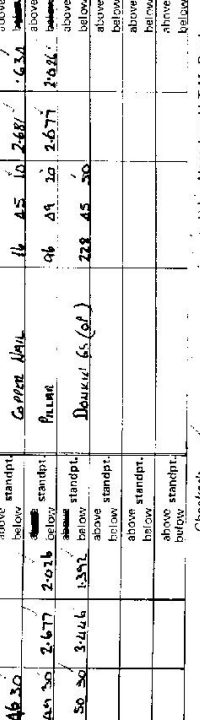

Mark	Direction	Horiz. Distance	Height Difference
IRON NAIL (P)	0 00 00		above standpt.
DOWN 41 (P)	16 45 10	2.681	above standpt.
BRASS PLUG	06 49 30	2.677	above standpt.
COPPER NAIL	228 45 30		above standpt.
			below standpt.
			below standpt.
			below standpt.
			below standpt.

Prepared by: ~~None~~ <sup>None</sup> Checked: ~~None~~ <sup>None</sup>

ST 2733-1

STATION **KUMDEE PILLAR TS 6071**

Owner's Name: .....  
 Address: .....  
 Phone: .....


Current Occupant: **Forest Commission**  
 Address: **MANAWAHEU**  
 Phone: .....

ACCESS **5th May 1978**

NY Access Report of A./S./1978. was found ~~at the site~~ **at the site**

0-00 Look East P.O. Tower with less than 100m  
 17-85 Tower Right Side Airborne II  
 18-80 BRIDGE  
 29-00 Tower Right Just past bridge at side of road  
 33-00 Tower Left (offshore side of road) **between old and new dump**  
 34-30 " " AREA LOC DUMP  
 34-40 " "  
 35-00 Past bank on left  
 36-50 Tower Right on top of bank  
 37-00 Tower Right off fire trail  
 37-60 GEOMETRIC STATION

**NOTE**  
 BETWEEN 35-00 AND 36-50 TOWER IS VERY STRONG  
 AND IN BEST VIEWED DIRECTION IS OBSERVED  
 L. & H. MARKS  
 RADIUS CHECKED

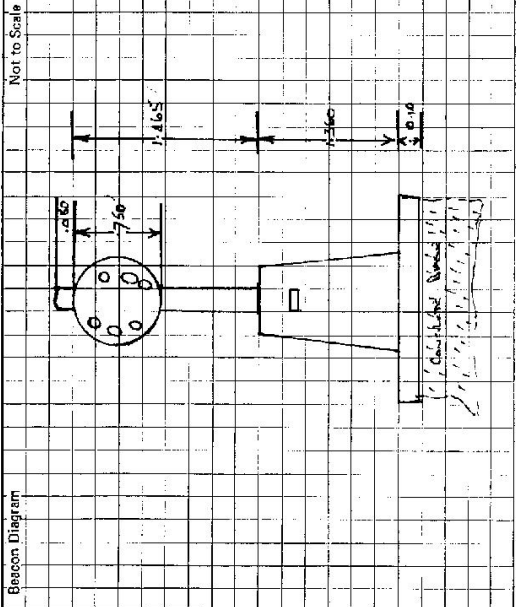

This section to be completed by officer constructing pillar.

Original station mark found/~~not found~~.

Description of mark: **Between 34-30 and 36-50** ~~height~~ **height** .....

Original beacon found/~~not found~~.

Description of reason: **Crushed** ~~None~~ **None** .....

Height Top of Vanes to Top Mark **2.95** .....

Height of mark **1.4** m. above ~~rock~~ **rock** ~~conc~~ **conc** ~~500~~ **500** m. below ~~above~~ **O.L.**

Diameter of Vanes **0.76** m. Height of Cairn **1.30** m.

Original Beacon has ~~been~~ **been** destroyed by me.

Date	Record of Station