

GEODETTIC SURVEY OF M.S.W.

CENTRAL MAPPING AUTHORITY

GEODETTIC STATION RECONNAISSANCE and MAINTENANCE REPORT

Description: *Note: Cross out word or words which do not apply*

1. Cleared by lanes bearing 315 to 316 *Note: Cross out word or words which do not apply* from Trig, Mast
2. Mast & Vanes have been painted white & black respectively. ✓
3. The ~~station~~/pillar was ~~replaced~~/~~re-constructed~~/constructed on CONCRETE 1978, dimensions now being: Description of mark CONCRETE PILLAR should be explicit, e.g. S/Steel Pillar Plate, Steel plug, Brass plug, Bolt, G.I. Pipe
Height of mark 1.445 m. ^{above} ~~below~~ CONCRETE G.L.
Height of Top Vanes to Top ~~Mark~~/Pillar plate 1.425 m. Diameter of Vanes (vertical) 75 mm.
Height of Cairn 0 m. Diameter of Cairn 0 m. Name Plate ~~found~~/not ~~found~~/placed.
Length of Mast 0 m. (approximate if not unpiled)
4. A BRASS MARK set in conc/~~rock~~ has been ~~placed~~/found, bearing 97 ° M from Mast/Plug/Pillar
5. A CONCRETE MARK set in conc/~~rock~~ has been placed/~~found~~, bearing 55 ° M from Mast/Plug/Pillar
6. A CONCRETE MARK set in conc/~~rock~~ has been placed/~~found~~, bearing 145 ° M from Mast/Plug/Pillar
7. A CONCRETE MARK set in conc/~~rock~~ has been placed/~~found~~, bearing 171 ° M from Mast/Plug/Pillar
8. Action required: None


STANDPOINT: <u>BRASS</u>		STANDPOINT: <u>BRASS</u>		STANDPOINT: <u>BRASS</u>	
Mark	Direction	Horiz. Distance	Height Difference	Mark	Direction
<u>CONCRETE GS (OL)</u>	<u>0 00 00</u>		<u>above</u> <u>standpt.</u>	<u>CONCRETE GS (OL)</u>	<u>0 00 00</u>
<u>BRASS PUG</u>	<u>41 51 50</u>	<u>3.924</u>	<u>below</u> <u>standpt.</u>	<u>BRASS GS (OL)</u>	<u>44 46 40</u>
<u>BRASS GS (OL)</u>	<u>44 46 40</u>	<u>1.757</u>	<u>above</u> <u>standpt.</u>	<u>PILLAR</u>	<u>21 50 40</u>
<u>CONCRETE PILLAR</u>	<u>358 14 40</u>	<u>3.944</u>	<u>below</u> <u>standpt.</u>	<u>CONCRETE PILLAR</u>	<u>241 40 40</u>
			<u>below</u> <u>standpt.</u>		
			<u>above</u> <u>standpt.</u>		
			<u>below</u> <u>standpt.</u>		
			<u>above</u> <u>standpt.</u>		
			<u>below</u> <u>standpt.</u>		

Prepared by: U.T.M. Cart

Checked:

Checked:

SI 2733-1

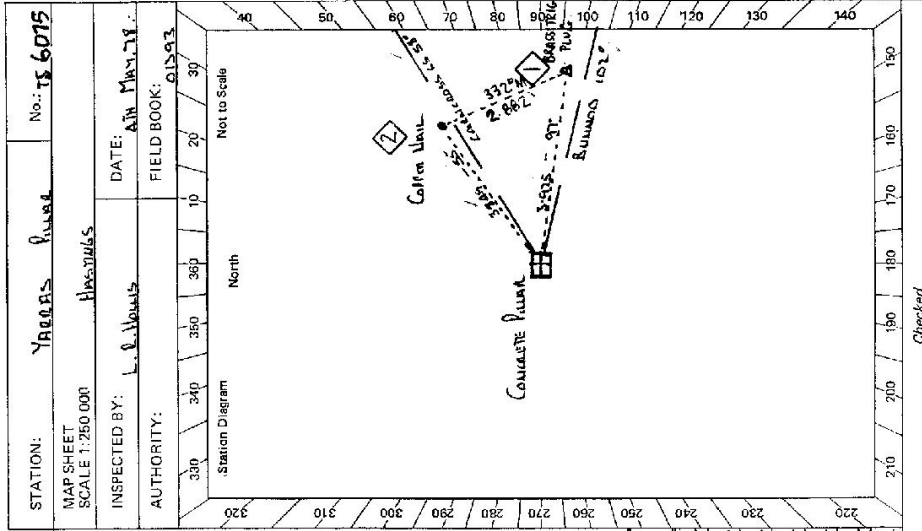

Checked

STATION: YARRAS BRASS No: TS 6075

MAP SHEET SCALE 1:250,000

INSPECTED BY: L. R. HOLLIS DATE: 21st May 2022

AUTHORITY: L. R. HOLLIS FIELD BOOK: 01293

ST 2735-2 D. Vents, Government Printer Beacon Diagram Not to Scale 	STATION 18315 18315 TS 6075 Owner's Name: DR. R. L. BARNES Address: Phone: Current Occupant: Address: Phone: ACCESS NY Access Report of 4.7.5/19.77 was found - see below Louis F. Post P.O. Terminal Miss. Road, Oyster Hill, NY 0-00 17-30 18-85 14-70 20-90 14-00 24-70 24-35 24-40 25-25 25-30 25-60 GEOMETRY SPREADSHEET	This section to be completed by officer constructing pillar. Original station mark found/..... Description of mark: BRASS WAS SET IN CONCRETE WALL Original beacon found/..... Description of beacon: CONC. PILLAR WITH VANS Height Top of Vans to Top Mark: 3.81 m. Height of mark: 0.38 m. above rock/conc. 5.00 m. below G.L. Diameter of Vans: 0.600 m. Height of Calm: 1.50 m. Original Beacon has/..... been destroyed by me.
		Date Record of Station