


STATION **BALD (P) T.S. 6115**


Owners Name.....
 Current Occupant.....
 Address.....
 Address.....

Access **25-10-77**

0.00 KM WAGGA RD. DENIE WORTH FITZMAURICE SET
 0.60 TURN RIGHT OVER MURRUMBIDGEE RIVER
 1.50 TURN RIGHT INTO WALL STREET
 4.50 TURN RIGHT INTO BOODOMA STREET
 PROCEED AS SKETCHED

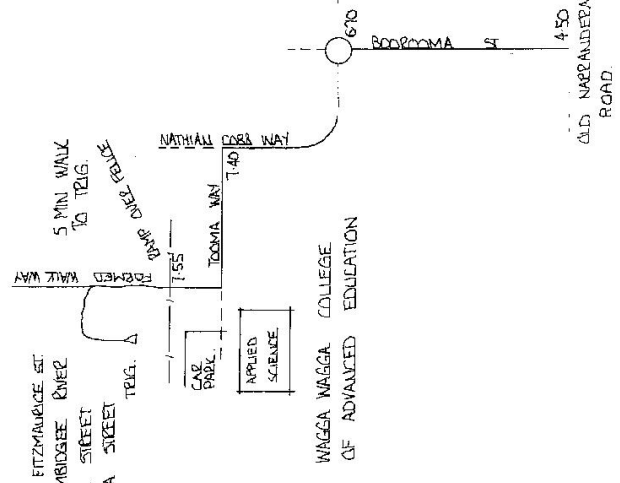

Station Diagram Not to Scale

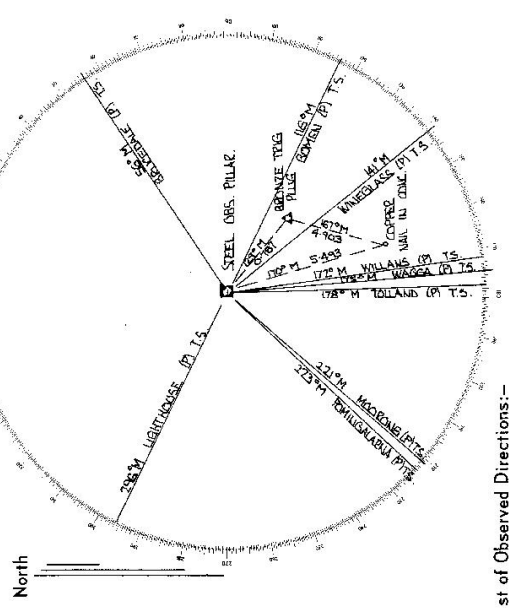

List of Observed Directions:-

Standpoint: STEEL OBS. PILLAR		Standpoint: BRONZE TEL. PILLAR	
Station	Direction	Station	Direction
LIGHTHOUSE (P) T.S.	02° 02' 00"	LIGHTHOUSE (P) T.S.	02° 02' 00"
BRONZE TEL. PILLAR	25° 24' 31"	STEEL OBS. PILLAR	25° 24' 31"
WILLIAMS (P) T.S.	235° 41' 36"	WILLIAMS (P) T.S.	235° 41' 36"
COPPER MAIL	243° 01' 30"	COPPER MAIL	243° 01' 30"
Station	Direction	Station	Direction

GEODETIC SURVEY OF NSW

CENTRAL MAPPING AUTHORITY

GEODETIC STATION RECONNAISSANCE and MAINTENANCE REPORT


STATION: BALD G.S. No: 6115

MAP SHEET SCALE 1:250 000 WAGGA WAGGA

INSPECTED BY: H.C. BORDER DATE: 9th June 1978

AUTHORITY: C.M.A. FIELD BOOK: 1539

- Description: *Note: Cross out word or words which do not apply to specific local stations only.*
- Cleared by lanes bearing.....to specific local stations only..... from Trig. Mast
 - Mast & Vanes have been painted white & black respectively.
 - The station/pillar was unpiled/~~not unpiled~~/~~constructed~~ on.....19....., dimensions now being: Description of mark. ~~Brass Plug~~.....should be explicit, e.g., S/Steel Pillar Plate, Steel plug, Brass plug, Bolt, G.I. Pipe Height of mark.....m. ^{above} rock/concrete; Mark is.....m. ^{above} G.L. Diameter of Vanes (vertical).....m. Height of Top Vanes to Top Mark/Pillar plate.....m. Diameter of Vanes (vertical).....m. Height of Cairn.....m. Diameter of Cairn.....m. Name Plate ~~found~~/~~not found~~/~~steel~~. Length of Mast.....m. (approximate if not unpiled)
 - A.....Copper Nail (1).....set in conc/~~rock~~ has been ~~placed~~/~~found~~, bearing...16.6...°M from ~~Mast~~/~~Plug~~/~~Pillar~~
 - A Steel Obs Pillar (Dept of Lands) set in conc/~~rock~~ has been ~~placed~~/~~found~~, bearing...30.0...°M from ~~Mast~~/~~Plug~~/~~Pillar~~
 - A.....Copper Nail (2).....set in conc/~~rock~~ has been placed/~~found~~, bearing...34.5...°M from ~~Mast~~/~~Plug~~/~~Pillar~~
 - A.....G.I. Pipe.....set in ~~conc~~/~~rock~~ has been placed/~~found~~, bearing...76...°M from ~~Mast~~/~~Plug~~/~~Pillar~~
 - Action required:.....

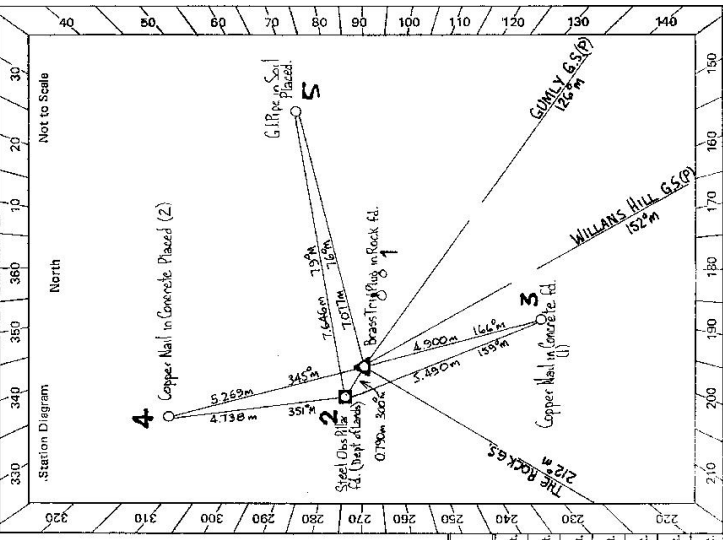

Mark	Direction	Horiz. Distance	Height Difference	Mark	Direction	Horiz. Distance	Height Difference
WILLIAMS HILL G.S. (P)	0 00 00		above standpt.	WILLIAMS HILL G.S. (P)	0 00 00		above standpt.
Copper Nail in Conc (1)	13 55 20	4.900	1.342 above standpt.	Copper Nail in Conc (1)	8 11 40	5.490	2.739 below standpt.
THE ROCKS G.S.	53 57 20		above standpt.	Copper Nail in Conc (2)	200 33 30	4.738	2.964 below standpt.
Steel Obs Pillar (Dept of Lands)	49 31 -	0.790	1.397 above standpt.	G.I. Pipe in seal placed	5 28 08 20	7.646	2.938 below standpt.
Copper Nail in Conc (2)	193 54 30	5.269	1.566 above standpt.	Brass Trig Plug in	329 31 20	0.790	1.397 below standpt.
G.I. Pipe in Seal Placed	5 28 55 40	7.077	1.540 above standpt.	GUMLY G.S. (P)	334 47 30		above standpt.
GUMLY G.S. (P)	334 47 20		below.				below.

STANDPOINT: Steel Obs Pillar (Dept of Lands) (1) Z

STANDPOINT: Brass Trig Plug (1)

Prepared by: 16 JUNE 1978

Checked:

Noted on U.T.M. Card

St 2733-2 D. West, Government Printer Beacon Diagram	Not to Scale 	STATION BALD G.S. *6115 Owner's Name: RIVERINA COLLEGE OF ADVANCED EDUCATION Address: Phone: Current Occupant: Address: Phone: Access Report of 25/12/1977 was found suitable/ unsuitable . ACCESS	
This section to be completed by officer constructing pillar. Original station mark found/ not found . Description of mark: Brass Plug in Rock Original beacon found/not found. Description of beacon: Height Top of Vanes to Top Mark.....m. Height of mark.....m. above rock/conc.....m. below G.L. Diameter of Vanes.....m. Height of Cairn.....m. Original Beacon has/has not been destroyed by me.		Date Record of Station	

GEODETIC SURVEY OF N.S.W.

CENTRAL MAPPING AUTHORITY


GEODETIC STATION RECONNAISSANCE and MAINTENANCE REPORT

STATION: **BALD G.S. (P)** No.: **6115**

MAP SHEET: **WAGGA WAGGA**

INSPECTED BY: **G. JONES** DATE: **15th JUNE 1978**

AUTHORITY: **C.M.A.** FIELD BOOK: **1539**

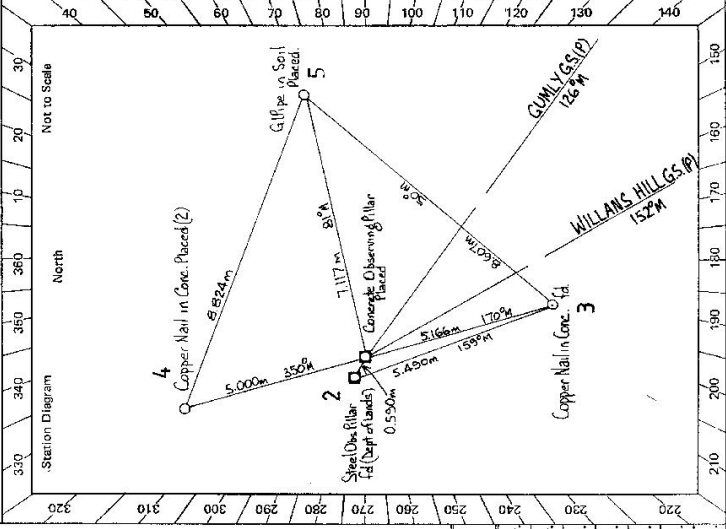

- Description: *Note: Cross out word or words which do not apply*
- Cleared by lanes bearing.....*to specific localities*..... from Trig. Mast
 - Mast & Vanes have been painted white & black respectively. ✓
 - The station/pillar was ~~erected~~ constructed on..... **15th JUNE 1978**, dimensions now being:
Description of mark: ~~Steel Pillar~~ **Steel Pillar Plate, Steel plug, Brass plug, Bolt, G.I. Pipe**
Height of mark..... **3.38** m. ^{above} ~~below~~ **concrete**/~~concrete~~; Mark is **2.1/3** m. ^{above} ~~below~~ **G.L.**
Height of Top Vanes to Top ~~Mark~~ **Pillar plate** **1.405** m. Diameter of Vanes (vertical) **0.755** m.
Height of Cairn..... m. Diameter of Cairn..... m. Name Plate ~~found/not found~~ **placed**, **15th JUNE 1978**
Length of Mast..... **4.95** m. (approximate if not unipled)
 - A ~~Copper Nail~~ (1)..... set in conc/~~rock~~ has been ~~placed~~ **found**, bearing **170**° M from ~~Mast/Pillar~~ **Pillar**
 - A ~~Steel Obs Pillar~~ (2)..... set in conc/~~rock~~ has been ~~placed~~ **found**, bearing **300**° M from ~~Mast/Pillar~~ **Pillar**
 - A ~~Copper Nail~~ (2)..... set in conc/~~rock~~ has been ~~placed~~ **found**, bearing **350**° M from ~~Mast/Pillar~~ **Pillar**
 - A ~~G.I. Pipe~~..... set in ~~concrete~~ **found**, bearing **81**° M from ~~Mast/Pillar~~ **Pillar**
 - Action required:.....

STANDPOINT: CONCRETE OBS. PILLAR				STANDPOINT: COPPER NAIL IN CONC. (P) 3			
Mark	Direction	Horiz. Distance	Height Difference	Mark	Direction	Horiz. Distance	Height Difference
WILLIAMS HILL G.S. (P)	0 00 00		above standpt.	WILLIAMS HILL G.S. (P)	0 00 00		above standpt.
Copper Nail in Conc. (1) 3	13 30 00	5.166	2.976 below standpt.	Steel Obs Pillar (Depth of base)	188 09 20	5.450	2.757 above standpt.
Copper Nail in Conc. (2) 4	194 20 40	5.000	3.203 below standpt.	Conc. Obs Pillar	0 193 30 20	5.166	2.976 above standpt.
G.I. Pipe in Soil Placed 5	286 04 40	7.117	3.176 below standpt.	G.I. Pipe in Soil Placed 5	249 13 20	8.607	0.200 below standpt.
GUMMLY G.S. (P)	334 47 20		above standpt.	GUMMLY G.S. (P)	334 47 20		above standpt.
			below				below


Prepared by: *[Signature]* 16th JUNE 1978 Checked: *[Signature]* Noted on U.T.M. Card

Sr 2733 - 2 D. West. Government Printer

STATION **BALD G.S. (P)** * **6115**

Owner's Name: **RIVERINA COLLEGE OF ADVANCED EDUCATION**
 Address:
 Phone:
 Current Occupant:
 Address:
 Phone:

Access Report of **25/10/1977** was found suitable/~~unsuitable~~. **ACCESS**

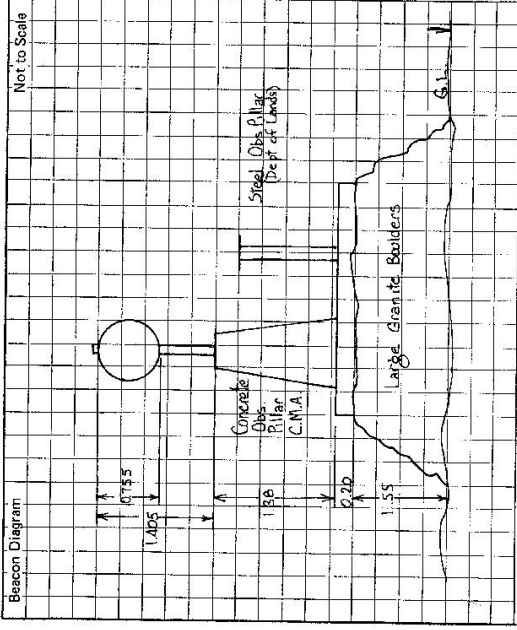

This section to be completed by officer constructing pillar.

Original station mark found/~~not found~~.

Description of mark: **Brass Peg in Rock**

Original beacon found/not found.

Description of beacon:

Height Top of Vanes to Top Mark:m.

Height of mark:m. above rock/conc. below G.L.

Diameter of Vanesm. Height of Cairnm.

Original Beacon has/has not been destroyed by me.

Date	Record of Station

CENTRAL MAPPING AUTHORITY

GEODETIC SURVEY OF N.S.W.

GEODETIC STATION RECONNAISSANCE and MAINTENANCE REPORT

Description: *Note: Cross out word or words which do not apply*

1. Cleared by lances bearing..... from Trig. Mast
2. Mast & Vanes have been painted white & black respectively. ✓
3. The station/pillar was unpiled/not unpiled/constructed on..... dimensions now being:
 - Description of mark..... should be explicit, e.g., S/Steel Pillar Plate, Steel plug, Brass plug, Bolt, G.I. Pipe
 - Height of mark.....m. ^{above} rock/concrete; Mark is.....m. ^{above} G.L.
 - Height of Top Vanes to Top Mark/Pillar plate.....m. Diameter of Vanes (vertical).....m.
 - Height of Cairn.....m. Diameter of Cairn.....m. Name Plate found/not found/placed.
 - Length of Mast.....m. (approximate if not unpiled)
4. A..... set in conc/rock has been placed/found, bearing.....° M from Mast/Plug/Pillar
5. A..... set in conc/rock has been placed/found, bearing.....° M from Mast/Plug/Pillar
6. A..... set in conc/rock has been placed/found, bearing.....° M from Mast/Plug/Pillar
7. A..... set in conc/rock has been placed/found, bearing.....° M from Mast/Plug/Pillar
8. Action required:.....

STANDPOINT:

Mark	Direction	Horiz. Distance	Height Difference	Mark	Direction	Horiz. Distance	Height Difference
			above standpt. below				above standpt. below
			above standpt. below				above standpt. below
Prepared by: *P. Taylor* 17.11.78

Checked:

Noted on U.T.M. Card

S: 2753-1

STATION: *BALD (P)* No: *6115*

MAP SHEET SCALE 1:250 000 *WALGA WAGGA*

INSPECTED BY: *P. NAVLOR* DATE: *17.11.78*

AUTHORITY: *C.M.A.* FIELD BOOK: *1592*

Station Diagram

North

Not to Scale

ROOF TOP PILLAR PLACED BY WALGA WAGGA L.B.O STAFF HAS BEEN REMOVED. SSM 23254 HAS BEEN PLACED, PRESUMABLY CONCENTRIC TO THE POSITION OF THE ROOF TOP PILLAR.

+ PILLAR, MAST & VANES HAVE BEEN MAINTAINED

Checked

CENTRAL MAPPING AUTHORITY

GEODETIC SURVEY OF N.S.W.
 GEODETIC STATION RECONNAISSANCE and MAINTENANCE REPORT

STATION: BALD G.S. No.: 6115


MAP SHEET Waagga Waagga

SCALE 1:250 000

INSPECTED BY: CMA

DATE: 1978

AUTHORITY: FIELD BOOK:

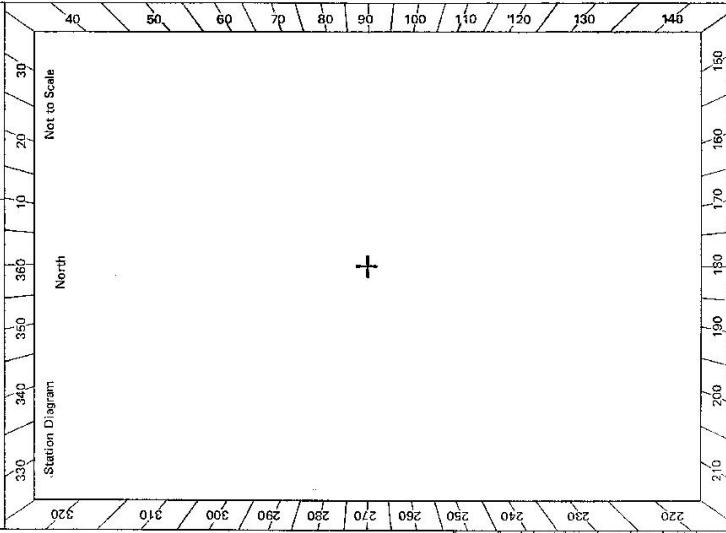

- Description:
- Note: Cross out word or words which do not apply*
- Cleared by lanes bearing..... from Trig. Mast
 - Mast & Vanes have been painted white & black respectively.
 - The station/pillar was unpiled/not unpiled/constructed on..... 19....., dimensions now being:
 Description of mark..... should be explicit, e.g., S/Steel Pillar Plate, Steel plug, Brass plug, Bolt, G.I. Pipe
 Height of mark.....m. ^{above} rock/concrete; Mark ism. ^{above} G.L.
 Height of Top Vanes to Top Mark/Pillar platem. Diameter of Vanes (vertical).....m.
 Height of Cairn.....m. Diameter of Cairn.....m. Name Plate found/not found/placed.
 Length of Mast.....m. (approximate if not unpiled)
 - A..... set in conc/rock has been placed/found, bearing.....°M from Mast/Plug/Pillar
 - A..... set in conc/rock has been placed/found, bearing.....°M from Mast/Plug/Pillar
 - A..... set in conc/rock has been placed/found, bearing.....°M from Mast/Plug/Pillar
 - A..... set in conc/rock has been placed/found, bearing.....°M from Mast/Plug/Pillar
 - Action required:.....

STANDPOINT:			
Mark	Direction	Horiz. Distance	Height Difference
			above standpt.
			below
			above standpt.
			below
Prepared by: Checked: Noted on U.T.M. Card


6115

STATION BALD G.S.

64 2733-2 D. West, Government Printer

Beacon Diagram

Not to Scale

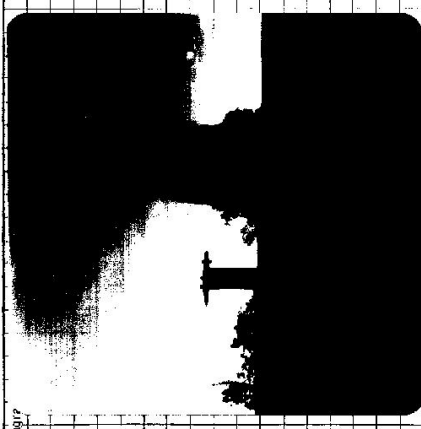

Written on back of photo:
 BALD G.S. Kiosk Beacon placed by Major 1880
 concrete pillar placed by CMA 1910
 as per Enquiry

Owner's Name:
 Address:
 Phone:

Current Occupant:
 Address:
 Phone:

ACCESS
 Access Report of...../19.....was found suitable/unsuitable.

This section to be completed by officer constructing pillar.

Original station mark found/not found.

Description of mark:

Original beacon found/not found.

Description of beacon:

Height Top of Vanes to Top Mark.....m.

Height of mark:.....m. above G.L.
 below rock/conc.....m. below G.L.

Diameter of Vanes.....m. Height of Cairn.....m.

Original Beacon has/has not been destroyed by me.

Date	Record of Station