

CENTRAL MAPPING AUTHORITY

Trigonometrical Survey of N.S.W.

Department of Lands

RECONNAISSANCE and MAINTENANCE REPORT

This Trig. Station has been:-

Note: Cross out word or words which do not apply

1. Completely cleared to permit 360° vision to surrounding Trig.
 2. Cleared by lanes bearing 71° BEARED 360° from Trig. Mast
 3. Trig. Mast & Vanes have been painted white & black respectively. ✓
 4. The Trig. was ~~repacked~~/not unpiled, dimensions now being: _____ should be explicit, e.g. Steel plug, Brass plug, Bolt, G.I. Pipe
- Description of mark _____
- Height of mark _____ m above rock/concrete _____ m above G.L.
- Height of Top Vanes to Top Mark _____ m. Diameter of Vanes (vertical) 1.00 m.
- Height of Cairn 1.50 m. Diameter of Cairn (1.00) 70 mm.
- Length of Mast 3.54 m. (approximate if not unpiled)

5. A _____ set in conc/rock has been placed _____ m. bearing _____ °M from Trig. Mast
6. A _____ set in conc/soil has been placed _____ m. bearing _____ °M from Trig. Mast
7. A _____ set in conc/soil has been placed _____ m. bearing _____ °M from Trig. Mast
8. A _____ set in conc/rock has been placed _____ m. bearing _____ °M from Trig. Mast
9. Connection _____ to _____ m. bearing _____ °M
10. Connection _____ to _____ m. bearing _____ °M
11. Connection _____ to _____ m. bearing _____ °M
12. Connection _____ to _____ m. bearing _____ °M
13. Diff. Ht. _____ is _____ m. above below
14. Diff. Ht. _____ is _____ m. above below
15. Diff. Ht. _____ is _____ m. above below
16. Diff. Ht. _____ is _____ m. above below

Prepared by: _____ Checked: _____

Noted on U.T.M. Card

STATION ALKIRA 613

Co: HAWES Ph: WARD


Map Sheet: UPPER MANNING No: 923A

Inspected by: M.L. Morrison Date: 12/1/77

Authority _____ Field Book: 1580

Beacon Diagram

Not to Scale

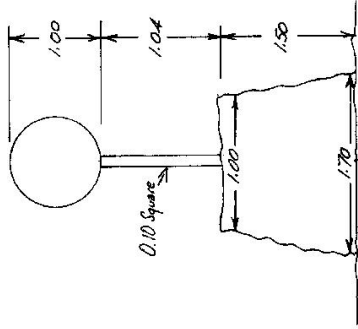

Date _____ Record of Station _____

Appear 1/2 days clearing required for 360° view
55.M in conc for Trig in good order

Checked

