

CENTRAL MAPPING AUTHORITY

GEODETTIC SURVEY OF N.S.W. GEODETTIC STATION RECONNAISSANCE and MAINTENANCE REPORT

Description:

- Cleared by lances bearing $20.70.60$ to $102.6.125$ from Trig. Mast
 Note: Cross out word or words which do not apply
- Mast & Vanes have been painted white & black respectively. ✓
- The station/pillar was ~~re-erected~~ constructed on $19.7.8$, dimensions now being: $19.7.8$, $19.7.8$, $19.7.8$
- Description of marks: $S.S.M.$ should be explicit, e.g., S/Steel Pillar Plate, Steel plug, Brass plug, Bolt, G.I. Pipe
- Height of mark 1.370 m. above rock/concrete; Mark is 1.370 m. above below G.L.
- Height of Top Vanes to Top Mark/Pillar plate 4.430 m. Diameter of Vanes (vertical) 2.55 m.
- Height of Cairn 0.00 m. Diameter of Cairn 0.00 m. Name Plate ~~found~~/not found/placed.
- Length of Mast 0.00 m. (approximate if not unipiled)
- A. ~~Revised~~ $19.7.8$ set in conc/rock has been ~~placed~~/found, bearing 52.0 M from ~~Mark/Plug~~/Pillar
- A. $G.I.$ set in conc/rock has been ~~placed~~/found, bearing 234.0 M from ~~Mark/Plug~~/Pillar
- A. $S.S.M.$ set in conc/rock has been ~~placed~~/found, bearing 85.0 M from ~~Mark/Plug~~/Pillar
- A. 0.00 set in conc/rock has been placed/found, bearing 0.0 M from Mast/Plug/Pillar
- Action required: ~~None~~ $19.7.8$ $S.S.M.$ $G.I.$ $19.7.8$

STANDPOINT: PILLAR PLATE

Mark	Direction	Horiz. Distance	Height Difference	Mark	Direction	Horiz. Distance	Height Difference
Concrete Pillar	$0 00 00$		above standpt	Concrete Pillar	$0 00 00$		above standpt
Blowze Trig. Plate	$45 47 10$	2.976	below standpt	Blowze Trig. Plate	$56 45 10$		below standpt
Blowze Pillar	$56 44 35$		below standpt	G.I. Pipe	$203 00 45$	3.714	above standpt
G.I. Pipe	$151 16 15$	1.557	below standpt	Pillar Plate	$225 50 74$	2.474	above standpt
S.S.M.	$357 54 40$	2.405	below standpt	S.S.M.	$272 51 20$	3.044	above standpt
			below standpt				below standpt

STANDPOINT: BLOWZE TRIG. PLATE

Mark	Direction	Horiz. Distance	Height Difference	Mark	Direction	Horiz. Distance	Height Difference
Concrete Pillar	$0 00 00$		above standpt	Concrete Pillar	$0 00 00$		above standpt
Blowze Trig. Plate	$45 47 10$	2.976	below standpt	Blowze Trig. Plate	$56 45 10$		below standpt
Blowze Pillar	$56 44 35$		below standpt	G.I. Pipe	$203 00 45$	3.714	above standpt
G.I. Pipe	$151 16 15$	1.557	below standpt	Pillar Plate	$225 50 74$	2.474	above standpt
S.S.M.	$357 54 40$	2.405	below standpt	S.S.M.	$272 51 20$	3.044	above standpt
			below standpt				below standpt

Prepared by:


Checked:

STATION: Blowze Trig. Plate No.: 6142

MAP SHEET: 1:250 000

INSPECTED BY: L.P. Hobbs DATE: 18th May 18

AUTHORITY: 1:250 000 FIELD BOOK: 6142

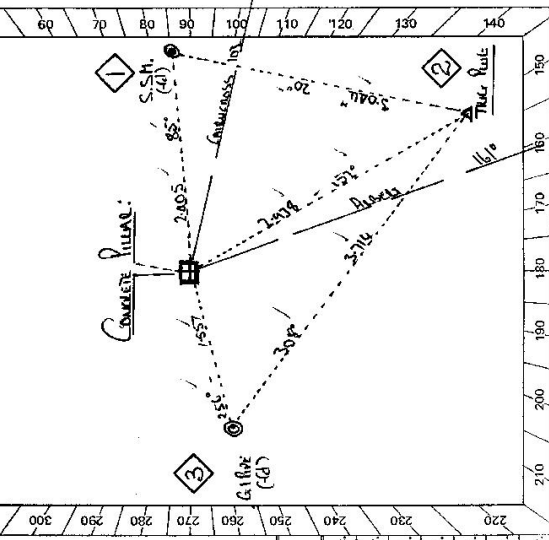

Checked

STATION BELLANGER 6142

Owner's Name: TRANSITION CONSULTANTS
 Address: Whitwell
 Phone:

Current Occupant:

Address:

Phone:

ACCESS

Access Report of 26/5/1978 was found suitable/unsuitable.
BUCKLE HOLLOW D.O. TOWER TO BE MARKED UNRECOVERABLE
TOWARD LEFT SIDE BELLANGER STATE FOREST, BUSHY ROAD BELLANGER
AREA SAMMILL ON LEFT
END OF SECTION 21
AREA 21 LOCATED IN BUSHY ROAD
FOREST CAMP
IN THE CORNER OF 21 AND 21.5
TOWARD RIGHT
GRADIENT STATION 1

111
 0.00
 0.70
 14.00
 16.70
 20.20
 21.10
 28.30
 36.40
 37.30

Beacon Diagram Not to Scale

This section to be completed by officer constructing pillar.

Original station mark found/ ~~not found~~

Description of mark: Concrete Pillar 0.90m

Original beacon found/ ~~not found~~

Description of beacon: Concrete Pillar 0.90m

Height Top of Vanes to Top Mark: 5.620 m.

Height of mark: 0.500 m. above G.L. / below G.L.

Diameter of Vanes: m. Height of Cairn: 1.230 m.

Original Beacon has/ ~~has not~~ been destroyed by me.

Date	Record of Station

GEODETTIC SURVEY OF NSW

CENTRAL MAPPING AUTHORITY


GEODETTIC STATION RECONNAISSANCE and MAINTENANCE REPORT

STATION: BELLANGRY G.S.S. No.: 6142

MAP SHEET SCALE 1:250 000 Hastings

INSPECTED BY: CMA DATE: 1978

AUTHORITY: FIELD BOOK:

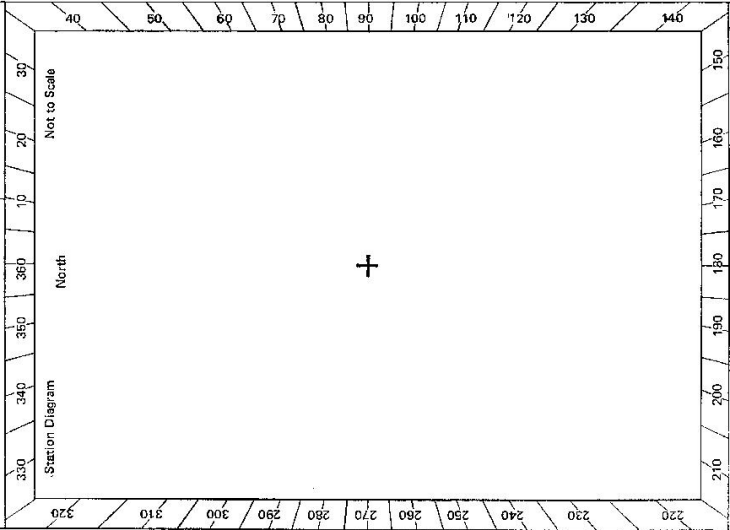

- Description:
- Note: Cross out word or words which do not apply
- Cleared by lanes bearing..... from Trig, Mast
 - Mast & Vanes have been painted white & black respectively.
 - The station/pillar was unpiled/hot unpiled/constructed on.....19....., dimensions now being:
Description of mark.....should be explicit, e.g., S/Steel Pillar Plate, Steel plug, Brass plug, Bolt, G.I. Pipe
Height of mark.....m. ^{above} _{below} rock/concrete; Mark is.....m. ^{above} _{below} G.L.
Height of Top Vanes to Top Mark/Pillar platem. Diameter of Vanes (vertical).....m.
Height of Cairn.....m. Diameter of Cairn.....m. Name Plate found/not found/placed.
Length of Mast.....m. (approximate if not unpiled)
 - A.....set in conc/rock has been placed/found, bearing.....°M from Mast/Plug/Pillar
 - A.....set in conc/rock has been placed/found, bearing.....°M from Mast/Plug/Pillar
 - A.....set in conc/rock has been placed/found, bearing.....°M from Mast/Plug/Pillar
 - A.....set in conc/rock has been placed/found, bearing.....°M from Mast/Plug/Pillar
 - Action required:.....

STANDPOINT:

Mark	Direction	Horiz. Distance	Height Difference	Mark	Direction	Horiz. Distance	Height Difference
			above standpt.				above standpt.
			below standpt.				below standpt.
			above standpt.				above standpt.
			below standpt.				below standpt.
Prepared by: Checked:
Noted on U.T.M. Card

Rt 2733-2 D. West, Government Printer

<p>Beacon Diagram</p> <div style="text-align: center;"> <p style="text-align: right; font-size: small;">Not to Scale</p> </div>	<div style="text-align: right; border: 1px solid black; padding: 2px; margin-bottom: 10px;"> STATION BULLHERRY G.S.S. 6142 </div> <p> Owner's Name: Address: Phone: Access Report of/...../1972 was found suitable/unsuitable. </p> <p> Current Occupant: Address: Phone: ACCESS </p>
This section to be completed by officer constructing pillar. Original station mark found/not found.	
Description of mark: Original beacon found/not found.	
Description of beacon: Height Top of Vanes to Top Markm. Height of mark:m. above below G.L. Diameter of Vanesm. Height of Calmm. Original Beacon has/has not been destroyed by me.	
Date	Record of Station