


CENTRAL MAPPING AUTHORITY
 GEODETIC SURVEY OF M.S.W.
 GEODETIC STATION RECONNAISSANCE and MAINTENANCE REPORT

STATION: Sonwen No: TS 6150
 MAP SHEET SCALE 1:250 000
 INSPECTED BY: L.R. HARRIS DATE: 5.12.1987
 AUTHORITY: C.M.A. FIELD BOOK: M.L.

Description:
 Note: Cross out word or words which do not apply

- Cleared by lanes bearing..... from Trig. Mast
- Mast & Vanes have been painted white & black respectively. NEW MAST ONLY
- The station/pillar was unpiled/not unpiled/constructed on 5.12.....1987....., dimensions now being:
 Description of mark.....should be explicit. e.g., S/Steel Pillar Plate, Steel plug, Brass plug, Bolt, G.I. Pipe
 Height of mark.....m. ^{above} rock/concrete; Mark is.....m. ^{above} G.L.
- Height of Top Vanes to Top Mark/Pillar plate 440.....m. Diameter of Vanes (vertical).....250.....m.
- Height of Cairn.....m. Diameter of Cairn.....m. Name Plate found/~~not found~~/~~placed~~.
- Length of Mast 1600.....m. (approximate if not unpiled)
- A.....set in conc/rock has been placed/found, bearing.....° M from Mast/Plug/Pillar
- A.....set in conc/rock has been placed/found, bearing.....° M from Mast/Plug/Pillar
- A.....set in conc/rock has been placed/found, bearing.....° M from Mast/Plug/Pillar
- A.....set in conc/rock has been placed/found, bearing.....° M from Mast/Plug/Pillar
- Action required: Repl. Mast. Place!.....

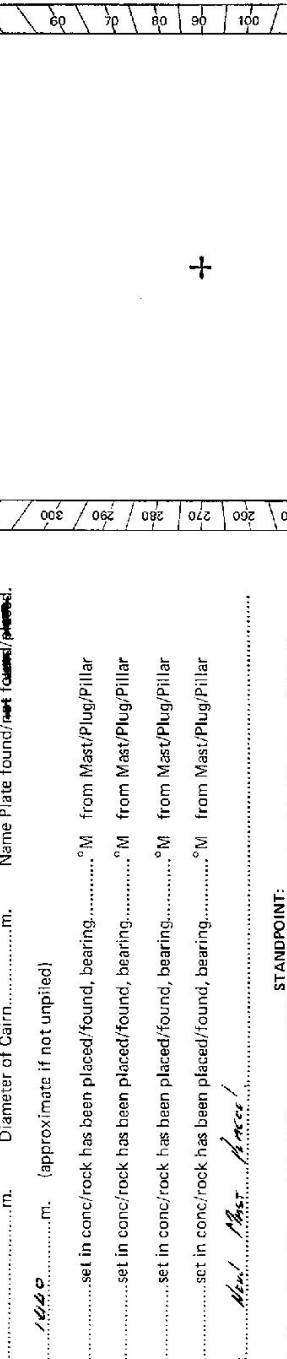

STANDPOINT:

| Mark | Direction | Horiz. Distance | Height Difference | Mark | Direction | Horiz. Distance | Height Difference |
|------|-----------|-----------------|-------------------|------|-----------|-----------------|-------------------|
| | | | above standpt | | | | above standpt |
| | | | below | | | | below |
| | | | above standpt | | | | above standpt |
| | | | below | | | | below |
Prepared by: L.R. Harris Checked: C. M.A.
 Noted on U.T.M. Card

| | |
|--|---|
| STATION SERVIEW PILLAR TS 6150 | Owner's Name: Address: Phone: Current Occupant: FRANKS, GERTH/SHIH/..... Address: WILKINSON RD Phone: ACCESS MY Access Report of 1.1.10 was found suitable/..... 0.00 ON OTHER HIGHWAY SIGN NUMBER 10 D.S.M. TOWER EAST TOWER'S WARDLE 11.60 TALL LEFT SIGN SERVIEW RD, FRANKS RD / 12.50 TALL LEFT SIGN SERVIEW RD 22.10 TALL LEFT HAND FORD 30.70 SERVIEW GEODETIC STATION 2: |
| Beacon Diagram Not to Scale | This section to be completed by officer constructing pillar. Original station mark found/..... Description of mark: BRASS TALL PILLAR AND MARK Original beacon found/..... Description of beacon: CONCRETE MARK AND MARKS Height Top of Vanes to Top Mark: 3.27 m. Height of mark: 1.1 m. above rock/conc. 1410 m. below G.L. Diameter of Vanes: 110 m. Height of Cairn: 1.60 m. Original Beacon has/..... been destroyed by me. |
| | Date Record of Station |