

CENTRAL MAPPING AUTHORITY

GEODETTIC SURVEY OF N.S.W.

GEODETTIC STATION RECONNAISSANCE and MAINTENANCE REPORT


STATION: **TUGGA (Pillar)** No.: **6158**

MAP SHEET SCALE 1:250 000 **WAGGA WAGGA**

INSPECTED BY: **H. C. BORDER** DATE: **26-4-78**

AUTHORITY: **C.M.A** FIELD BOOK: **01656**

Description:  
 1. Cleared by lanes bearing. *Note: Cross out word or words which do not apply*  
 2. Mast & Vanes have been painted white & black respectively, v  
 3. The station pillar was ~~unpainted~~ ~~unpainted~~ / constructed on **24-4-** ~~1978~~ dimensions now being  
 Description of mark: **S/S Pillar Plate** should be explicit, e.g., S/Steel Pillar Plate, Steel plug, Brass plug, Bolt, G.I. Pipe  
 Height of mark: **1.370** m. above ~~below~~ ~~concrete~~ Mark is **1.470** m. above ~~below~~ G.L.  
 Height of Top Vanes to Top Mark/Pillar plate **1.440** m. Diameter of Vanes (vertical) **0.155**  
 Height of Cairn **1.440** m. Diameter of Cairn **0.155** m. Name ~~Plate found/not found~~ ~~placed~~.  
 Length of Mast **1.520** m. (approximate if not unpled)  
 4. **A.S.S.M. 23958** set in conc/~~rock~~ has been ~~placed~~ ~~found~~, bearing **277** °M from ~~Mast/Plug/Pillar~~  
 5. **A. COPPER NAIL** set in conc/~~rock~~ has been ~~placed~~ ~~found~~, bearing **294** °M from ~~Mast/Plug/Pillar~~  
 6. **A.** set in conc/~~rock~~ has been ~~placed~~ ~~found~~, bearing **277** °M from ~~Mast/Plug/Pillar~~  
 7. **A.** set in conc/~~rock~~ has been ~~placed~~ ~~found~~, bearing **277** °M from ~~Mast/Plug/Pillar~~  
 8. Action required: **NAME PLATE To BE SUPPLIED** STANDPOINT: **S.S.M 23958**

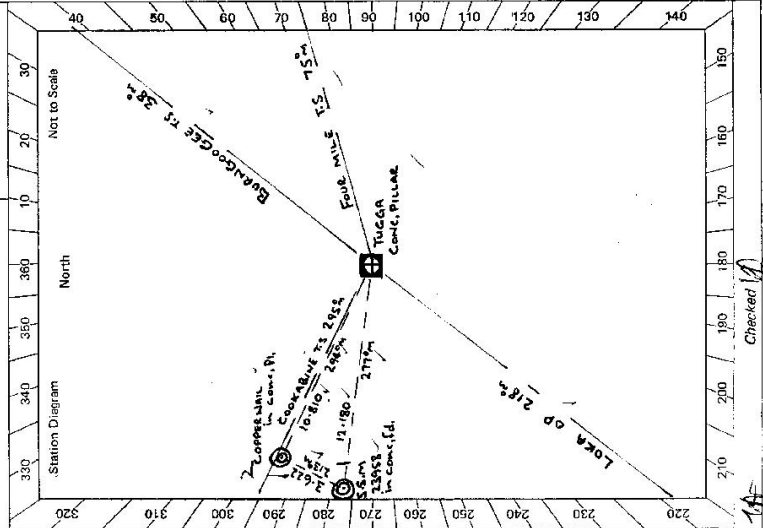

Mark	Direction	Horiz. Distance	Height Difference	Mark	Direction	Horiz. Distance	Height Difference
BURNGOOGEE TS	359 59 60		above standpt.	BURNGOOGEE TS	359 59 60		above standpt.
MCLAURIN OP	90 39 50		above standpt.	FOUR MILE TS	33 56 45		above standpt.
LOKA OP	174 17 00		above standpt.	CONC. PILLAR	51 03 40	12.179	0.547
S.S.M 23958	231 05 00	12.182	0.543	MCLAURIN OP	90 33 25		above standpt.
COPPER NAIL	247 53 20	10.810	1.038	LOKA OP	174 15 00		above standpt.
COOKABINE	249 16 55		above standpt.	COOKABINE TS	249 16 30		above standpt.
			below	COPPER NAIL	351 21 00	3.622	0.493

Prepared by: **H.C. BORDER** Checked: **H.C. BORDER** Noted on U.T.M. Card

STATION	TUGGA (PILLAR) TS 6158	
<p>Owner's Name: <b>MISS ROSS</b>                      Address: <b>"TINTAGEL"</b>                      VIA <b>HOLBROOK</b> N.S.W.                      Phone: .....</p>	<p>Current Occupant: <b>FARMER</b>                      Address: .....</p>	<p>P.O. 0.0 km                      1.16 km                      11.70 km                      17.40 km                      18.70 km                      19.00 km                      19.10 km                      19.30 km                      19.70 km                      20.40 km</p>
<p><b>ACCESS</b></p>		
<p>Access Report of 7/11/14/18 was found suitable/unsuitable.                      from <b>HOLBROOK</b> P.O. drive north along Home Hwy.                      turn left into Wagga Road at                      turn right into KAWIMBLA Road (through road) at                      turn left over grid at                      turn left into "TINTAGEL" road to house. at                      OWSEES HOUSE on left, turn right, gate at                      through gate, turn left at                      through gate, turn right, follow track up hill, at                      turn left along fence line at                      follow track up hill to trig at</p>		
<p>Not to Scale</p>	<p>This section to be completed by officer constructing pillar.</p> <p>Original station mark <del>found</del>/not found. ✓</p> <p>Description of mark: .....</p> <p>Original beacon <del>found</del>/not found.</p> <p>Description of beacon: .....</p> <p>Height Top of Vanes to Top Mark.....m.</p> <p>Height of mark.....m. above G.L. below rock/cont.....m.</p> <p>Diameter of Vanes.....m. Height of Cairn.....m.</p> <p>Original Beacon has/has not been destroyed by me.</p>	<p>Date</p> <p>Record of Station</p>

CENTRAL MAPPING AUTHORITY

GEODETTIC SURVEY OF N.S.W.

GEODETTIC STATION RECONNAISSANCE and MAINTENANCE REPORT

Description:

1. Cleared by James bearing  $0^{\circ}$   $36^{\circ}$  from Trig. ~~Steel~~ Pillar  
 Note: Cross out word or words which do not apply

2. Mast & Vanes have been painted white & black respectively.

3. The ~~station~~/pillar was ~~completed/not completed~~/constructed on  $AP.RL$   $1978$ , dimensions now being:  
 Stainless Steel

Description of mark: ~~Pillar~~  $\dots$  should be explicit, e.g., S/Steel Pillar Plate; ~~Steel plate; Brass plug; Bolt; Galv Pipe~~

Height of mark  $\dots$  m. <sup>above</sup>/<sub>below</sub> rock/concrete; Mark is  $1.5$  m. <sup>above</sup>/<sub>below</sub> G.L.

Height of Top Vanes to Top ~~Mark~~/Pillar plate  $1.44$  m. Diameter of Vanes (vertical)  $0.75$  m.

~~Height of Girth~~  $\dots$  m. ~~Diameter of Girth~~  $\dots$  m. Name Plate found/~~not found~~/placed

Length of Mast  $1.52$  m. (approximate if not unplied)

4. A  $S.S.M. 2.3958$  set in ~~stone~~/rock has been placed/~~found~~; bearing  $273^{\circ}$   $0^{\circ}$  M from ~~Mast/Plug~~/Pillar

5. A  $\dots$  set in conc/rock has been placed/~~found~~, bearing  $\dots^{\circ}$  M from Mast/~~Plug~~/Pillar

6. A  $\dots$  set in conc/rock has been placed/~~found~~, bearing  $\dots^{\circ}$  M from Mast/~~Plug~~/Pillar

7. A  $\dots$  set in conc/rock has been placed/~~found~~, bearing  $\dots^{\circ}$  M from Mast/~~Plug~~/Pillar

8. Action required:  $\dots$

STANDPOINT: TUGGA [PI]

Mark	Direction	Horiz. Distance	Height Difference	Mark	Direction	Horiz. Distance	Height Difference
Peddles T.S.	$0^{\circ} 00' 00''$		above standpt.				above standpt.
Coacook SSM	$229^{\circ} 19' 47.9''$		above standpt.				above standpt.
Eces SSM 2.3958	$347^{\circ} 24' 35''$		below standpt.				below standpt.
			0.54				below standpt.
			above standpt.				above standpt.
			above standpt.				above standpt.
			below standpt.				below standpt.
			above standpt.				above standpt.
			below standpt.				below standpt.
			above standpt.				above standpt.
			below standpt.				below standpt.

Prepared by: P. D. CURTIS

Checked:

Noted on U.T.M. Card


S: 2733-1

STATION: TUGGA [PI] No.: 6158

MAP SHEET SCALE 1:250,000 WAGGA WAGGA

INSPECTED BY: M. A. Hooper DATE: 13-7-78

AUTHORITY: DEPT. OF MAIN ROADS FIELD BOOK: C.S. 161

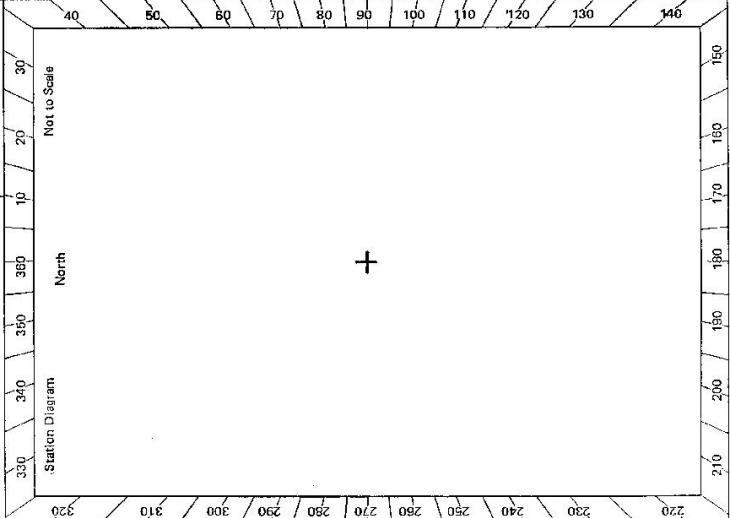

Checked

11/5/81

STATION	<b>TUGGA [P]</b> TS 6158	Owner's Name: Miss. D. Ross Address: Tintagel, Kanimbla Rd Via Holbrook Phone:	Current Occupant: Miss. D. Ross Address: Tintagel, Kanimbla Rd Via Holbrook Phone:	<p style="text-align: center;"><b>Tugga</b> 19.90 km.</p> <p style="text-align: center;"><b>ACCESS</b></p> <p>Access Report of 13/7/1988 was found suitable/unsuitable, 00 KM at Holbrook P.O. - Proceed North 1.40 KM. Turn left to Wagga 11.37 km. Turn Right into Kanimbla Road Proceed along this Road to Ch.17.40 km. then refer to diagram.</p>	NOT TO SCALE
Date	Record of Station				

SI 2733-2 D. West. Government Printer

<p style="text-align: center;">Beacon Diagram</p>	<p style="text-align: center;">Not to Scale</p> <p style="text-align: center;">58FO</p> <p style="text-align: center;">1.8</p>
This section to be completed by officer constructing pillar. Original station mark found/not found. Description of mark: ..... Original beacon found/not found. Description of beacon: ..... Height Top of Vanes to Top Mark: .....m. Height of mark: .....m. above G.L. below Diameter of Vanes: .....m. Height of Cairn .....m. Original Beacon has/has not been destroyed by me.	