

**LAND INFORMATION CENTRE**

GEODETTIC SURVEY OF N.S.W.

**GEODETTIC STATION RECONNAISSANCE and MAINTENANCE REPORT**

Description: *Note: Cross out word or words which do not apply*

1. Cleared by lanes bearing..... from Trig. Mast
2. Mast & Vanes have been painted white & black respectively.
3. The station/pillar was unpiled/not unpiled/constructed on..... 19....., dimensions now being:  
 Description of mark.....should be explicit, e.g. S/Steel Pillar Plate, Steel plug, Brass plug, Bolt, G.I. Pipe  
 Height of mark.....m. <sup>above</sup> rock/concrete; Mark is.....m. <sup>above</sup> G.L. <sub>below</sub>  
 Height of Top Vanes to Top Mark/Pillar plate .....m. Diameter of Vanes (vertical).....m.  
 Height of Cairn.....m. Diameter of Cairn.....m. Name Plate found/not found/placed.  
 Length of Mast .....m. (approximate if not unpiled)
4. A.....set in conc/rock has been placed/found, bearing.....° M from Mast/Plug/Pillar
5. A.....set in conc/rock has been placed/found, bearing.....° M from Mast/Plug/Pillar
6. A.....set in conc/rock has been placed/found, bearing.....° M from Mast/Plug/Pillar
7. A.....set in conc/rock has been placed/found, bearing.....° M from Mast/Plug/Pillar

8. Action required:.....

STANDPOINT:				STANDPOINT:			
Mark	Direction	Horiz. Distance	Height Difference	Mark	Direction	Horiz. Distance	Height Difference
			above standpt.				above standpt.
			below				below
			above standpt.				above standpt.
			below				below
Prepared by: *C. Micho* 3/12/12 Checked: *S. Paul* Noted on: *U.T.M. Card*

STATION: *LOCH LILY 7131/1004* No.: *6159*  
 MAP SHEET SCALE 1:250 000  
 INSPECTED BY: *G. DICKSON* DATE: *24.7.91*  
 AUTHORITY: *L.I.C.* FIELD BOOK: *2105*

*T. 1/7031*

Station Diagram  
 North  
 No on plaque new *7131/1004*



Batch Id: 1542

LAND INFORMATION CENTRE


GEODETTIC SURVEY OF A.S.W.

GEODETTIC STATION RECONNAISSANCE and MAINTENANCE REPORT

STATION: LILLY 713/1004 No.: 6159  
 MAP SHEET SCALE 1:250 000

INSPECTED BY: L. HITCHINS  
 AUTHORITY: LIC  
 DATE: 19.8.91  
 FIELD BOOK: 630

- Description:
1. Cleared by Janes bearing..... from Trig. Mast  
 Note: Cross out word or words which do not apply
  2. Mast & Vanes have been painted white & black respectively.
  3. The station/pillar was unpiled/not unpiled/constructed on..... from Trig. Mast  
 BRONZE PLASQUE IN CONCRETE  
 Description of mark..... should be explicit, e.g., S/Steel Pillar Plate, Steel plug, Brass plug, Bolt, G.I. Pipe  
 Height of mark.....m. above rock/concrete; Mark is.....m. above G.L.  
 Height of Top Vanes to Top Mark/Pillar plate.....m. Diameter of Vanes (vertical).....m.  
 Height of Cairn.....m. Diameter of Cairn.....m. Name Plate found/not found/placed.  
 Length of Mast.....m. (approximate if not unpiled)
  4. A. G.I. PIPE SOIL.....set in conc./rock has been placed/ found, bearing.....° M from Mast/Plug/Pillar
  5. A. Marker Post SOIL.....set in conc./rock has been placed/ found, bearing.....° M from Mast/Plug/Pillar
  6. A. Marker Post SOIL.....set in conc./rock has been placed/ found, bearing.....° M from Mast/Plug/Pillar
  7. A.....set in conc./rock has been placed/ found, bearing.....° M from Mast/Plug/Pillar
  8. Action required:.....

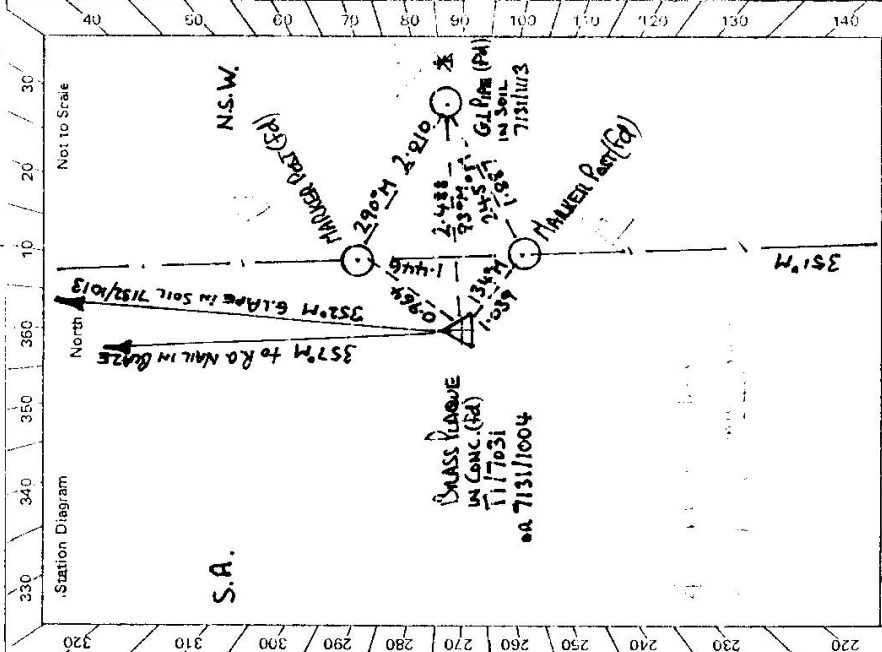

Mark	Direction	Horiz. Distance	Height Difference	Mark	Direction	Horiz. Distance	Height Difference
G.I. PIPE 7132/1013	0 00 00		above standpt.	G.I. PIPE in Soil 7131/1013	0 00 00		above standpt.
MARKER POST (P)	44 28 00	0 964	above standpt.	MARKER POST	252 11 50	1 887	above standpt.
G.I. PIPE 7131/1113	94 42 00	2 489	above standpt.	MARKER POST	274 50 00	2 487	above standpt.
MARKER POST (P)	138 58 10	1 039	above standpt.	MARKER POST	296 24 15	2 010	above standpt.
NAIL in tree	358 01 30		above standpt.	NAIL in tree	356 30 15		above standpt.
			below				below
			below				below

STANDPOINT: BRASS IN CONC. 10 STANDPOINT: G.I. PIPE IN SOIL 7131/1113 3

Prepared by: L.Hitchins  
 Checked: B. John 9.10.91  
 Noted on U.T.M. Card

Checked