

GEODETTIC SURVEY OF NS.F.

CENTRAL MAPPING AUTHORITY

GEODETTIC STATION RECONNAISSANCE and MAINTENANCE REPORT

- Description:
1. Cleared by lanes bearing..... Note: Cross out word or words which do not apply
2. Mast & Vanes have been painted white & black respectively.
3. The station/pillar was unpiled/not unpiled/constructed on..... 19....., dimensions now being:
- Description of mark..... should be explicit, e.g., S/Steel Pillar Plate, Steel plug, Brass plug, Bolt, G.I. Pipe
- Height of mark..... m: <sup>above</sup>/<sub>below</sub> rock/concrete; Mark is 2.3 m. <sup>above</sup>/<sub>below</sub> G.I.
- Height of Top Vanes to Top Mark/Pillar plate..... m. Diameter of Vanes (vertical)..... m.
- Height of Cairn..... m. Diameter of Cairn..... m. Name Plate found/not found/placed.
- Length of Mast..... m. (approximate if not unpiled)
4. A..... set in conc/rock has been placed/found, bearing..... °M from Mast/Plug/Pillar
5. A..... set in conc/rock has been placed/found, bearing..... °M from Mast/Plug/Pillar
6. A..... set in conc/rock has been placed/found, bearing..... °M from Mast/Plug/Pillar
7. A..... set in conc/rock has been placed/found, bearing..... °M from Mast/Plug/Pillar
8. Action required:.....

STANDPOINT:

Mark	Direction	Horiz. Distance	Height Difference	Mark	Direction	Horiz. Distance	Height Difference
			above standpt				above standpt
			below standpt				below standpt
			above standpt				above standpt
			below standpt				below standpt
Prepared by: L. Dickson


Checked: C. Hobbs 30/05/22 *Noted on U.T.M. Card*

STATION: F2/764-DANGGALL No: 6162

MAP SHEETS SCALE 1:250 000 ANA BRANCH

INSPECTED BY: G. DICKSON DATE: 25.7.91

AUTHORITY: L.I.C. FIELD BOOK: 210.5

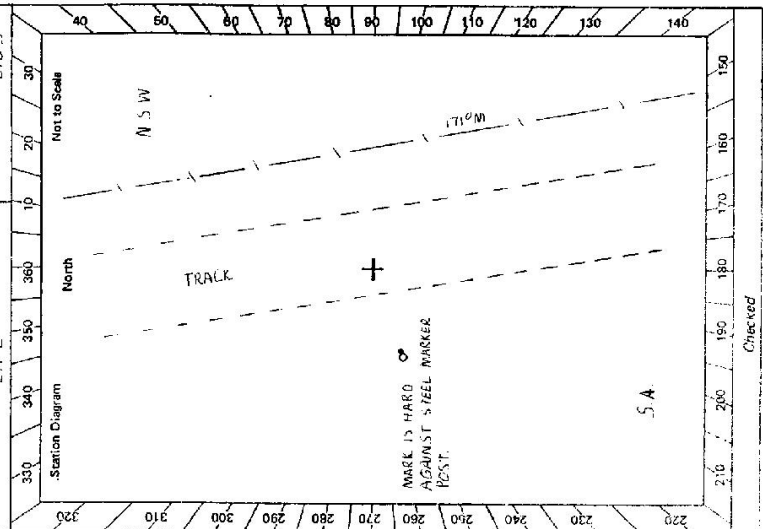

Checked

GS 24

STATION T2 / T031 DANGGALI TS 6162

Beacon Disgrat	Not to Scale
ALTERNATIVE ACCESS FROM C200BAH	
OWNER'S NAME: MR. TREVOR BROWN	CURRENT OCCUPANT:
ADDRESS: TAREWI H.S.	ADDRESS:
PHONE: 271 348	PHONE:
ACCESS:	
Access Report of 25.7.1991 was found suitable/unsuitable.	
FEATURE	
On Silver City Hwy 2km north of Wentworth, turn left. Sign 'Remark 153', Broken Hill 265, Wentworth 2.	
Bridge.	
Pass 'Ara Branch Mill Rd' on right.	
Turn right. Remark 123, Nalla Nalla 45, Huntfield 69, Wentworth 24, Remark via Rufus River 142.	
Pass road on right. 'Tooperooahna, Wannanunga	
Straight ahead. Sign 'Remark 93', Broken Hill 263, Wentworth 20. (50m from 0.00)	
Turn right. Nalla Road sign 'in Remark, 219 Broken Hill, 12.19 Wentworth	
Balmore H.S. straight ahead.	
Turn left. Sign 'Tarawi 12 mile'. (1hr 30min from 0.00)	
Grid.	
Gate 'Tarawi'	
Before of crest, road turns left	
Homestead. Turn left between garage & water take app H.S.	
Gate turn left.	
Gate.	
Wire gate.	
Turn right along airstrip	
Gate	
Road joins fence.	
Gate.	
Gate.	
Take left fork. Gate on L.H.S.	
Border gate. Sign 'Remark'. Stockyard on R.H.S. Head south, left	
T2/T031 (2 hrs from 0.00)	
Owner's Name	Current Occupant
Address	Address
Phone	Phone
Access	
Access Report of 25.7.1991 was found suitable/unsuitable.	
FEATURE	
On Silver City Hwy 2km north of Wentworth, turn left. Sign 'Remark 153', Broken Hill 265, Wentworth 2.	
Bridge.	
Pass 'Ara Branch Mill Rd' on right.	
Turn right. Remark 123, Nalla Nalla 45, Huntfield 69, Wentworth 24, Remark via Rufus River 142.	
Pass road on right. 'Tooperooahna, Wannanunga	
Straight ahead. Sign 'Remark 93', Broken Hill 263, Wentworth 20. (50m from 0.00)	
Turn right. Nalla Road sign 'in Remark, 219 Broken Hill, 12.19 Wentworth	
Balmore H.S. straight ahead.	
Turn left. Sign 'Tarawi 12 mile'. (1hr 30min from 0.00)	
Grid.	
Gate 'Tarawi'	
Before of crest, road turns left	
Homestead. Turn left between garage & water take app H.S.	
Gate turn left.	
Gate.	
Wire gate.	
Turn right along airstrip	
Gate	
Road joins fence.	
Gate.	
Gate.	
Take left fork. Gate on L.H.S.	
Border gate. Sign 'Remark'. Stockyard on R.H.S. Head south, left	
T2/T031 (2 hrs from 0.00)	

KMS	FEATURE	KMS	FEATURE
0.00	37km south of Coombah Roadhouse, turn off. Sign 'Pine Camp 85'	0.00	
0.05	Grid.	13.90	
3.55	Pass NM/L4 on R.H.S 300m off road	14.60	
6.45	Grid.	23.05	
8.40	Grid.	33.20	
15.40	Grid.	58.00	
20.70	Grid.	107.60	
23.85	Straight ahead at crossroads. Sign 'Wentworth 71, 92 Balmore, 87 Remark, To Broken Hill Road 15.'		
24.65	Grid.		
33.35	Grid.		
34.75	Grid.		
38.25	Grid.		
46.45	Grid.		
47.55	Grid.		
53.45	Grid.		
54.75	* Turn right. Sign 'Tarawi 12 mile'. (50min from 0.00)		
	Continue as per other access.		

This section to be completed by officer constructing pillar.

Original station mark found/not found.

Description of mark: .....

Original beacon found/not found.

Description of beacon: .....

Height Top of Vanes to Top Mark: .....m.

Height of mark: .....m. above G.L. below

Diameter of Vanes: .....m. Height of Cairn: .....m.

Original Beacon has/has not been destroyed by me.

Date	Record of Station