


73 6183

CENTRAL MAPPING AUTHORITY

GEODETIC SURVEY OF M.S.W.  
 GEODETIC STATION RECONNAISSANCE and MAINTENANCE REPORT

STATION: **MUMURRAY (P)** No.: **3288**  
 MAP SHEET SCALE: **1:250 000** **WOLLONGONG**  
 INSPECTED BY: **CHUCK DICKSON** DATE: **30th MAR '78**  
 AUTHORITY: **C.M.A.** FIELD BOOK: **1642**

Description:  
 1. Cleared by lanes bearing  $9^\circ - 296^\circ 17'$   $320^\circ - 352^\circ 14'$  from Trig. Mast  
 Note: Cross out word or words which do not apply  
 2. Mast & Vanes have been painted white & black respectively.  
 3. The station/pillar was unpiled/not unpiled/constructed on ..... 19....., dimensions now being:  
 Description of mark: **S.S.A. 22367** should be explicit, e.g., S/Steel Pillar Plate, Steel plug, Brass plug, Bolt, G.I. Pipe  
 Height of mark: **1.80** m. above ~~rock~~ **rock**/concrete; Mark is ..... m. above below G.L.  
 Height of Top Vanes to Top Mark/Pillar plate **1.80** m. Diameter of Vanes (vertical) **0.6** m.  
 Height of Cairn..... m. Diameter of Cairn..... m. Name Plate **found**/not found/**placed**.  
 Length of Mast..... m. (approximate if not unpiled) G.L. **MAIL** at **0** ft. **MAIL** in **CONC.**

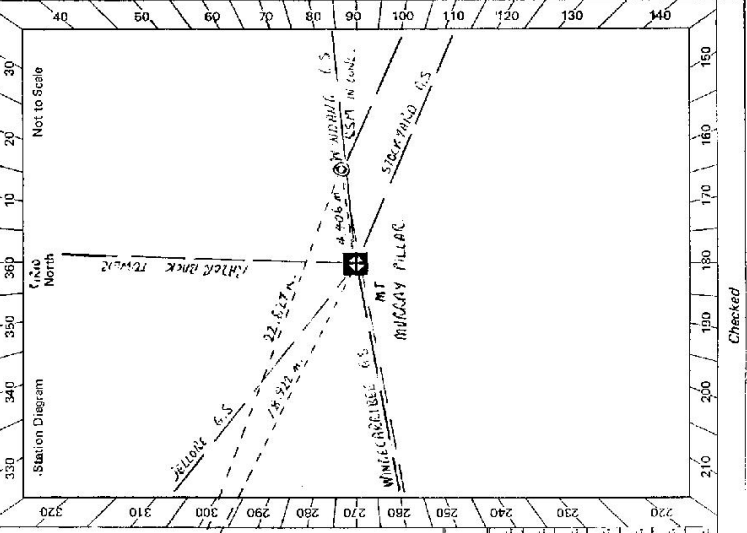

Mark	Direction	Horiz. Distance	Height Difference	Mark	Direction	Horiz. Distance	Height Difference
STEEL PILLAR G.S. 0 00 00	0 00 00		above standpt.	STEEL PILLAR G.S. 0 00 00	0 00 00		above standpt.
WOLLONGONG S.S. 22367 187 30 34	187 30 34	18.242	above standpt.	WOLLONGONG S.S. 22367 147 48 57	147 48 57		above standpt.
WOLLONGONG S.S. 22367 330 41 44	330 41 44	1.644	above standpt.	WOLLONGONG S.S. 22367 177 45 16	177 45 16	22.739	above standpt.
WOLLONGONG S.S. 22367 147 48 57	147 48 57	1.406	above standpt.	WOLLONGONG S.S. 22367 147 48 57	147 48 57	1.644	above standpt.
WOLLONGONG S.S. 22367 147 48 57	147 48 57	1.406	above standpt.	WOLLONGONG S.S. 22367 147 48 57	147 48 57	0.377	above standpt.
WOLLONGONG S.S. 22367 147 48 57	147 48 57	1.406	above standpt.	WOLLONGONG S.S. 22367 147 48 57	147 48 57		above standpt.
WOLLONGONG S.S. 22367 147 48 57	147 48 57	1.406	above standpt.	WOLLONGONG S.S. 22367 147 48 57	147 48 57		above standpt.
WOLLONGONG S.S. 22367 147 48 57	147 48 57	1.406	above standpt.	WOLLONGONG S.S. 22367 147 48 57	147 48 57		above standpt.

STANDPOINT: **PILLAR PLATE**      STANDPOINT: **S.S.M 22167**  
 Action required: **NO ACTION REQUIRED**  
 Prepared by: **GARY A. L. L.**      Checked: \_\_\_\_\_  
 Noted on U.T.M. Card

S: 2733-1

GS:

St 2739-2 D. West, Government Printer

Beacon Diagram Not to Scale

STATION MURRAY (P) TS 6183

Owner's Name: .....  
 Address: .....  
 Phone: .....

Current Occupant: .....  
 Address: .....  
 Phone: .....

Access Report of PROVIDED was found ~~unsuitable~~/unsuitable.

ACCESS 30% Aug 1978

Kms.	Description
0.0	ROBERTSON P.O. PLOTTED EAST ALONG KILMORRICH HWY.
3.1	INTERSECTION - ROAD TO KILPATRICK TOES TO KILMORRICH HWY.
4.1	ROAD TO KILPATRICK
5.9	TOWNSHIP ROAD ON LEFT
6.4	LINE ON LEFT ELECTRICITY COMMISSIONS OF N.S.W. 120-130
7.0	FEAR TOWARDS SWIMMING AREA. A TOP LINE WILL BE VISIBLE ON LEFT TURN OF TOWARDS THIS
7.3	LINE - FOLLOW ELECTRICITY COMMISSION ACCESS THROUGH UP HILL PAST TOWER.
7.6	LINE - HEAD THROUGH LINE SPACED OUT SCOTE TOWARDS ADV POINTS POWER POLE - REMAINS OF BOLDERS. MORE ON.
7.7	PASS UNDER LOW VOLTAGE TOWER LINES AND PASS POLE ON RIGHT HAND SIDE. PICK UP WHITE TOWER CORNER OFF TO LEFT.
8.0	PASS THROUGH OLD FENCE AND TURN RIGHT FOLLOWING OLD FENCE LINE
8.1	VEER RIGHT AROUND THREE METERS OF ROCKS AROUND FOLLOW FRONT TOWER AROUND TO LEFT AND THEN UP TOWER, THIS WILL BECOME VISIBLE.
8.3	▲ PILLAR.

Date: .....

Record of Station: .....

Land not subdivided

A house is now adjacent to the TS 2 Jan 1988

This section to be completed by officer constructing pillar.

Original station mark ~~found~~/not found.

Description of mark: .....

Original beacon found/not found.

Description of beacon: .....

Height Top of Vanes to Top Mark.....m.

Height of mark.....m. above G.L. below

Diameter of Vanes.....m. Height of Cairn.....m.

Original Beacon has/has not been destroyed by me.

GEODETIC SURVEY OF N.S.W.

CENTRAL MAPPING AUTHORITY

GEODETIC STATION RECONNAISSANCE and MAINTENANCE REPORT

Description: *Note: Cross out word or words which do not apply*

1. Cleared by lanes bearing..... from Trig. Mast
2. Mast & Vanes have been painted white & black respectively.
3. The station/pillar was unpiled/not unpiled/constructed on.....19....., dimensions now being:
  - Description of mark.....should be explicit, e.g., S/Steel Pillar Plate, Steel plug, Brass plug, Bolt, G.I. Pipe
  - Height of mark.....m. <sup>above</sup> rock/concrete; Mark is.....m. <sup>above</sup> G.L.
  - Height of Top Vanes to Top Mark/Pillar/plate.....m. Diameter of Vanes (vertical).....m.
  - Height of Cairn.....m. Diameter of Cairn.....m. Name Plate found/not found/placed.
  - Length of Mast.....m. (approximate if not unpiled)
4. A.....set in conc/rock has been placed/found, bearing.....°M from Mast/Plug/Pillar
5. A.....set in conc/rock has been placed/found, bearing.....°M from Mast/Plug/Pillar
6. A.....set in conc/rock has been placed/found, bearing.....°M from Mast/Plug/Pillar
7. A.....set in conc/rock has been placed/found, bearing.....°M from Mast/Plug/Pillar
8. Action required:.....

STANDPOINT:

Mark	Direction	Horiz. Distance	Height Difference	Mark	Direction	Horiz. Distance	Height Difference
			above standpt.				above standpt.
			below standpt.				below standpt.
			above standpt.				above standpt.
			below standpt.				below standpt.
			above standpt.				above standpt.
			below standpt.				below standpt.
			above standpt.				above standpt.
			below standpt.				below standpt.

Prepared by: *[Signature]*

Checked: *[Signature]*

Noted on U.T.M. Card


ST 2735-1

STATION: *Mount Murray G.S.* No.: *6183*

MAP SHEET SCALE 1:250 000

INSPECTED BY: *M.L. Morrison* DATE: *17-1-79*

AUTHORITY: *C.M.A.* FIELD BOOK: *1720*

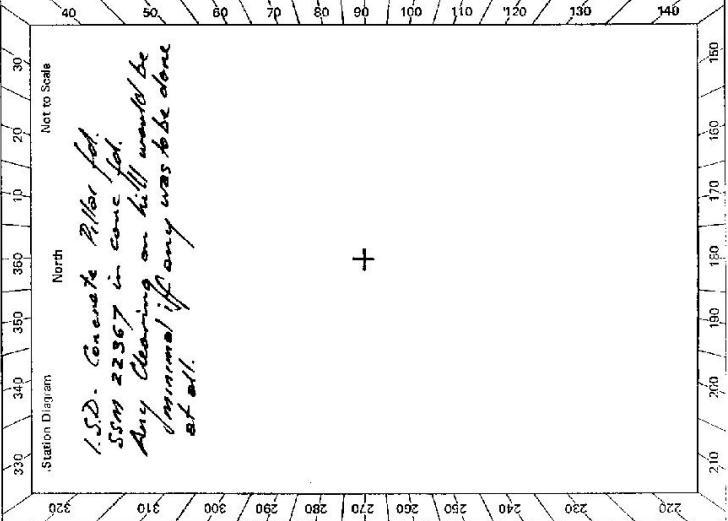

Checked

GS

STATION Mount Murray G.S. TS 6183

Owner's Name: .....  
 Address: .....  
 Phone: .....


Current Occupant: .....  
 Address: .....  
 Phone: .....

ACCESS

Access Report of 17.1.1971 was found suitable/unsuitable.

*Direction*  
 0.00 Robertson Rd. Head towards Warralong  
 3.30 Pass Road to Tamboroo + turn on right  
 6.60 Turn left along Tourist Road  
 6.75 Turn Right just before bridge. Locked gate  
 (A.S. on back. Make way to timber line on L.H.S.  
 1975) of clearing then a track becomes visible to try  
 about 0.5 km past gate

Land subdivided  
 A house is now adjacent to the T.S. 2 Jan 1988

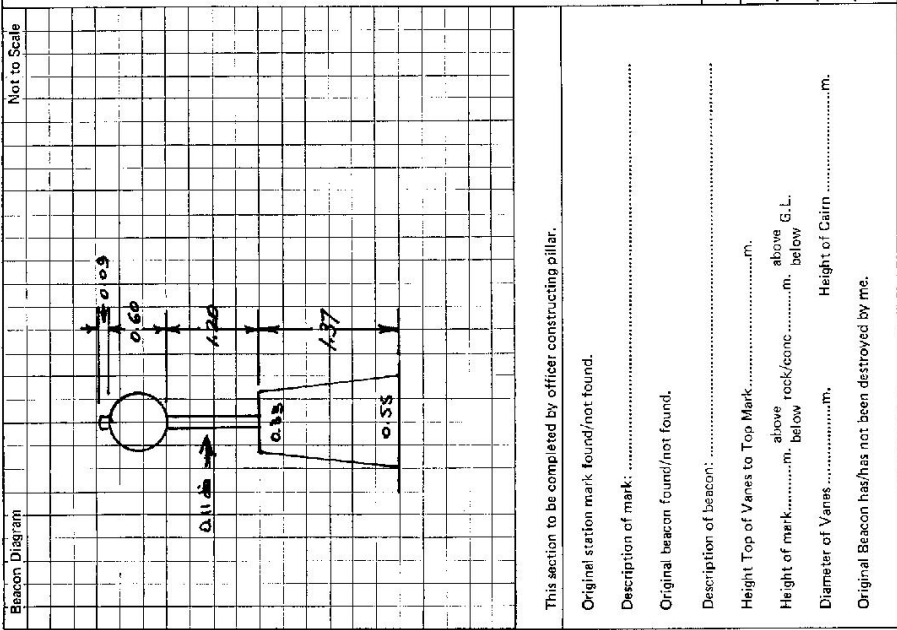

Date	Record of Station

GEODETIC SURVEY OF A.S.W.

CENTRAL MAPPING AUTHORITY

GEODETIC STATION RECONNAISSANCE and MAINTENANCE REPORT

Description:

1. Cleared by lanes bearing.....  
*Note: Cross out word or words which do not apply*
2. Mast & Vanes have been painted white & black respectively.
3. The station/pillar was unpiled/not unpiled/constructed on.....19....., dimensions now being:

Description of mark..... should be explicit, e.g., S/Steel Pillar Plate, Steel plug, Brass plug, Bolt, G.I. Pipe

Height of mark.....m. above below rock/concrete; Mark is.....m. above below G.L.

Height of Top Vanes to Top Mark/Pillar plate 1.46m. Diameter of Vanes (vertical) 0.60m.

Height of Cairn.....m. Diameter of Cairn.....m. Name Plate found/not found/placed.

Length of Mast.....m. (approximate if not unpiled)

4. A..... set in conc/rock has been placed/found, bearing.....°M from Mast/Plug/Pillar
5. A..... set in conc/rock has been placed/found, bearing.....°M from Mast/Plug/Pillar
6. A..... set in conc/rock has been placed/found, bearing.....°M from Mast/Plug/Pillar
7. A..... set in conc/rock has been placed/found, bearing.....°M from Mast/Plug/Pillar

8. Action required:.....

STANDPOINT:


STANDPOINT:

Mark	Direction	Horiz. Distance	Height Difference	Mark	Direction	Horiz. Distance	Height Difference
			above standpt.				above standpt.
			below standpt.				below standpt.
			above standpt.				above standpt.
			below standpt.				below standpt.
			above standpt.				above standpt.
			below standpt.				below standpt.
			above standpt.				above standpt.
			below standpt.				below standpt.

Prepared by: K. H. H. H.

Checked: C. H. H. H.

Named on U.T.M. Card

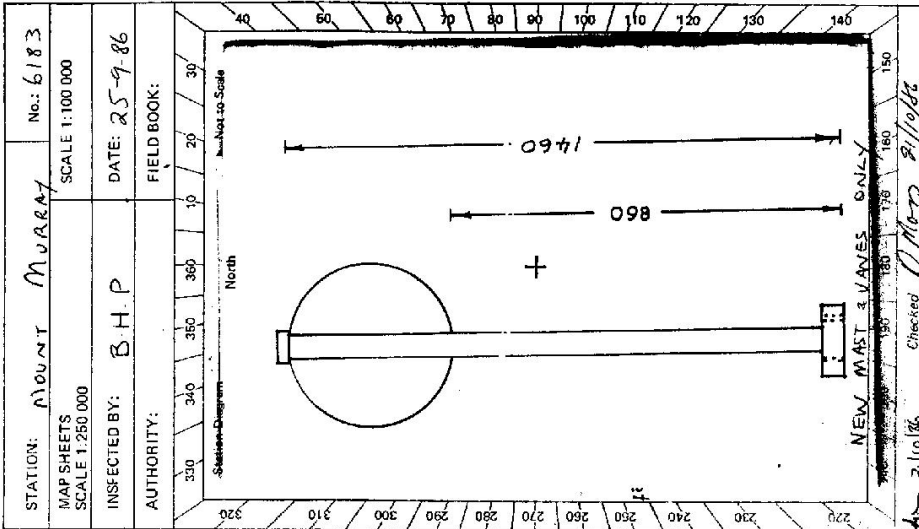

STATION: MOUNT MURRAY No.: 6183

MAP SHEETS SCALE 1:250 000

INSPECTED BY: B.H.P. DATE: 25-9-86

AUTHORITY: FIELD BOOK:

SCALE 1:100 000

Checked: C. H. H. H. 2/10/86

Checked: C. H. H. H. 2/10/86

GEODETTIC SURVEY OF N.S.W.

CENTRAL MAPPING AUTHORITY

GEODETTIC STATION RECONNAISSANCE and MAINTENANCE REPORT

Description:

1. Cleared by lanes bearing.....  
 Note: Cross out word or words which do not apply  
 from Trig. Mast

2. Mast & Vanes have been painted white & black respectively.

3. The station/pillar was unpiled/not unpiled/constructed on.....19....., dimensions now being:

Description of mark..... should be explicit, e.g., S/Steel Pillar Plate, Steel plug, Brass plug, Bolt, G.I. Pipe

Height of mark.....m. above below rock/concrete; Mark is.....m. above below G.L.

Height of Top Vanes to Top Mark/Pillar plate.....m. Diameter of Vanes (vertical).....m.

Height of Cairn.....m. Diameter of Cairn.....m. Name Plate found/not found/placed.

Length of Mast.....m. (approximate if not unpiled)

4. A..... set in conc/rock has been placed/found, bearing.....°M from Mast/Plug/Pillar

5. A..... set in conc/rock has been placed/found, bearing.....°M from Mast/Plug/Pillar

6. A..... set in conc/rock has been placed/found, bearing.....°M from Mast/Plug/Pillar

7. A..... set in conc/rock has been placed/found, bearing.....°M from Mast/Plug/Pillar

8. Action required:.....

STANDPOINT:

STANDPOINT:

Mark	Direction	Horiz. Distance	Height Difference	Mark	Direction	Horiz. Distance	Height Difference
			above standpt.				above standpt.
			below standpt.				below standpt.
			above standpt.				above standpt.
			below standpt.				below standpt.
Prepared by:

Checked:

Named on J.M. Case

Checked

STATION: MOUNT MURRAY No.: 6183  
 MAP SHEETS SCALE 1:250 000  
 INSPECTED BY: Phone call  
 DATE: 13.1.88  
 AUTHORITY: FIELD BOOK:

Station Diagram  
 Not to Scale  
 North

<p>STATION MOUNT MURRAY TS 6183</p>	<p>Owner's Name: <u>Mr D K Adam and Ms Bismingham</u>                  Address: .....                  Phone: <u>02 337 4236</u></p> <p>Current Occupant:                  Address: .....                  Phone: .....</p> <p>Access Report of <u>13.1.1988</u> was found suitable/unuitable.</p>	<p>A house is being erected on the hill adjacent to the T.S.                  If not on site owner can be contacted at 02 337 4236                  Land containing TS is Lot 4 DP?</p>
<p>Beacon Diagram</p> <p>Not to Scale</p>	<p>This section to be completed by officer constructing pillar.</p> <p>Original station mark found/not found.</p> <p>Description of mark: .....</p> <p>Original beacon found/not found.</p> <p>Description of beacon: .....</p> <p>Height Top of Vanes to Top Mark .....m.                  above rock/cons. ....m. below G.L.                  Height of mark: .....</p> <p>Diameter of Vanes .....m. Height of Cairn .....m.</p> <p>Original Beacon has/has not been destroyed by me.</p>	<p>Date</p> <p>Record of Station</p>

