

TS 6208

GEODETTIC SURVEY OF N.S.#:

CENTRAL MAPPING AUTHORITY

GEODETTIC STATION RECONNAISSANCE and MAINTENANCE REPORT

STATION: PRINCES PINNACLE

No.: 2398

MAP SHEET: TAMWORTH  
SCALE 1:250 000 SH 56-13  
GLEN ROCK 1:25000  
9134-I-S

INSPECTED BY: H.P. Jackson DATE: 28/2/1978

AUTHORITY: Geodetic Survey CMA FIELD BOOK: 1627

- Description: *Note: Cross out word or words which do not apply*
- Cleared by ~~James Hastings~~ naturally all round ~~.....~~ from Trig. Mast  
Vanes found painted black (top  $\frac{1}{2}$ )  
& orange (bottom  $\frac{1}{2}$ )
  - Mast & Vanes have been painted white & black respectively  
Mast leaning to the North East
  - The station/pillar was ~~erected~~ ~~erected~~ on 28th February 1978, dimensions now being:  
Description of mark..... should be explicit, e.g., S/Steel Pillar Plate, Steel plug, Brass plug, Bolt, G.I. Pipe
- Height of mark.....m. <sup>above</sup> rock/concrete; Mark is.....m. <sup>above</sup> G.L.
- Height of Top Vanes to Top Mark/Pillar plate.....m. Diameter of Vanes (vertical) 0.914m.
- Height of Cairn.....m. Diameter of Cairn.....m. Name Plate found/not found/placed.  
Cairn is collapsing
- Length of Mast.....m. (approximate if not unplied)
- A..... S.S.M. .... set in conc/rock, has been placed/ found, bearing.....<sup>109</sup>° M from Mast/~~Steel Plate~~
  - A..... set in conc/rock has been placed/ found, bearing.....° M from Mast/Plug/Pillar
  - A..... set in conc/rock has been placed/ found, bearing.....° M from Mast/Plug/Pillar
  - A..... set in conc/rock has been placed/ found, bearing.....° M from Mast/Plug/Pillar
- Construction of Concrete/Steel observation PILLAR near existing Station
8. Action required: ~~Connection of Mast to S.S.M. prior to dismantling~~.....

STANDPOINT:


Mark	Direction	Horiz. Distance	Height Difference	Mark	Direction	Horiz. Distance	Height Difference
			above standpt				above standpt
			below				below
			above standpt				above standpt
			below				below
Prepared by: *Stark*

Checked:

Noted on U.T.M. Card

Sr 2733-1

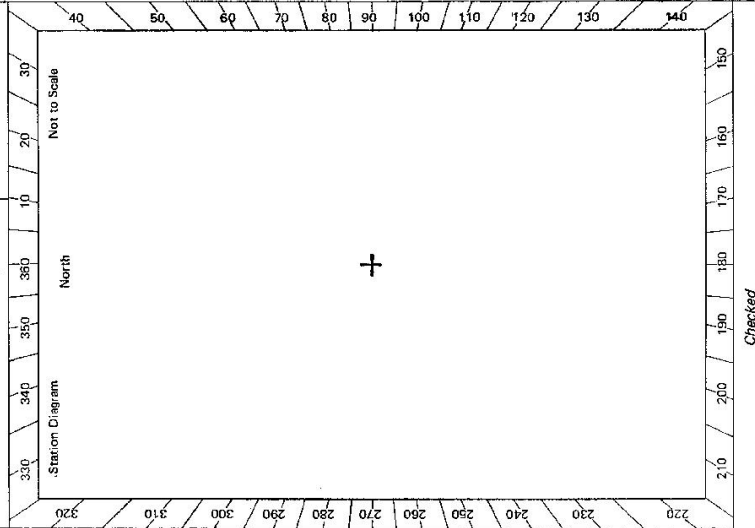

Checked

GEODETTIC SURVEY OF M.S.W.

CENTRAL MAPPING AUTHORITY


GEODETTIC STATION RECONNAISSANCE and MAINTENANCE REPORT

- Description:
1. Cleared by lances bearing 365 M U.S.S.I. *Note: Cross out word or words which do not apply* from Trig. Mast
2. Mast & Vanes have been painted white & black respectively.
3. The ~~standpoint~~ pillar was ~~unplaced~~ constructed on 2.44 m. concrete 1918, dimensions now being: Description of mark Steel Pillar Plate, Steel plug, Brass plug, Bolt, G.I. Pipe should be explicit, e.g., S/Steel Pillar Plate, Steel plug, Brass plug, Bolt, G.I. Pipe
- Height of mark 1.37 m. <sup>above</sup> ~~below~~ concrete; Mark is 1.52 m. <sup>above</sup> ~~below~~ G.L.
- Height of Top Vanes to Top Mast Pillar plate 1.405 m. Diameter of Vanes (vertical) 1.56 m.
- Height of Cairn 0 m. Diameter of Cairn 0 m. Name Plate ~~placed~~ placed.
- Length of Mast 0 m. (approximate if not unplied)
4. ~~Aluminum~~ Aluminum ~~case~~ case set in ~~conc~~ conc/rock has been ~~placed~~ found, bearing 224 ° M from ~~standpoint~~ standpoint/Pillar
5. A. S.S.M. set in ~~conc~~ conc/rock has been ~~placed~~ found, bearing 157 ° M from ~~standpoint~~ standpoint/Pillar
6. A. S.S.M. set in ~~conc~~ conc/rock has been ~~placed~~ found, bearing 121 ° M from ~~standpoint~~ standpoint/Plug/Pillar
7. A. set in ~~conc~~ conc/rock has been placed/ found, bearing 0 ° M from Mast/Plug/Pillar
8. Action required: STANDPOINT: Top line hole

Mark	Direction	Horiz. Distance	Height Difference	Mark	Direction	Horiz. Distance	Height Difference
<u>Standpoint</u>	<u>0 00 00</u>		<u>above</u> <u>standpt.</u>	<u>Standpoint</u>	<u>0 00 00</u>		<u>above</u> <u>standpt.</u>
<u>Aluminum case</u>	<u>125 16 50</u>		<u>above</u> <u>standpt.</u>	<u>Pillar Plate</u>	<u>63 23 20</u>	<u>1.813</u>	<u>above</u> <u>standpt.</u>
<u>S.S.M. in case</u>	<u>170 01 50</u>	<u>2.491</u>	<u>above</u> <u>standpt.</u>	<u>Aluminum case</u>	<u>128 44 50</u>		<u>above</u> <u>standpt.</u>
<u>Witness post</u>	<u>240 15 50</u>		<u>above</u> <u>standpt.</u>	<u>S.S.M. in case</u>	<u>128 40 30</u>	<u>2.627</u>	<u>above</u> <u>standpt.</u>
<u>Aluminum case</u>	<u>243 24 50</u>	<u>1.812</u>	<u>above</u> <u>standpt.</u>	<u>Witness post</u>	<u>240 14 50</u>		<u>above</u> <u>standpt.</u>
			<u>below</u> <u>standpt.</u>				<u>below</u> <u>standpt.</u>
			<u>below</u> <u>standpt.</u>				<u>below</u> <u>standpt.</u>

STANDPOINT: Top line hole Checked: 14/9/78 Noted on U.T.M. Card

S: 2733-1

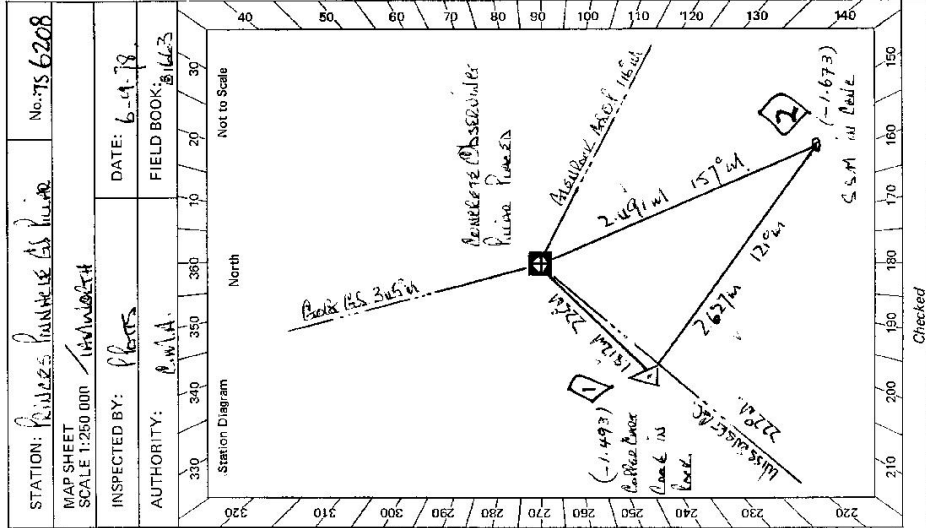

ST 2753-2 D. West, Government Printer	STATION NUMBER <u>TS 6208</u>	Owner's Name: <u>W. H. THYLER</u> Address: <u>MELBORNE</u> Phone: <u>(065) 511 8300</u> ACCESS <u>6-9-1978</u> Access Report of <u>23/7/1978</u> was found suitable/ <del>unsuitable</del> . <u>W. H. THYLER</u>
Beacon Diagram <p>                     Diameter of Beacon: 0.108 m                      Height of Beacon: 0.765 m                      Diameter of Base: 0.165 m                      Height of Base: 1.370 m                      Total Height: 2.135 m                 </p>		Current Occupant: ..... Address: ..... Phone: .....
This section to be completed by officer constructing pillar. Original station mark found/ <del>not found</del> . Description of mark: <u>COLORED PAPER DISC</u> Original beacon found/ <del>not found</del> . Description of beacon: <u>CAIRN POLE AND DISC</u> Height Top of Vanes to Top Mark: <u>2.393</u> m. Height of mark: <u>0.2</u> m. above <del>mark/above</del> m. below G.L. Diameter of Vanes: <u>0.15</u> m. Height of Cairn: <u>1.170</u> m. Original Beacon has/ <del>has not</del> been destroyed by me.		Date: ..... Record of Station: .....

