


Department of Lands
 STATION **TS 3607**
 Co: **FITZROY**
 Map Sheet: **WOOLGOOLGA**
 Inspected by: **P.R. Edwards**
 Authority: **WOOLGOOLGA**
 No: **9537-IV-N**
 Date: **2-12-76**
 Field Book:

Integral survey of N.S.W.
 RECONNAISSANCE and MAINTENANCE REPORT
 This Trig. Station has been:
 Note: Cross out word or words which do not apply

1. Completely cleared to permit 360° vision to surrounding Trigs.
 2. ~~Cleared by James bearing~~
 3. Trig. Mast & Vanes have been painted white & black respectively.
 4. The Trig. was unpiled/not unpiled, dimensions now being:
 Description of mark: **Steel Plate on Concrete Pillar** should be explicit, e.g. Steel plug, Brass plug, Bolt, Concrete Pillar
 Height of mark: ~~.....~~ m above rock/concrete **1.42** m above G.L.
 Height of Top Vanes to Top Mark/Top pillar plate: **1.44** m Diameter of Vanes (vertical): **0.60** m.
 Height of Cairn: m. Diameter of Cairn: m.
 Length of Mast: **1.53** m. (approximate if not unpiled)

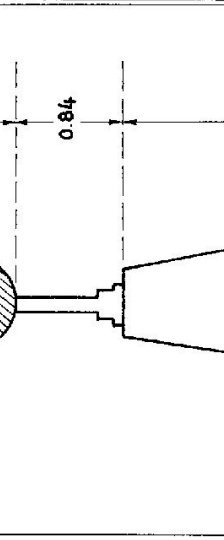

5. A. **S.S.M.** set in conc/rock has been placed/d 4.050 m, bearing **328** °M from Trig/Mast/pillar
 6. A. **T.S. Plug** set in conc/rock has been placed/d 3.570 m, bearing **16** °M from Trig/Mast/pillar
 7. A. set in conc/soil has been placed/d m, bearing °M from Trig. Mast/pillar
 8. A. set in conc/rock has been placed/d m, bearing °M from Trig. Mast/pillar
 9. Connection **SSM** to **T.S. Plug**: **3.192** m, bearing **89** °M
 10. Connection to m, bearing °M
 11. Connection to m, bearing °M
 12. Connection to m, bearing °M
 13. Diff. Ht. **SSM** is **1.435** m. below **Pillar Plate**
 14. Diff. Ht. **T.S. Plug** is **1.800** m. below **Pillar Plate**
 15. Diff. Ht. is m. above
 16. Diff. Ht. is m. above

| Date | Record of Station |
|----------------|-----------------------|
| Sept 76 | Pillar erected |
| | |
| | |
| | |
| | |

Prepared by: **P.R. Edwards**
 Checked: **L.J. Griffin**

STATION Ocean View (Pillar) T.S. 6212

Owners Name... Crown Land Reserve.

Current Occupant.....

Address.....


Access 21-10-1977

Access As Per Previous Access

Not to Scale

Station Diagram

North

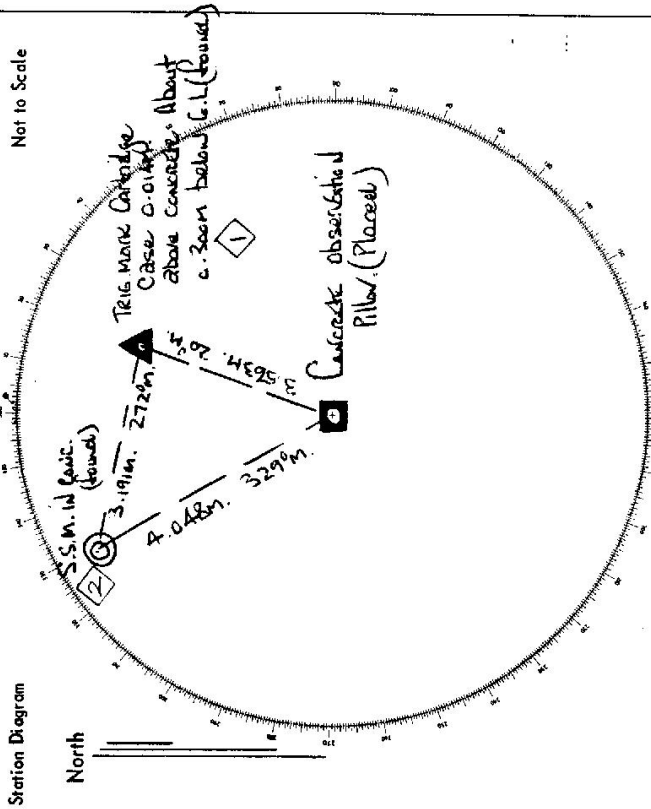

List of Observed Directions:-

| Station | Direction | Station | Direction |
|-----------|-------------|-----------|-------------|
| Station 1 | 0° 00' 00" | Station 2 | 0° 00' 00" |
| Station 2 | 187.14° 02' | Station 3 | 260.38° 17' |
| Station 3 | 317.08° 09" | Station 4 | 356.29° 29" |
| Station 4 | 356.29° 28" | | |

| Station | Direction | Station | Direction |
|---------|-----------|---------|-----------|
| | | | |
| | | | |
| | | | |

CB 30/05/22

CENTRAL MAPPING AUTHORITY

GEODETIC SURVEY OF N.S.W.

GEODETIC STATION RECONNAISSANCE and MAINTENANCE REPORT

Description:

1. Cleared by lances bearing 360° ✓
 Note: Cross out word or words which do not apply
 from Trig. Mast
2. Mast & Vanes have been painted white & black respectively. ✓
3. The station/pillar was unpiled/not unpiled/constructed on 19 dimensions now being:
 Description of mark should be explicit, e.g., S/Steel Pillar Plate, Steel plug, Brass plug, Bolt, G.I. Pipe
 Height of mark^{above} m. ^{below} rock/concrete; Mark is^{above} m. ^{below} G.L.
 Height of Top Vanes to Top Mark/Pillar plate m. Diameter of Vanes (vertical) m.
 Height of Cairn m. Diameter of Cairn m. Name Plate ~~found~~ found/placed. 24.1.74
 Length of Mast m. (approximate if not unpiled)
4. A set in conc/rock has been placed/found, bearing ° M from Mast/Plug/Pillar
5. A set in conc/rock has been placed/found, bearing ° M from Mast/Plug/Pillar
6. A set in conc/rock has been placed/found, bearing ° M from Mast/Plug/Pillar
7. A set in conc/rock has been placed/found, bearing ° M from Mast/Plug/Pillar
8. Action required:

STANDPOINT:

| Mark | Direction | Horiz. Distance | Height Difference | Mark | Direction | Horiz. Distance | Height Difference |
|------|-----------|-----------------|-------------------|------|-----------|-----------------|-------------------|
| | | | above standpt. | | | | above standpt. |
| | | | below standpt. | | | | below standpt. |
| | | | above standpt. | | | | above standpt. |
| | | | below standpt. | | | | below standpt. |
Prepared by: H. C. BORDER

Checked: *[Signature]* 25/9/79. Noted on U.T.M. Card

ST 2733-1

STATION: OCEAN VIEW No.: 6212

MAP SHEET SCALE 1:250 000 COFFS HARBOUR

INSPECTED BY: H.C. BORDER DATE: 24.7.79

AUTHORITY: C.M.A. FIELD BOOK: O1655

Station Diagram

Checked

