

CENTRAL MAPPING AUTHORITY


GEODETIC SURVEY OF N.S.W.
 GEODETIC STATION RECONNAISSANCE and MAINTENANCE REPORT

STATION: **AMUNGULA (ACT)** No.: **622**

MAP SHEET SCALE: 1:250 000
 AUTHORITY: **CMA**

INSPECTED BY: **W MILLER** DATE: **12-5-78**

FIELD BOOK:

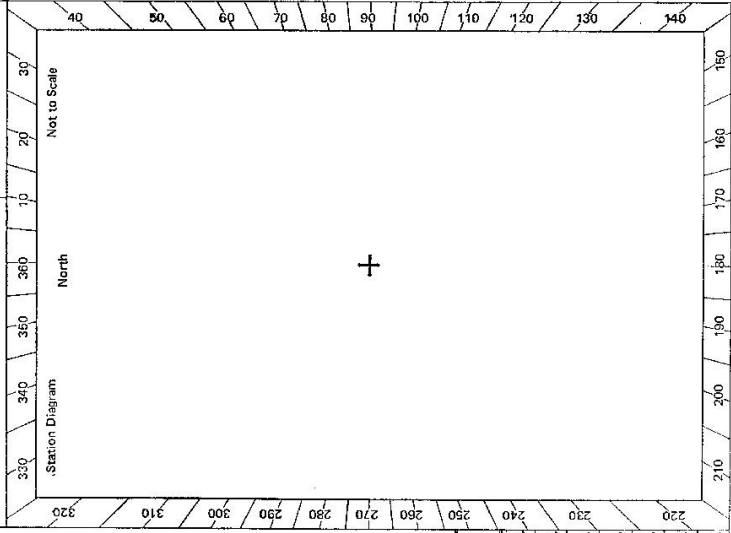

- Description:
- Cleared by lanes bearing..... *Note: Cross out word or words which do not apply*
 1. **Not Cleared**..... *See above*..... *from Trig. Mast*
 2. **Mast & Vanes have been painted white & black respectively.** *on high in forest*
 - The station/~~pillar~~ was ~~applied~~/not unpainted/constructed on..... *19*..... *dimensions now being:*
 Description of mark..... should be explicit, e.g., S/Steel Pillar Plate, Steel plug, Brass plug, Bolt, G.I. Pipe
 Height of mark..... ^{above} _{below} rock/concrete; Mark is..... ^{above} _{below} G.L.
 Height of Top Vanes to Top Mark/Pillar plate..... m. Diameter of Vanes (vertical)..... m. *No Vanes*
 Height of Cairn..... *1.5* m. Diameter of Cairn..... *5* m. *Name Plate found/not found/placed.*
 Length of Mast..... *2* m. (approximate if not unpainted) *Mast has rotted.*
 - A..... set in conc/rock has been placed/found, bearing..... ° M from Mast/Plug/Pillar
 - A..... set in conc/rock has been placed/found, bearing..... ° M from Mast/Plug/Pillar
 - A..... set in conc/rock has been placed/found, bearing..... ° M from Mast/Plug/Pillar
 - A..... set in conc/rock has been placed/found, bearing..... ° M from Mast/Plug/Pillar
 - Action required: *Station is surrounded by 6m high pine trees. Cairn is not only found.*


STANDPOINT:			
Mark	Horiz. Distance	Height Difference	Direction
		above standpt.	
		below standpt.	
		above standpt.	
		below standpt.	
Prepared by: *[Signature]* Checked: *[Signature]* Noted on U.T.M. Card

GS 24

STATION **AMUNGULA 622**

Owner's Name: **KOWEN FOREST ACT**
 Address: **OFF SUTTON ROAD**
Near Gumbabayan
 Phone:
 Current Occupant:
 Address:
 Phone: **12-5-78**

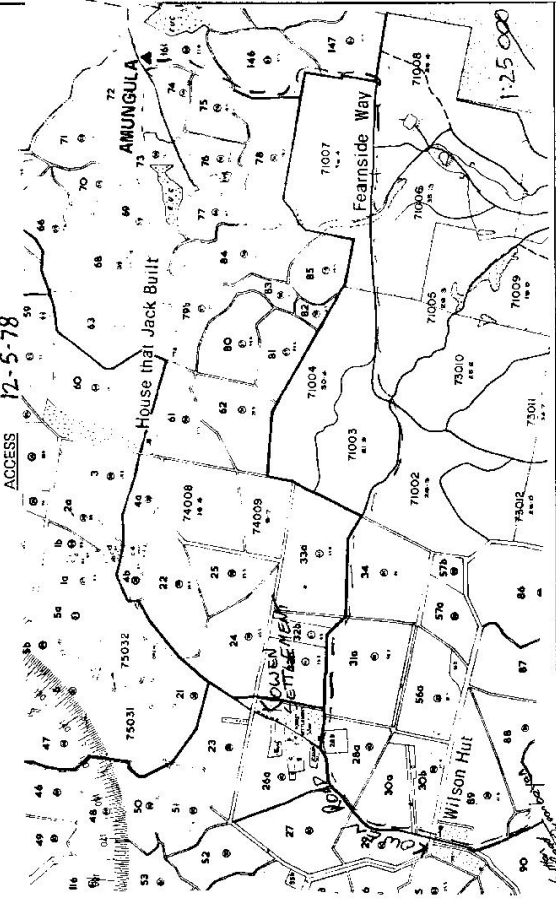


See 1:25,000 map when printed

Record of Station

Date: **15-12-78**
 Visited by: **W. Miller** - *trip is to see until trees cut down - say 40 years*
 Surveyed by: **Russ T. 225**

8: 2733-2 D. West, Government Printer

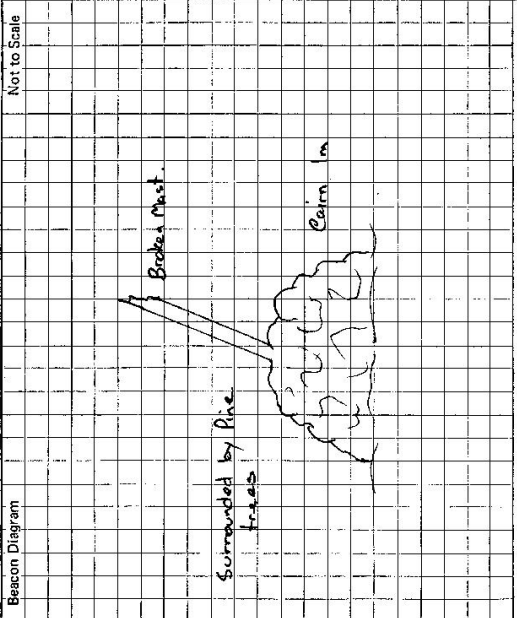

This section to be completed by officer constructing pillar.

Original station mark found/not found.
 Description of mark:
 Original beacon found/not found.
 Description of beacon:
 Height Top of Vanes to Top Mark m.
 Height of mark m. above G.L. below
 Diameter of Vanes m. Height of Cairn m.
 Original Beacon has/not been destroyed by me.