

CENTRAL MAPPING AUTHORITY

GEODETIC SURVEY OF M.S.B. GEODETIC STATION RECONNAISSANCE and MAINTENANCE REPORT

STATION: GOODOOGA G.S. No.: 6220

MAP SHEET SCALE 1:250 000


INSPECTED BY: K. ZAHRA

DATE: 25-8-78

AUTHORITY: C M A

FIELD BOOK: 157215

- Description:
- Note: Cross out word or words which do not apply
- Cleared by lanes bearing..... from Trig. Mast
 - Mast & Vanes have been painted white & black-respectively. N. A.
 - The station/pillar was applied/not applied/constructed on..... 29th Aug..... 1978..... dimensions now being:
 Description of mark..... G.I. Pipe..... should be explicit, e.g., S/Steel Pillar Plate, Steel plug, Brass plug, Bolt, G.I. Pipe
 Height of mark..... 0.93..... m. above ^{below} rock/concrete; Mark is ^{above} ~~below~~ G.L.
 Height of Top Vanes to Top Mark/Pillar plate m. Diameter of Vanes (vertical)..... m.
 Height of Cairn..... m. Diameter of Cairn..... m. Name Plate-found/not-found/placed.
 Length of Mast..... m. (approximate if not unplied)
 - A..... set in conc/rock has been placed /found, bearing.....° M from Mast/Plug/Pillar
 - A..... set in conc/rock has been placed /found, bearing.....° M from Mast/Plug/Pillar
 - A..... set in conc/rock has been placed /found, bearing.....° M from Mast/Plug/Pillar
 - A..... set in conc/rock has been placed /found, bearing.....° M from Mast/Plug/Pillar
 - Action required: A Bench mark to be set in conc/rock for..... R.O.....

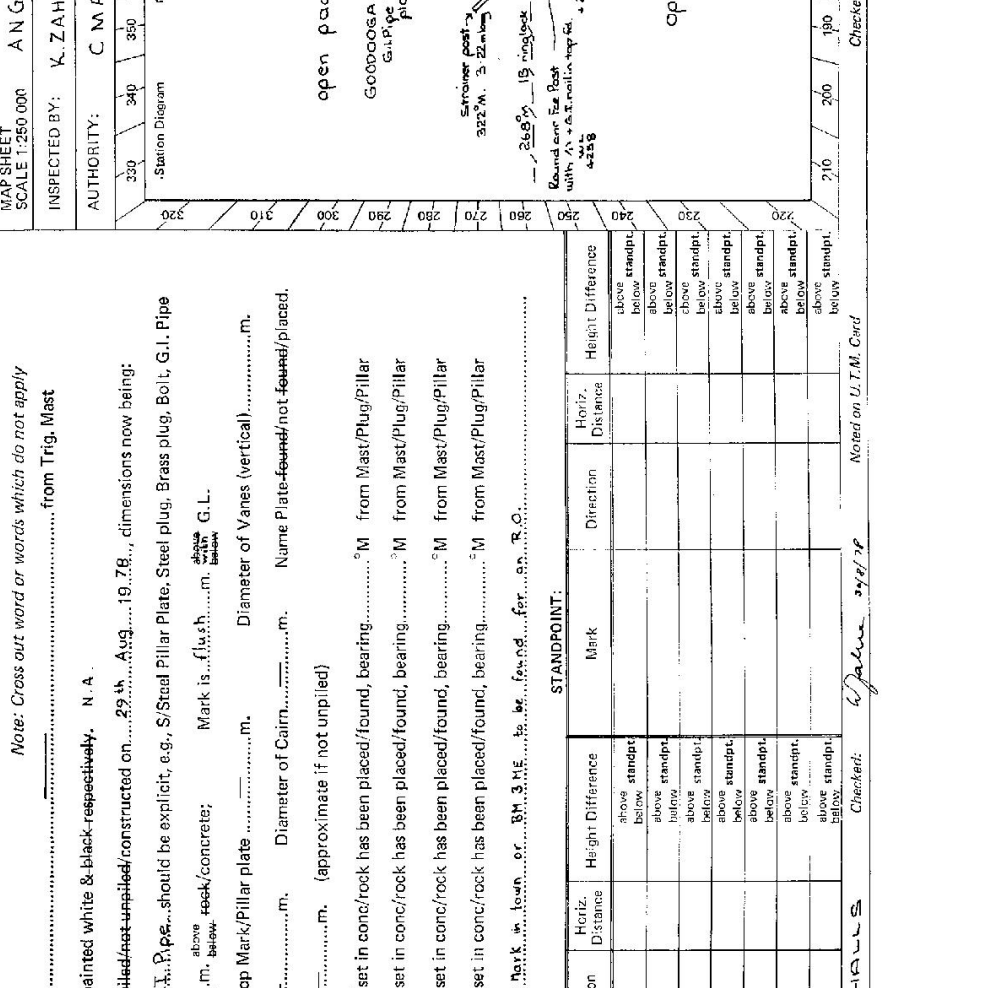

STANDPOINT:


Mark	Direction	Horiz. Distance	Height Difference	Mark	Direction	Horiz. Distance	Height Difference
			above standpt.				above standpt.
			below				below
			above standpt.				above standpt.
			below				below
Prepared by: D. HALLS
 Checked: K. Zahra 24/8/78
 Noted on U.T.M. Card

Checked

CARD 1 of 2 CARDS
 No.: 6220
 STATION: GOODDOGA GS

MAP SHEETS
 SCALE 1:250 000
 ANGLE DOOL
 INSPECTED BY: J Sutton
 DATE: 29th April 1991
 FIELD BOOK: 1974

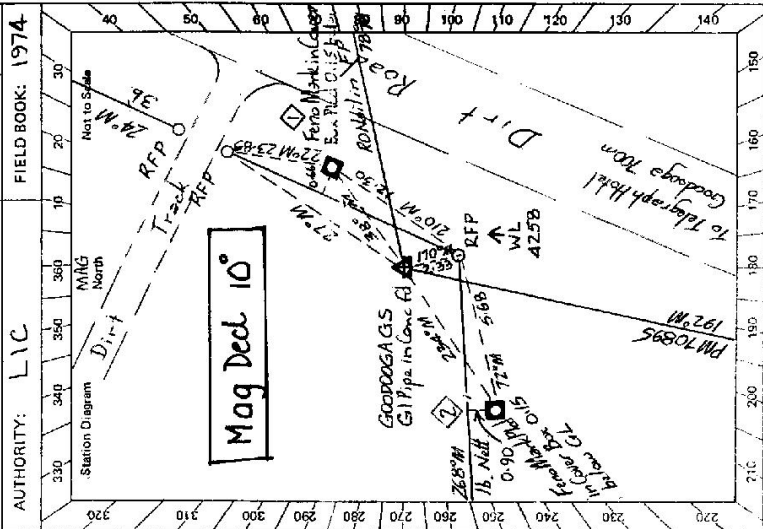

CENTRAL MAPPING AUTHORITY
 GEODETIC SURVEY OF N.S.W.
 GEODETIC STATION RECONNAISSANCE and MAINTENANCE REPORT

Description:
 Note: Cross out word or words which do not apply

- Cleared by lines bearing Cleared 360° from Trig. Mast
- ~~Mast & Vanes have been painted white & black respectively.~~
- The station/~~pillar~~ was unpiled/~~not unpiled~~/~~constructed~~ on 29th April 1991, dimensions now being:
 Description of mark GI Pipe in Conc should be explicit, e.g., S/Steel Pillar Plate, Steel Plug, Brass plug, Bolt, G.I. Pipe
 Height of mark 0.224 m. above ~~feet~~/~~concrete~~/~~soil~~/~~G.L.~~ Mark is 0.020 m. above ~~soil~~/~~G.L.~~
 Height of Top Vanes to Top Mark/Pillar platem. Diameter of Vanes (vertical)m.
 Height of Cairnm. Diameter of Cairnm. ~~Name Plate found/not found/placed~~
 Length of Mastm. (approximate if not unpiled)
- Feno Mark in Cover set in ~~soil~~ Box has been placed ~~found~~ bearing 228° 30' M from ~~Mast/Plug/Pillar~~ GI Pipe fd
- Feno Mark in Cover Box set in ~~soil~~ Soil has been placed ~~found~~ bearing 234° 00' M from ~~Mast/Plug/Pillar~~ GI Pipe fd
- A set in conc./rock has been placed/ found, bearing° M from Mast/Plug/Pillar
- A set in conc./rock has been placed/ found, bearing° M from Mast/Plug/Pillar

8. Action required:

Mark	Direction	Horiz. Distance	Height Difference	Mark	Direction	Horiz. Distance	Height Difference
PM 70895	0° 00' 00"		below standpt.	PM 70895	0° 00' 00"		above standpt.
Feno Mark in Cover Box	244° 01' 24"	6.738	0.224	Gooddoga GS GI Pipe	26° 30' 49"	10.596	0.091
Feno Mark in Cover Box	208° 26' 29"	10.593	0.091	Feno Mark in Cover Box	32° 56' 08"	16.657	0.134
Ro Nail in Fee Post	248° 31' 39"		below standpt.	Ro Nail in Fee Post	249° 51' 11"		above standpt.
			below standpt.				above standpt.
			below standpt.				above standpt.
STANDPOINT: GI Pipe in Conc. fd. STANDPOINT: Feno Mark in Cover Box Pied RMI

Prepared by: J Sutton 29.4.91 Checked: 6 Oct 30.4.91
 Normal on U.T.M. Grid

Checked

407

CARD 2 OF 2 CARDS

GEODETTIC SURVEY OF A.S.M.

CENTRAL MAPPING AUTHORITY

GEODETTIC STATION RECONNAISSANCE and MAINTENANCE REPORT

- Description:**
- Note: Cross out word or words which do not apply*
- Cleared by lanes bearing..... from Trig. Mast
 - Mast & Vanes have been painted white & black respectively.
 - The station/pillar was unpiled/not unpiled/constructed on..... 19....., dimensions now being:
 - Description of mark..... should be explicit, e.g., S/Steel Pillar Plate, Steel plug, Brass plug, Bolt, G.I. Pipe
 - Height of mark..... m. above rock/concrete; Mark is..... m. above G.L.
 - Height of Top Vanes to Top Mark/Pillar plate..... m. Diameter of Vanes (vertical)..... m.
 - Height of Cairn..... m. Diameter of Cairn..... m. Name Plate found/not found/placed.
 - Length of Mast..... m. (approximate if not unpiled)
 - A..... set in conc/rock has been placed/found, bearing.....° M from Mast/Plug/Pillar
 - A..... set in conc/rock has been placed/found, bearing.....° M from Mast/Plug/Pillar
 - A..... set in conc/rock has been placed/found, bearing.....° M from Mast/Plug/Pillar
 - A..... set in conc/rock has been placed/found, bearing.....° M from Mast/Plug/Pillar
8. Action required:.....

STANDPOINT: *Feno Mark in Cover Box Piled RM2* STANDPOINT:

Mark	Direction	Horiz. Distance	Height Difference	Mark	Direction	Horiz. Distance	Height Difference
PM 70825	0° 00' 00"		above standpt.				above standpt.
Feno Mark in Cover Box	217° 37' 23"	16.655	below standpt.				below standpt.
Goodloga G.S.G. Pipe	224° 24' 25"	6.237	above standpt.				above standpt.
Ro Nail in Tee Post	248° 15' 34"		below standpt.				below standpt.

Prepared by: *J. Sutton* 29.4.91
 Checked: *6 Jan 30 4.91*
 Noted on U.T.M. Grid

STATION: *GOODLOGA G.S.* No.: *6220*

MAP SHEETS *ANGLE DOOL* SCALE 1:100 000

SCALE 1:250 000 *GOODLOGA*

INSPECTED BY: *J. SUTTON* DATE: *29th April 1991*

AUTHORITY: *L.I.C.* FIELD BOOK: *1974*

Not to Scale

Checked