

GEODETIC SURVEY OF M.S.W.

CENTRAL MAPPING AUTHORITY

GEODETIC STATION RECONNAISSANCE and MAINTENANCE REPORT

STATION: PILLIGA G.S. No.: TS 6222


MAP SHEET SCALE 1:250 000 NARRABRI

INSPECTED BY: D. HALLS. DATE: 4-9-1978

AUTHORITY: C.M.A. FIELD BOOK: 1572/11

Description: *Note: Cross out word or words which do not apply*

1. Cleared by lances bearing..... from Trig. Mast
2. Mast & Vanes have been painted white & black respectively.....
3. The station/pillar was ~~applied/not applied~~ constructed on A.S., dimensions now being: 19.78....., dimensions now being:
- Description of mark..... G.I. Pipe..... should be explicit, e.g., S/Steel Pillar Plate, Steel plug, Brass plug, Bolt, G.I. Pipe
- Height of mark..... 0.520.....m. ^{above} ~~below~~ rock/concrete; Mark is m. ^{above} ~~below~~ G.L.
- Height of Top Vanes to Top Mark/Pillar plate.....m. Diameter of Vanes (vertical).....ft.
- Height of Cairn.....m. Diameter of Cairn.....m. Name Plate found/~~not found~~/placed.
- Length of Mast.....m. (approximate if not unplied)
4. A..... set in conc./rock has been placed/found, bearing.....° M from Mast/Plug/Pillar
5. A..... set in conc./rock has been placed/found, bearing.....° M from Mast/Plug/Pillar
6. A..... set in conc./rock has been placed/found, bearing.....° M from Mast/Plug/Pillar
7. A..... set in conc./rock has been placed/found, bearing.....° M from Mast/Plug/Pillar
8. Action required:..... R. mone. suitable. R.O. should be placed.

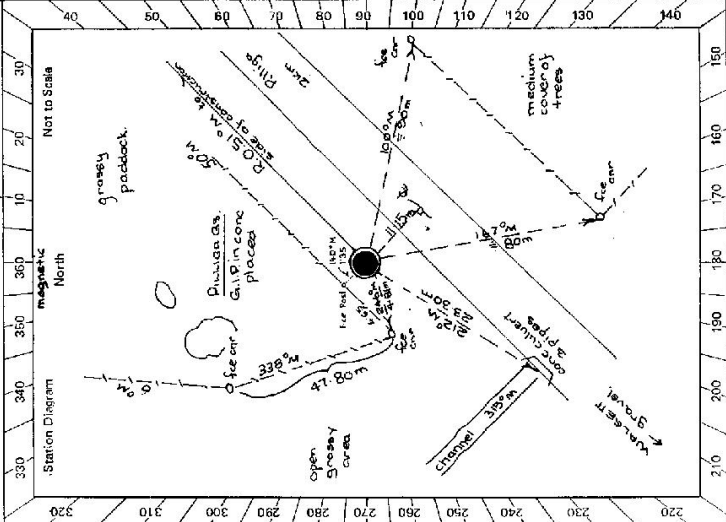

STANDPOINT:

Mark	Direction	Horiz. Distance	Height Difference	Mark	Direct on	Horiz. Distance	Height Difference
			above standpt.				above standpt.
			below				below
			above standpt.				above standpt.
			below				below
Prepared by: D. Halls. Checked: D. Halls 12/9/78. Noted on U.I.M. Card

