

GS

<p>STATION LIGHTNING RIDGE G.S. 6224</p>	<p>Owner's Name: Address: Phone:</p> <p>Public Land Address: Phone:</p> <p>Current Occupant: Address: Phone:</p> <p>ACCESS 28-8-1978 *Access Report of/10.....was found suitable/unusable. ORIGINAL</p>	
<p>Not to Scale</p> <p>Beacon Diagram</p>	<p>This section to be completed by officer constructing pillar.</p> <p>Original station mark found/not found.</p> <p>Description of mark:</p> <p>Original beacon found/not found.</p> <p>Description of beacon:</p> <p>Height Top of Vanes to Top Mark.....m.</p> <p>Height of mark.....m. above G.L. below</p> <p>Diameter of Vanes.....m. Height of Cairn.....m.</p> <p>Original Beacon has/has not been destroyed by me.</p>	
		<p>Date</p> <p>Record of Station</p>

8r 2738-2 D. West, Government Printer

GEODETTIC SURVEY OF N.S.W.

CENTRAL MAPPING AUTHORITY

GEODETTIC STATION RECONNAISSANCE and MAINTENANCE REPORT

STATION: LIGHTNING RIDGE G.S No.: 6224


MAP SHEET SCALE 1:250 000 ANGLEDOOD

INSPECTED BY: D. FREDRIKSEN DATE: 3/7/79

AUTHORITY: C. M. A. FIELD BOOK: /572

Description: *Note: Cross out word or words which do not apply*

1. Cleared by lanes bearing..... from Trig. Mast
2. Mast & Vanes have been painted white & black respectively.
3. The station/pillar was unpiled/not unpiled/constructed on.....19....., dimensions now being:
Description of mark G.I.P.....should be explicit, e.g. S/Steel Pillar Plate, Steel plug, Brass plug, Bolt, G.I. Pipe
Height of mark.....m. above below rock/concrete; Mark is.....m. above below G.L.
- Height of Top Vanes to Top Mark/Pillar plate.....m. Diameter of Vanes (vertical).....m.
- Height of Cairn.....m. Diameter of Cairn.....m. Name Plate found/not found/placed.
- Length of Mast.....m. (approximate if not unpiled)
4. A.....set in conc/rock has been placed/found, bearing.....°M from Mast/Plug/Pillar
5. A.....set in conc/rock has been placed/found, bearing.....°M from Mast/Plug/Pillar
6. A.....set in conc/rock has been placed/found, bearing.....°M from Mast/Plug/Pillar
7. A.....set in conc/rock has been placed/found, bearing.....°M from Mast/Plug/Pillar
8. Action required:.....

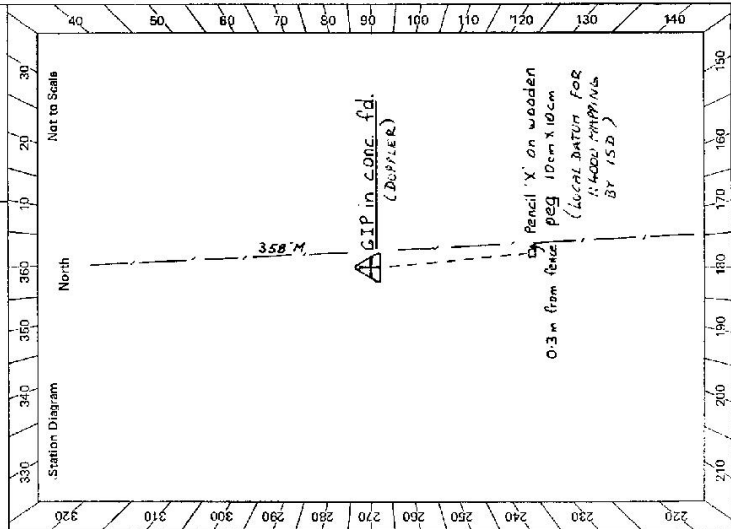

Mark	Direction	Horiz. Distance	Height Difference	Mark	Direction	Horiz. Distance	Height Difference
Wooden peg	173 1/2 Mag	52.05	above standpt.	G.I.P. in conc.	357 Mag	52.05	above standpt.
			below standpt.				below standpt.
			above standpt.				above standpt.
			below standpt.				below standpt.
			above standpt.				above standpt.
			below standpt.				below standpt.
			above standpt.				above standpt.
			below standpt.				below standpt.

STANDPOINT: G.I.P. in conc. fd. STANDPOINT: Wooden peg in soil fd.

Prepared by: D. FREDRIKSEN 4/9/79 Checked: *af* Noted on U.T.M. Card

LAND INFORMATION CENTRE

GEODETIC SURVEY OF A.S.W.

GEODETIC STATION RECONNAISSANCE and MAINTENANCE REPORT

Description:

1. Cleared by Janes bearing.....
 Note: Cross out word or words which do not apply
 from Trig. Mast

2. Mast & Vanes have been painted white & black respectively.

3. The station/pillar was unpiled/not unpiled/constructed on.....19..... dimensions now being:

Description of mark.....should be explicit, e.g., S/Steel Pillar Plate, Steel plug, Brass plug, Bolt, G.I. Pipe

Height of mark.....m. ^{above} rock/concrete; Mark is.....m. ^{above} G.L. _{below}

Height of Top Vanes to Top Mark/Pillar platem. Diameter of Vanes (vertical).....m.

Height of Cairn.....m. Diameter of Cairn.....m. Name Plate found/not found/placed.

Length of Mastm. (approximate if not unpiled)

4. A.....set in conc/rock has been placed/found, bearing.....°M from Mast/Plug/Pillar

5. A.....set in conc/rock has been placed/found, bearing.....°M from Mast/Plug/Pillar

6. A.....set in conc/rock has been placed/found, bearing.....°N from Mast/Plug/Pillar

7. A.....set in conc/rock has been placed/found, bearing.....°M from Mast/Plug/Pillar

8. Action required:.....

STANDPOINT:

STANDPOINT:

Mark	Direction	Horiz. Distance	Height Difference	Mark	Direction	Horiz. Distance	Height Difference
			above standpt.				above standpt.
			below.				below.
			above standpt.				above standpt.
			below.				below.
Prepared by: *G Ford* 19/4/91

Checked: *A.L. Hill* 21/5/91

Checked

STATION: *LIGHTNING RIDGE CS* TS No: *6224*

MAP SHEET SCALE *1:25000* *LIGHTNING RIDGE 100' 000*

INSPECTED BY: *G FORD* DATE: *MARCH 1991*

AUTHORITY: *L. I. C.* FIELD BOOK:

CARD 2 of 2 CARDS

GEODETTIC SURVEY OF A.S.W.


CENTRAL MAPPING AUTHORITY

GEODETTIC STATION RECONNAISSANCE and MAINTENANCE REPORT

STATION: LIGHTNING RIDGE No.: 6224

MAP SHEETS SCALE 1:100 000 LIGHTNING RIDGE
SCALE 1:250 000 ANGLE DOOL
INSPECTED BY: J. Sutton DATE: 23rd April 1991

AUTHORITY: LIC FIELD BOOK: 1969
1974

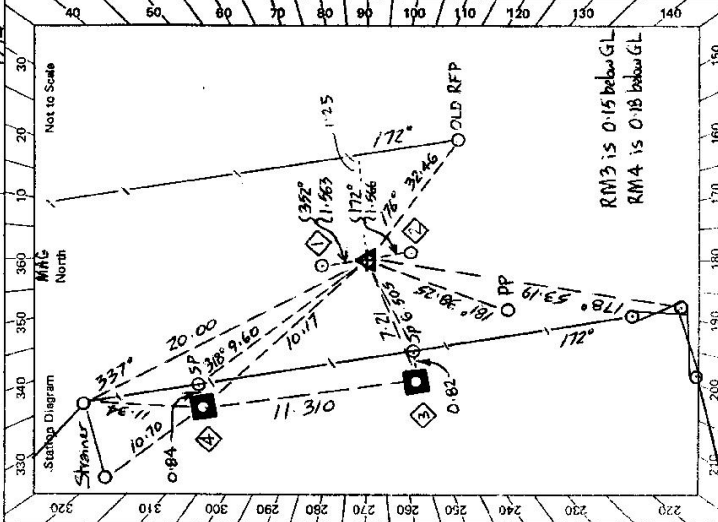

- Description: Note: Cross out word or words which do not apply
- Cleared by lanes bearing..... from Trig, Mast
 - Mast & Vanes have been painted white & black respectively.
 - The station/pillar was unpiled/not unpiled/constructed on..... 19....., dimensions now being: Description of mark..... should be explicit, e.g., S/Steel Pillar Plate, Steel plug, Brass plug, Bolt, G.I. Pipe
 - Height of mark.....m. above rock/concrete; Mark is.....m. above below G.L.
 - Height of Top Vanes to Top Mark/Pillar plate.....m. Diameter of Vanes (vertical).....m.
 - Height of Cairn.....m. Diameter of Cairn.....m. Name Plate found/not found/placed.
 - Length of Mast.....m. (approximate if not unpiled)
 - A.....set in conc/rock has been placed/found, bearing.....°M from Mast/Plug/Pillar
 - A.....set in conc/rock has been placed/found, bearing.....°M from Mast/Plug/Pillar
 - A.....set in conc/rock has been placed/found, bearing.....°M from Mast/Plug/Pillar
 - A.....set in conc/rock has been placed/found, bearing.....°M from Mast/Plug/Pillar

Action required:.....

STANDPOINT: Feno Mark in Cover Box Piled RMA STANDPOINT:

Mark	Direction	Horizontal Distance	Vertical Height Difference	Mark	Direction	Horizontal Distance	Vertical Height Difference
PM 70879	0° 00' 00"	105.893	22.584				
GL Star Picket Piled RMA	169° 18' 17"	9.032					
Lightning Ridge GIP	74° 35' 12.8"	10.173	0.061				
GL Star Picket RMA	179° 38' 27.5"	11.396					
Feno Mark RMA	213° 47' 17.5"	11.206	0.032				
RD Fence Post	235° 11' 21.2"						

Prepared by: J. Sutton Checked: 6 October 27.4.91