

CENTRAL MAPPING AUTHORITY

GEODETIC SURVEY OF N.S.W.

GEODETIC STATION RECONNAISSANCE and MAINTENANCE REPORT

Description:

1. Cleared by lanes bearing..... Note: Cross out word or words which do not apply  
 from Trig. Mast

2. Mast & Vanes have been painted white & black respectively. N.A.

3. The station/pillar was unapplied/not-applied/constructed on 24<sup>th</sup> August 1978, dimensions now being:

Description of mark..... should be explicit, e.g. S/Steel Pillar Plate, Steel plug, Brass plug, Bolt, G.I. Pipe

Height of mark..... m. above rock/concrete; Mark is..... m. above below

Height of Top Vanes to Top Mark/Pillar plate ..... m. Diameter of Vanes (vertical)..... m.

Height of Cairn..... m. Diameter of Cairn..... m. Name Plate found/not-found/placed.

Length of Mast ..... m. (approximate if not unplied)

4. A..... set in conc./rock has been placed/found, bearing.....° M from Mast/Plug/Pillar

5. A..... set in conc./rock has been placed/found, bearing.....° M from Mast/Plug/Pillar

6. A..... set in conc./rock has been placed/found, bearing.....° M from Mast/Plug/Pillar

7. A..... set in conc./rock has been placed/found, bearing.....° M from Mast/Plug/Pillar

8. Action required:.....

STANDPOINT:


Mark	Direction	Horiz. Distance	Height Difference	Mark	Direction	Horiz. Distance	Height Difference
			above standpt.				above standpt.
			below standpt.				below standpt.
			above standpt.				above standpt.
			below standpt.				below standpt.
			above standpt.				above standpt.
			below standpt.				below standpt.
			above standpt.				above standpt.
			below standpt.				below standpt.

Prepared by: D. HALLS

Checked: W. Palmer 30/4/78

Noted on U.T.M. Card

SI 2733-1

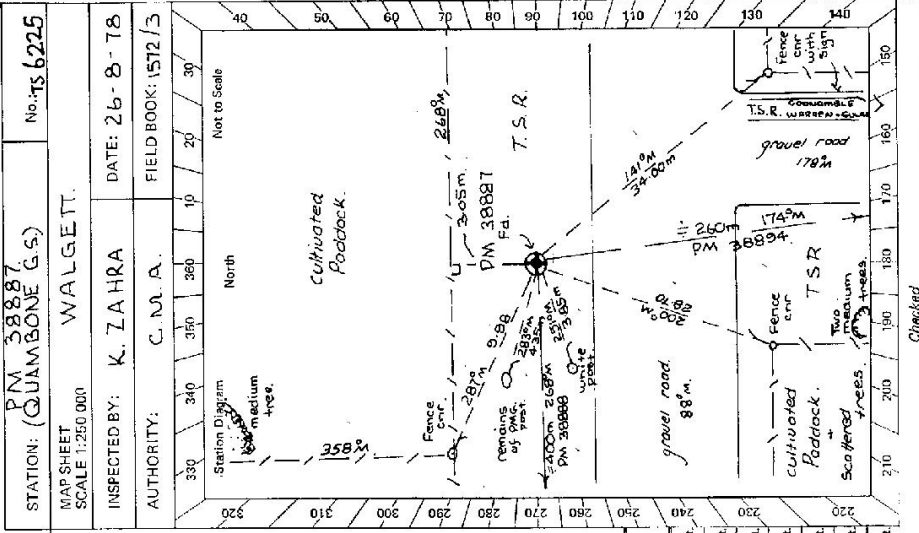

Checked

