

CENTRAL MAPPING AUTHORITY  
 GEODETTIC SURVEY OF N.S.W.  
 Batch Id  
 GEODETTIC STATION RECONNAISSANCE and MAINTENANCE REPORT 1509

STATION: NYNGAN G.S. No: 6226  
 MAP SHEET SCALE 1:250 000 NYNGAN  
 INSPECTED BY: K. ZAHRA DATE: 26-8-78  
 AUTHORITY: C.M.A. FIELD BOOK: 1572/2

Description:  
 Notes: Cross out word or words which do not apply

1. Cleared by lanes bearing..... from Trig. Mast
2. Mast & Vanes have been painted white & black respectively. N.P.
3. The station/pillar was ~~erected~~ ~~not erected~~ / constructed on ~~2.6m~~ ~~Aug. 1978~~ ....., dimensions now being:  
 Description of mark..... S.I. Pipe..... should be explicit, e.g., S/Steel Pillar Plate, Steel plug, Brass plug, Bolt, G.I. Pipe  
 Height of mark..... <sup>above</sup> 0.36 m..... <sup>below</sup> rock/concrete; Mark is. ~~Flashed~~ ..... m..... <sup>above</sup> ~~below~~ G.L.  
 Height of Top Vanes to Top Mark/Pillar plate ..... m..... Diameter of Vanes (vertical)..... m.  
 Height of Cairn..... m..... Diameter of Cairn..... m..... Name Plate ~~found~~ / ~~not found~~ / ~~placed~~.  
 Length of Mast ..... m..... (approximate if not piled)
4. A..... set in conc/rock has been placed/ found, bearing..... °M from Mast/Plug/Pillar
5. A..... set in conc/rock has been placed/ found, bearing..... °M from Mast/Plug/Pillar
6. A..... set in conc/rock has been placed/ found, bearing..... °M from Mast/Plug/Pillar
7. A..... set in conc/rock has been placed/ found, bearing..... °M from Mast/Plug/Pillar
8. Action required.....

STANDPOINT:

Mark	Direction	Horiz. Distance	Height Difference	Mark	Direction	Horiz. Distance	Height Difference
			above standpt				above standpt
			below				below
			above standpt				above standpt
			below				below
Prepared by: D. HALS. Checked: *[Signature]* 29/8/78 Noted on U.T.M. Card

8: 2753-2 D. West Government Printer Beacon Diagram Not to Scale	STATION <b>NYNGAN C.S. TS 6226</b> Owner's Name: <b>NYNGAN SHARE</b> Address: <b>NYNGAN</b> Phone: <b>ACCESS 26-8-1478</b> Current Occupant: <b>Dept. of Aviation</b> Address: <b>NYNGAN G.S.</b> Phone: <b>ACCESS 26-8-1478</b> Access Report of: <b>19</b> was found suitable/unsuitable. original.	
This section to be completed by officer constructing pillar. Original station mark found/not found. Description of mark: ..... Original beacon found/not found. Description of beacon: ..... Height Top of Vanes to Top Mark ..... m. Height of mark ..... m. above G.L. below Diameter of Vanes ..... m. Height of Cairn ..... m. Original Beacon has/has not been destroyed by me.	Date <b>4/94</b> Record of Station <b>Reported damaged by grader</b>	

NYN - 6226

STATION: NYNGAN  
 MAP SHEET SCALE 1:250 000  
 INSPECTED BY: A. Sivertsen  
 AUTHORITY: LIC  
 DATE: 22.7.94  
 FIELD BOOK:

STATION: NYNGAN No. 6226  
 MAP SHEET SCALE 1:250 000  
 INSPECTED BY: A. Sivertsen  
 AUTHORITY: LIC  
 DATE: 22.7.94  
 FIELD BOOK:

Batch 1509

GEODETIC SURVEY OF A.S.M.

LAND INFORMATION CENTRE

GEODETIC STATION RECONNAISSANCE and MAINTENANCE REPORT

Description: Note: Cross out word or words which do not apply

1. Cleared by lanes bearing blocked to N by levee ..... from Trig. Mast

2. Mast & Vanes have been painted white & black respectively. NO BEACON

3. The station/pillar was unpiled/not unpiled/constructed on 2.2 JULY 1994....., dimensions now being: Description of mark. G.I. Pipe in Conc should be explicit, e.g. S/Steel Pillar Plate, Steel plug, Brass plug, Bolt, G.I. Pipe

Height of mark.....m. above rock/concrete; Mark is.....m. above G.L.

Height of Top Vanes to Top Mark/Pillar plate.....m. Diameter of Vanes (vertical).....m.

Height of Cairn.....m. Diameter of Cairn.....m. Name Plate found/not found/placed.

Length of Mast.....m. (approximate if not unpiled)

4. A. RM 1 G.I. Pipe set in conc/rock has been placed/formed, bearing 253° M from Mast/Plug/Pillar are 0.2m

5. A. RM 2 " set in conc/rock has been placed/formed, bearing 340° M from Mast/Plug/Pillar below G.L.


6. A. RM 3 " set in conc/rock has been placed/formed, bearing 57° M from Mast/Plug/Pillar

7. A..... set in conc/rock has been placed/formed, bearing.....° M from Mast/Plug/Pillar

8. Action required:.....

STANDPOINT: NYNGAN			STANDPOINT: RM 3				
Mark	Direction	Horiz. Distance	Height Difference	Mark	Direction	Horiz. Distance	Height Difference
NYNGAN RES (P)	0 00 00		above standpt.	NYNGAN RES (P)	0 00 00		above standpt.
RM 1	58 56 10	6.998	0.141 above standpt.	NYNGAN RES (P)	41 14 30	2.864	0.165 above standpt.
RM 2	143 44 10	6.831	0.098 above standpt.	RM 1	53 46 35	9.766	0.023 above standpt.
RM 3	221 14 20	2.865	0.162 above standpt.	RM 2	119 27 40	6.814	0.066 above standpt.
			below standpt.				below standpt.
			above standpt.				above standpt.
			below standpt.				below standpt.
			above standpt.				above standpt.
			below standpt.				below standpt.

Prepared by: A. Sivertsen Checked: A. Sivertsen  
 Noted on U.T.M. Card  
 S: 2735-1

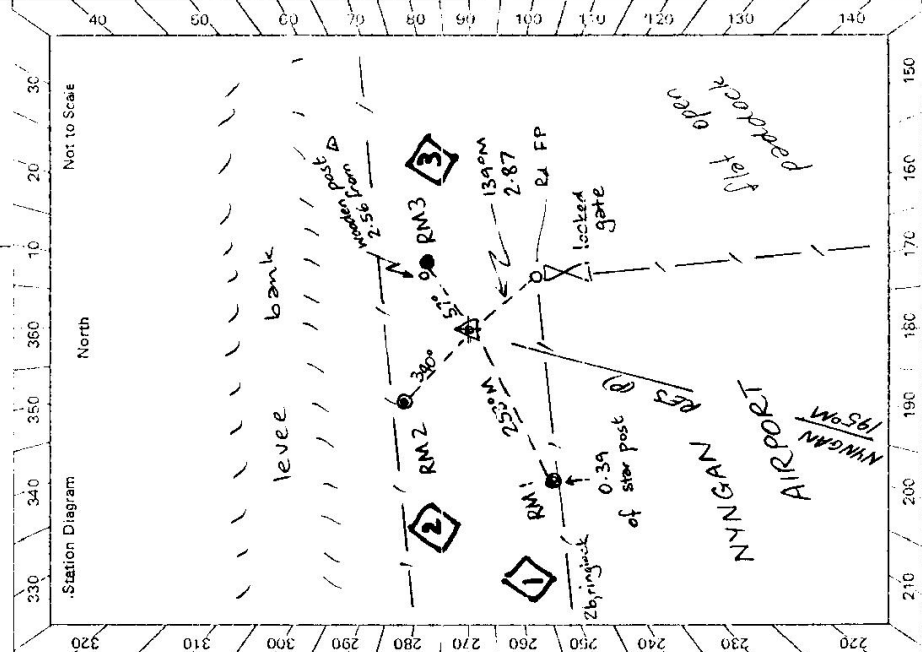

St: 2733-2 D. West. Government Printer

Beacon Diagram 	STATION <b>NYNGAN</b> <span style="float: right;"><b>TS 6226</b></span>
Owner's Name: <b>Dick Richards</b> Address: ..... Phone: <b>068 321076</b>	Also: <b>Bill Parry</b> Address: <b>Butcher in NYNGAN</b> Phone: .....
TRAVEL : <b>20 mins from NYNGAN ACCESS</b> Access Report of <b>22.7.1994</b> was found suitable/unsuitable. <b>2nd dry JULY 1994</b>	0.0 <b>At J MITCHELL HWY and road to AIRPORT in NYNGAN</b> Take road to AIRPORT / CANOMBA/
0.05 <b>Cross rd</b> 0.6 <b>Pass AIRPORT entrance on R</b> 1.7 <b>Turn R off road &amp; head to iron gate</b> 1.8 <b>Thru gate &amp; go over levee</b> 1.9 <b>Pass dam on R</b> 2.1 <b>Thru wire gate then follow laneway</b> 2.35 <b>NYNGAN GS</b>	* <b>You can also go into Airport area at 0.6 and come up to fence car on sketch.</b>
This section to be completed by office: constructing pillar. Original station mark found/not found. Description of mark: ..... Original beacon found/not found. Description of beacon: ..... Height Top of Vanes to Top Mark ..... m. Height of mark ..... m. above G.L. below Diameter of Vanes ..... m. Height of Cairn ..... m. Original Beacon has/has not been destroyed by me.	Date ..... Record of Station .....