

GEODETTIC SURVEY OF N.S.W.

CENTRAL MAPPING AUTHORITY

GEODETTIC STATION RECONNAISSANCE and MAINTENANCE REPORT

- Description: *Note: Cross out word or words which do not apply*
- Cleared by vanes bearing..... from Trig. Mast
  - Mast & Vanes have been painted white & black respectively.
  - The station/pillar was unpiled/not unpiled/constructed on..... 19....., dimensions now being:
    - Description of mark..... should be explicit, e.g., S/Steel Pillar Plate, Steel plug, Brass plug, Bolt, G.I. Pipe
    - Height of mark..... m. <sup>above</sup>/<sub>below</sub> rock/concrete; Mark is..... m. <sup>above</sup>/<sub>below</sub> G.L.
    - Height of Top Vanes to Top Mark/Pillar plate..... m. Diameter of Vanes (vertical)..... m.
    - Height of Cairn..... m. Diameter of Cairn..... m. Name Plate found/not found/placed.
    - Length of Mast..... m. (approximate if not unpiled)
  - A..... set in conc/rock has been placed/found, bearing.....° M from Mast/Plug/Pillar
  - A..... set in conc/rock has been placed/found, bearing.....° M from Mast/Plug/Pillar
  - A..... set in conc/rock has been placed/found, bearing.....° M from Mast/Plug/Pillar
  - A..... set in conc/rock has been placed/found, bearing.....° M from Mast/Plug/Pillar
  - Action required:.....

STANDPOINT:

Mark	Direction	Horiz. Distance	Height Difference	Mark	Direction	Horiz. Distance	Height Difference
			above standpt.				above standpt.
			below standpt.				below standpt.
			above standpt.				above standpt.
			below standpt.				below standpt.
Prepared by: ..... Checked: ..... Noted on U.T.M. Card

SR 2733-1

STATION: ANICHAN **GILLAR** No.: 623

MAP SHEET SCALE 1:250 000 SYDNEY

INSPECTED BY: W. M'GILLIVRAY DATE: 23/12/80

AUTHORITY: CMA FIELD BOOK:

Checked

2733-2 D. West, Government Printer	STATION <b>ANCHAU (P) 623</b>	Owner's Name: ..... Address: ..... Phone: .....  Current Occupant: ..... Address: ..... Phone: .....  ACCESS Access Report of 23/12/1980, was found suitable/unsuitable.	<table border="1" style="width: 100%; border-collapse: collapse;"> <tr> <td style="width: 10%; text-align: center;">Not to Scale</td> <td style="width: 90%; height: 200px;"> </td> </tr> </table>	Not to Scale	
Not to Scale					
This section to be completed by officer constructing pillar. Original station mark found/not found. Description of mark: ..... Original beacon found/not found. Description of beacon: ..... Height Top of Vanes to Top Mark .....m. Height of mark .....m.      above G.L.      below Diameter of Vanes .....m.      Height of Cairn .....m. Original Beacon has/has not been destroyed by me.		Date  Record of Station  			

CENTRAL MAPPING AUTHORITY GEODETTIC SURVEY OF NSLM

**GEODETTIC STATION RECONNAISSANCE and MAINTENANCE REPORT**

STATION: **ANCHAU PILLAR** No.: **623**  
 MAP SHEET SCALE: **1:250 000**  
 INSPECTED BY: **PENRITH** DATE: **26-10-89**  
 AUTHORITY: **CMA** FIELD BOOK: **W.M. GULLIBAY**


Description: **from Trig. Mast**  
 Note: *Cross out word or words which do not apply*

- Cleared by Janes bearing..... from Trig. Mast
- Mast & Vanes have been painted white & black respectively.
- The station/pillar was unpiled/hot unpiled/constructed on..... 19....., dimensions now being:  
 Description of mark..... should be explicit, e.g., S/Steel Pillar Plate, Steel plug, Brass plug, Bolt, G.I. Pipe  
 Height of mark.....m. <sup>above</sup> <sub>below</sub> rock/concrete: Mark is.....m. <sup>above</sup> <sub>below</sub> G.L.  
 Height of Top Vanes to Top Mark/Pillar plate .....m. Diameter of Vanes (vertical)  $\phi$ : **4.0**m.  
 Height of Cairn.....m. Diameter of Cairn.....m. Name Plate found/hot found/placed.  
 Length of Mast.....m. (approximate if not unpiled)
- A..... set in conc/rock has been placed/found, bearing.....°M from Mast/Plug/Pillar
- A..... set in conc/rock has been placed/found, bearing.....°M from Mast/Plug/Pillar
- A..... set in conc/rock has been placed/found, bearing.....°M from Mast/Plug/Pillar
- A..... set in conc/rock has been placed/found, bearing.....°M from Mast/Plug/Pillar
- Action required: **REPLACE MAST & VANES ONLY**

STANDPOINT:

Mark	Direction	Horiz. Distance	Height Difference	Mark	Direction	Horiz. Distance	Height Difference
			above standpt.				above standpt.
			below				below
			above standpt.				above standpt.
			below				below
Prepared by: **Checked: Noted on U.T.M. Card**

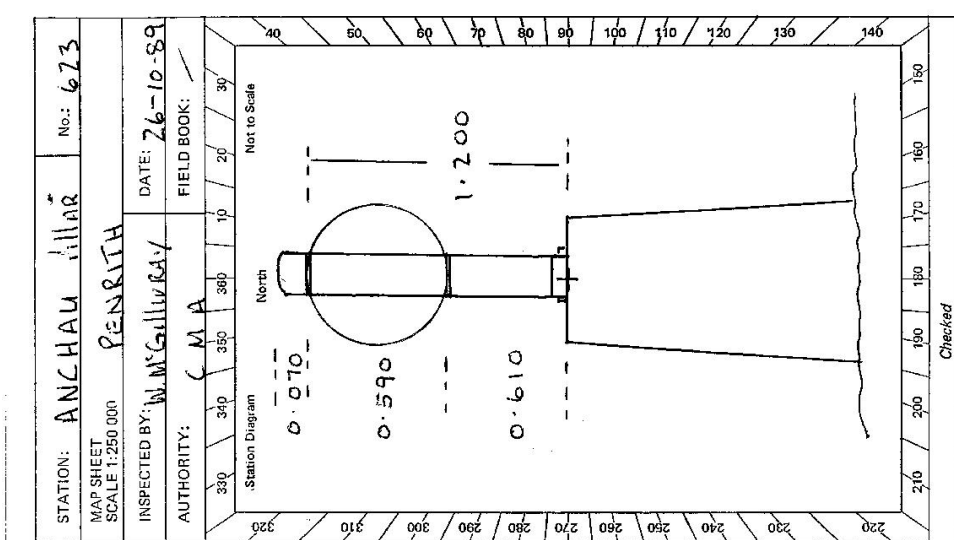





CENTRAL MAPPING AUTHORITY

GEODETIC SURVEY OF N.S.W.

GEODETIC STATION RECONNAISSANCE and MAINTENANCE REPORT

STATION: ANCHAU GALLAR No: 623

Description: *Note: Cross out word or words which do not apply*

Cleared by Janes bearing..... from Trig Mast

Mast & Vanes have been painted white & black respectively.

The station/pillar was unpllied/not unpllied/constructed on..... 19....., dimensions now being:

Description of mark..... should be explicit, e.g., S/Steel Pillar Plate, Steel plug, Brass plug, Bolt, G.L. Pipe

Height of mark..... m. above/below rock/concrete; Mark is..... m. above/below G.L.

Height of Top Vanes to Top Mark/Pillar plate... 1.70 m. Diameter of Vanes (vertical)... 6.0 m.

Height of Cairn..... m. Diameter of Cairn..... m. Name Plate found/not found/placed.

Length of Mast..... m. (approximate if not unpllied)

A..... set in conc/rock has been placed/found, bearing..... °M from Mast/Plug/Pillar

A..... set in conc/rock has been placed/found, bearing..... °M from Mast/Plug/Pillar

A..... set in conc/rock has been placed/found, bearing..... °M from Mast/Plug/Pillar

A..... set in conc/rock has been placed/found, bearing..... °M from Mast/Plug/Pillar

Action required: REPLACE MAST & VANES ONLY

STANDPOINT:

STANDPOINT:


Mark	Direction	Horiz. Distance	Height Difference	Mark	Direction	Horiz. Distance	Height Difference
			above standpt				above standpt
			below				below standpt
			above standpt				above standpt
			below				below standpt
Prepared by:

Checked:

Noted on U.T.M. Card

Checked

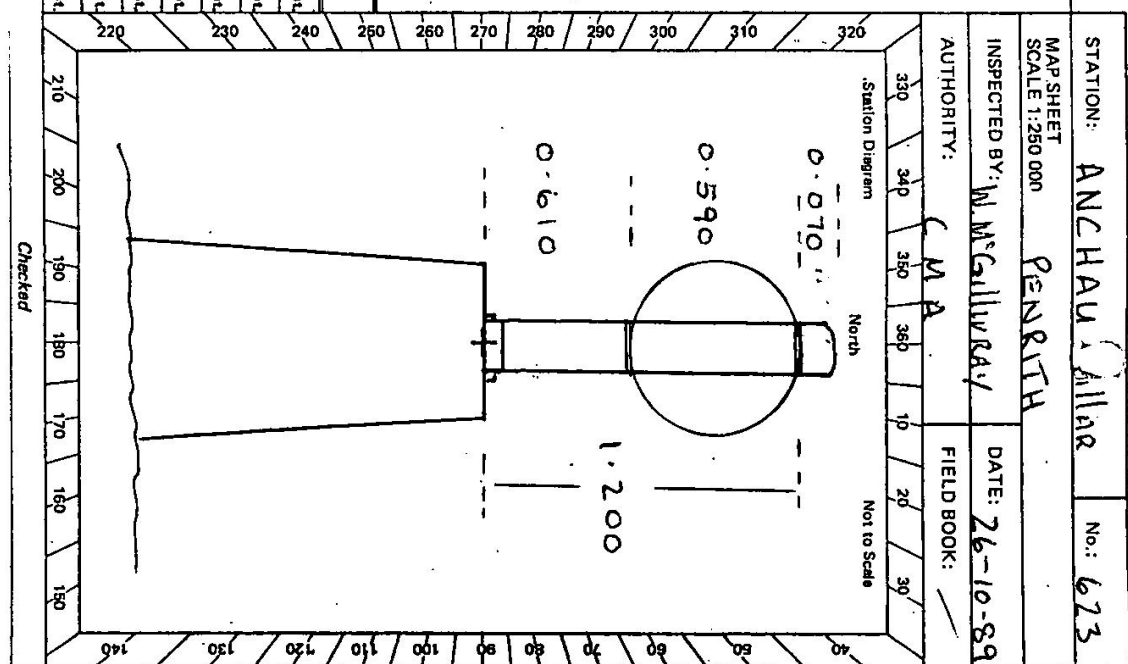

MAP SHEET SCALE 1:250 000

INSPECTED BY: W. McGILLIVRAY DATE: 26-10-89

AUTHORITY: CMAA FIELD BOOK: ✓








STATION 623 [ ANCHAUGHTS.

Station Diagram

Not to Scale

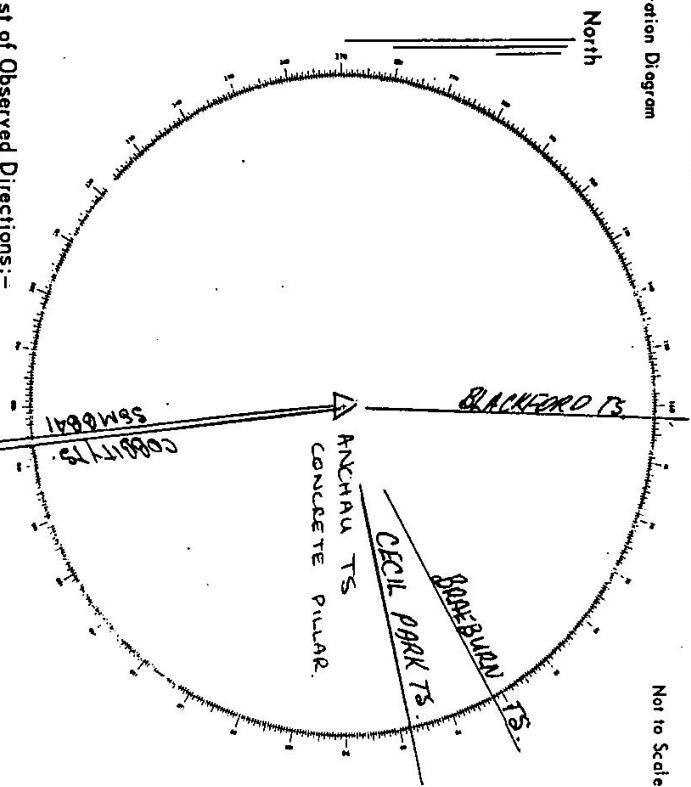

List of Observed Directions:-

Station	Direction	Station	Direction
58M6841	173 00 00		
TS 1512 COBBITT	173 40 48.2		
TS 1443 CECIL PARK	67 41 58.6		
TS 10597 BRADBURN	43 46 37.6		
TS 4159 BLACKFORD	2° 33 22.0		

Station	Direction	Station	Direction

Owners Name.....

Current Occupant.....

Address.....

Address.....

Access 26-9-78

FROM LUDDENHAM TAKE NORTHERN RD SOUTH TO ENTRANCE FOR "VICAR'S WINERY" (ON RIGHT) TAKE GATE ON LEFT 30M Further SOUTH. TRIG IS VISIBLE, FOLLOW TRACK FROM GATE TO TS.

