

GEODETIC SURVEY OF N.S.W.

CENTRAL MAPPING AUTHORITY

GEODETIC STATION RECONNAISSANCE and MAINTENANCE REPORT

Description:

1. Cleared by lanes bearing..... 3.60' Note: Cross out word or words which do not apply

2. Mast & Vanes have been painted white & black respectively. 4-7-75, dimensions now being: from Trig. Mast

3. The station/pillar was ~~unplaced/not-unplaced~~/constructed on..... 19.7.3, dimensions now being: from Trig. Mast

Description of mark: ~~BRASS PLUG~~ should be explicit, e.g., S/Steel Pillar Plate, Steel plug, Brass plug, Bolt, G.I. Pipe

Height of mark..... 3.55 m. above reek/concrete; Mark is: 1.65 m. above G.L.

Height of Top Vanes to Top Mark/Pillar plate..... 1.773 m. Diameter of Vanes (vertical)..... 0.756 m.

Height of Cairn..... m. Diameter of Cairn..... m. Name Plate found/not-found/placed.

Length of Mast..... 1.512 m. (approximate if not unplaced)

4. A..... BRASS PLUG..... set in conc/rock has been placed/found, bearing..... 355.0°M from Mast/Plug/Pillar

5. A..... COPPER NAIL..... set in conc/rock has been placed/found, bearing..... 226.0°M from Mast/Plug/Pillar

6. A..... set in conc/rock has been placed/found, bearing..... °M from Mast/Plug/Pillar

7. A..... set in conc/rock has been placed/found, bearing..... °M from Mast/Plug/Pillar

8. Action required:.....


STANDPOINT: CONC BRASS PILLAR		STANDPOINT: BRASS PLUG					
Mark	Direction	Horiz. Distance	Height Difference	Mark	Direction	Horiz. Distance	Height Difference
JONES PILLAR	359° 59' 40"		above standpt.	JONES PILLAR	359° 59' 40"		above standpt.
BRASS PLUG	57° 48' 45"	2.442	above standpt.	MANLY PILLAR	60° 37' 30"		above standpt.
MANLY PILLAR	60° 36' 30"		below	COWELL RES.	153° 37' 50"		above standpt.
COWELL RES.	153° 33' 45"		below	MC CAMB'S PILLAR	237° 50' 30"	2.646	above standpt.
COPPER NAIL	359° 11' 00"	3.369	above standpt.	COPPER NAIL	360° 39' 40"	3.012	above standpt.
			below				below
			below				below

Prepared by:

Checked:

23.11.91 Noted on U.T.M. Card

SI 2733-1

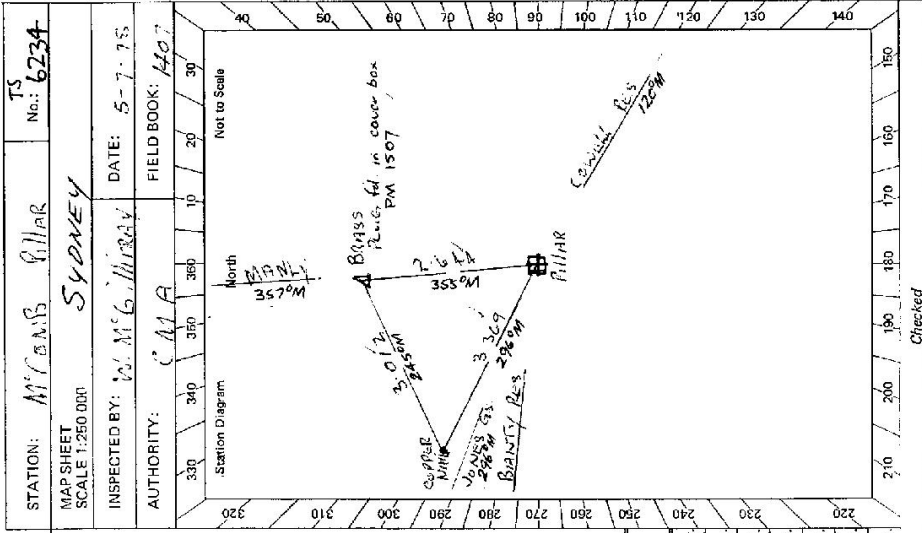

Checked

STATION MICOMBS PILLARS 6234	Owner's Name: Address: Phone:	Current Occupant: Address: Phone:	
Access Report of 5.7.1988 was found suitable/unsuitable. ACCESS 0.0 MINNLY PUBLIC SCOO 6.1888 ST 0.5 FORK GO RIGHT. 0.6 TRACK ON RIGHT 0.8 G.S.			
Beacon Diagram 	Not to Scale		
This section to be completed by officer constructing pillar.			
Original station mark found/ was found.			
Description of mark: BRASS PLATE IN ROCK			
Original beacon found/ not found.			
Description of beacon: STEEL TOWER FOUND DESTROYED			
Height Top of Vanes to Top Mark:m.			
Height of mark: 0.28 m. ^{above} rock/stone 0.16 m. ^{below} G.L.			
Diameter of Vanes: 0.45 m. Height of Cairn:m.			
Original Beacon has/ was not been destroyed by me.			
Date		Record of Station	

GEODETTIC SURVEY OF N.S.W.

CENTRAL MAPPING AUTHORITY

GEODETTIC STATION RECONNAISSANCE and MAINTENANCE REPORT

Description:

Note: Cross out word or words which do not apply

1. Cleared by lanes bearing M.A.D.S. CLARIBANK from Trig. Mast
2. Mast & Vanes have been painted white & black respectively.
3. The station/pillar was unpiled/not unpiled/constructed on 19 m, dimensions now being:
Description of mark CONC. PILLAR should be explicit, e.g., S/Steel Pillar Plate, Steel plug, Brass plug, Bolt, G.I. Pipe
Height of mark 1.350 m. ^{above} 1.500 m. ^{below} 0 m. G.L.
Height of Top Vanes to Top Mark/Pillar plate 1.405 m. Diameter of Vanes (vertical) 0.755 m.
Height of Cairn 0 m. Diameter of Cairn 0 m. Name Plate found/not-found/placed.
Length of Mast 1.485 m. (approximate if not unpiled)
4. A set in conc/rock has been placed/found, bearing 0° M from Mast/Plug/Pillar
5. A set in conc/rock has been placed/found, bearing 0° M from Mast/Plug/Pillar
6. A set in conc/rock has been placed/found, bearing 0° M from Mast/Plug/Pillar
7. A set in conc/rock has been placed/found, bearing 0° M from Mast/Plug/Pillar
8. Action required:

STANDPOINT:

STANDPOINT:

Mark	Direction	Horiz. Distance	Height Difference	Mark	Direction	Horiz. Distance	Height Difference
			above standpt.				above standpt.
			below standpt.				below standpt.
			above standpt.				above standpt.
			below standpt.				below standpt.
			above standpt.				above standpt.
			below standpt.				below standpt.
			above standpt.				above standpt.
			below standpt.				below standpt.

Prepared by:

Checked:

Noted on U.T.M. Card

St 2733-1

Checked

STATION: M'COMB Pillar No.: TS 6234
 MAP SHEET SCALE 1:250 000 SYDNEY
 INSPECTED BY: W. McSullivan DATE: 27-3-80
 AUTHORITY: CMA FIELD BOOK: -

Station Diagram

North


Not to Scale

ERECT MAST ONLY.
 THIS TRIG IS SURROUNDED
 BY SUEKERS

+

St 2733-2 D. West, Government Printer

STATION McOMB Pillar TS 6234

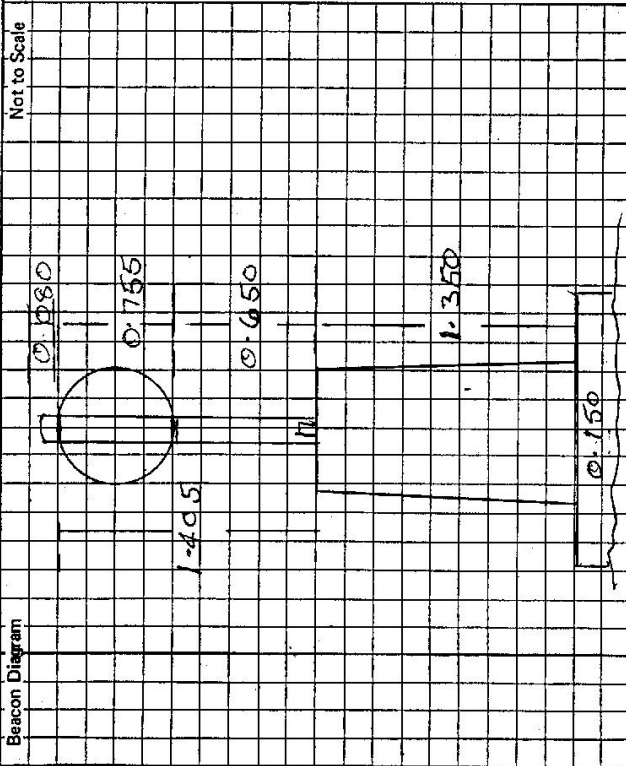

Owner's Name:
 Address:
 Phone:

Current Occupant:
 Address:
 Phone:

ACCESS
 Access Report of/19.....was found suitable/unsuitable.

This section to be completed by officer constructing pillar.

Original station mark found/not found.

Description of mark:

Original beacon found/not found.

Description of beacon:

Height Top of Vanes to Top Mark.....m.

Height of mark.....m. above rock/conc.....m. below G.L.

Diameter of Vanes.....m. Height of Cairn.....m.

Original Beacon has/has not been destroyed by me.

Date	Record of Station