

GEODETIC SURVEY OF N.S.W.

CENTRAL MAPPING AUTHORITY

GEODETIC STATION RECONNAISSANCE AND MAINTENANCE REPORT

Description:

Note: Cross out word or words which do not apply

1. Cleared by ~~lenses~~ bearing: 3.60 from Trig, Mast
2. Mast & Vanes have been painted white & black respectively. ✓
3. The station/pillar was ~~unplaced/not-unplaced~~/constructed on 27.5 <sup>above</sup> ~~below~~ 197.8 m, dimensions now being: Description of mark S.S. Pillar should be explicit, e.g., S/Steel Pillar Plate, Steel plug, Brass plug, Bolt, G.I. Pipe  
Height of mark 1.38 m <sup>above</sup> ~~below~~ reek/concrete; Mark is SSM m <sup>above</sup> ~~below~~ G.L.  
Height of Top Vanes to Top-Mark/Pillar plate 1.40 m. Diameter of Vanes (vertical) 0.755 m.  
Height of Cairn 0.00 m. Diameter of Cairn 0.00 m. Name Plate ~~found/not-found~~ placed.  
Length of Mast 1.43 m. (approximate if not unplaced)
4. A Steel PLUG set in conc/reek has been placed/found, bearing 112° M from Mast/Plug/Pillar
5. A SSM set in conc/reek has been placed/found, bearing 186° M from Mast/Plug/Pillar
6. A SSM set in conc/rock has been placed/found, bearing 112° M from Mast/Plug/Pillar
7. A SSM set in conc/rock has been placed/found, bearing 223° M from Mast/Plug/Pillar
8. Action required: None


STANDPOINT: Conc Obs Pillar		STANDPOINT: Trig Plug	
Mark	Direction	Horiz. Distance	Height Difference
<del>WILSONSET</del> <del>WILSONSET</del>	<u>359 59 60</u>	<u>3.59 59 60</u>	<u>above</u> standpt.
<u>TRIG PLUG</u>	<u>143 56 20</u>	<u>2.065</u>	<u>above</u> standpt.
<u>SSM</u>	<u>124 47 00</u>	<u>3.682</u>	<u>above</u> standpt.
<u>BENMORE TS</u>	<u>256 01 00</u>	<u>2.56 01 30</u>	<u>above</u> standpt.
		<u>3.33 55 00</u>	<u>above</u> standpt.
		<u>2.064</u>	<u>below</u> standpt.
			<u>above</u> standpt.
			<u>below</u> standpt.
			<u>above</u> standpt.
			<u>below</u> standpt.

Prepared by:

Checked:

S: 2733-1

Checked: 23/05/2022 Noted on U.T.M. Card

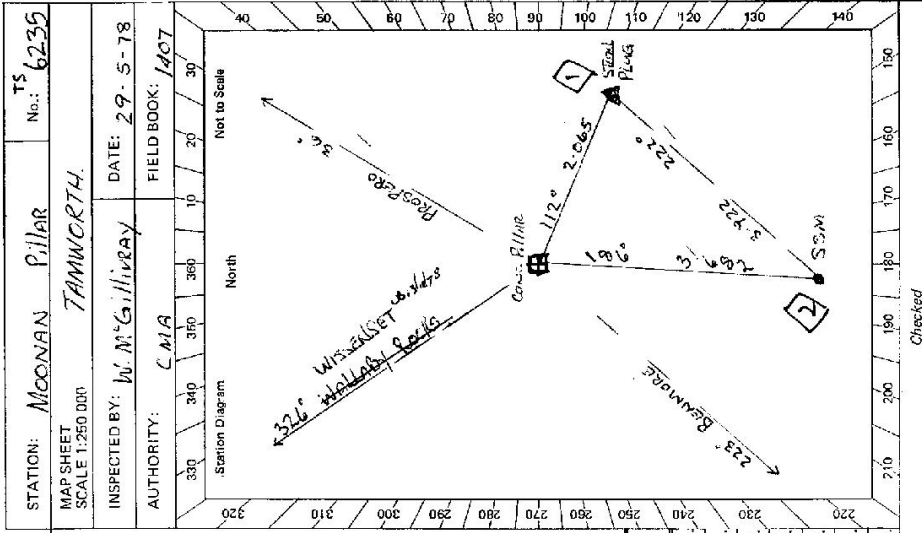


STATION: MOONAN Pillar No.: TS 6235

MAP SHEET SCALE 1:250 000

INSPECTED BY: W. M. GILLIVRAY DATE: 29-5-78

AUTHORITY: CMA FIELD BOOK: 1407

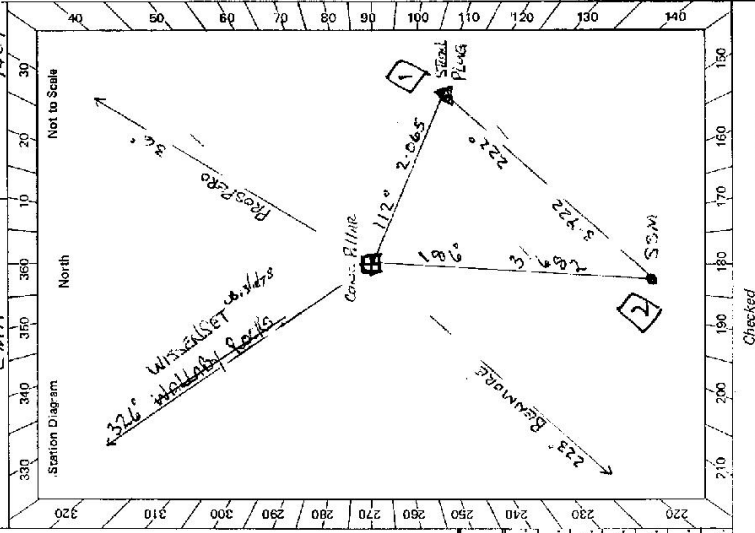

ST 2733-2 D. West Government Printer Beacon Diagram	Not to Scale 	STATION MIDNAN PILLAR TS 6235 Owner's Name: WALLIS COLLISON Address: TRIFALLEN Phone: 065 46134 Current Occupant: Address: Phone: ACCESS Access Report of 9.3.19 was found suitable/unavailable. * LOCATED IN MAINTENANCE BENCH
This section to be completed by officer constructing pillar. Original station mark found/lost/none. Description of mark: STEEL PILLAR IN CONE Original beacon found/lost/none. Description of beacon: CONE MARK * UNUSUAL Height Top of Vanes to Top Mark: 3.208 m. Height of mark: 0.037 m above G.L. below telecone at below Diameter of Vanes: 0.175 m. Height of Cairn .....m. Original Beacon has/has not been destroyed by me.		Record of Station Date

GEODETTIC SURVEY OF N.S.M.K. Batch Id: 1591

CENTRAL MAPPING AUTHORITY

GEODETTIC STATION RECONNAISSANCE and MAINTENANCE REPORT

Description: Note: Cross out word or words which do not apply


1. Cleared by lanes bearing..... from Trig. Mast
2. Mast & Vanes have been painted white & black respectively. ✓
3. The ~~station~~/pillar was unpiled/~~not inspected/constructed~~ on.....19.78... dimensions now being:
  - Description of mark: ~~Pillar~~ Plate should be explicit, e.g., S/Steel Pillar Plate, Steel plug, Brass plug, Bolt, G.I. Pipe
  - Height of mark.....1.370...m. <sup>above</sup> ~~below~~ ~~rock~~/concrete; Mark is.....1.4.....m. <sup>above</sup> ~~below~~ G.L.
  - Height of Top Vanes to Top ~~Mast~~/Pillar plate .....1.399.....m. Diameter of Vanes (vertical).....0.754.....m.
  - Height of Cairn.....m. Diameter of Cairn.....m. Name Plate found/~~not found~~/placed.
  - Length of Mast.....1.480.....m. (approximate if not unpiled) Pillar Spiggot is 16 mm above Plate
4. A. S/S/Steel PIN.....set in conc/~~rock~~ has been ~~placed~~/found, bearing.....112° M from ~~Mast/Plate~~/Pillar
5. A.....S.S.M. ....set in conc/~~rock~~ has been ~~placed~~/found, bearing.....193° M from ~~Mast/Plate~~/Pillar
6. A.....set in conc/~~rock~~ has been placed/~~found~~, bearing.....° M from Mast/Plug/Pillar
7. A.....set in conc/~~rock~~ has been placed/~~found~~, bearing.....° M from Mast/Plug/Pillar
8. Action required:.....

STANDPOINT: S/Steel Pillar Spiggot & Plate			STANDPOINT: S/Steel PIN Found				
Mark	Direction	Horiz. Distance	Height Difference	Mark	Direction	Horiz. Distance	Height Difference
S/Steel PIN Fd.	124° 12' 09"	2.066	1.676 <sup>above</sup> <del>below</del> standpt.	S.S.M. Fd.	236° 20' 50"	3.925	0.477 <sup>above</sup> <del>below</del> standpt.
S.S.M. Fd.	205 02 58	3.682	2.152 <sup>above</sup> <del>below</del> standpt.	PILLAR Spiggot	304 11 16.	2.066	1.675 <sup>above</sup> <del>below</del> standpt.
BLACK TOP GS OP	274 01 18.5		<sup>above</sup> standpt.	BLACK TOP GS OP	274 01 25		<sup>above</sup> standpt.
RED KNOB GS OP	321 31 44		<sup>above</sup> standpt.	RED KNOB GS OP	321 31 38		<sup>above</sup> standpt.
WISSENSSET GS	340 15 50		<sup>above</sup> standpt.	WISSENSSET GS	340 15 39		<sup>above</sup> standpt.
PROSPERO GS OP	51 38 28		<sup>above</sup> standpt.	PROSPERO GS OP	51 37 40		<sup>above</sup> standpt.
BARRINGTON GS OP	117° 42' 01"		<sup>above</sup> standpt.	BARRINGTON GS OP	117° 41' 59"		<sup>above</sup> standpt.

Prepared by: *[Signature]* 8/2/79

Checked: *[Signature]*


S:2733-1

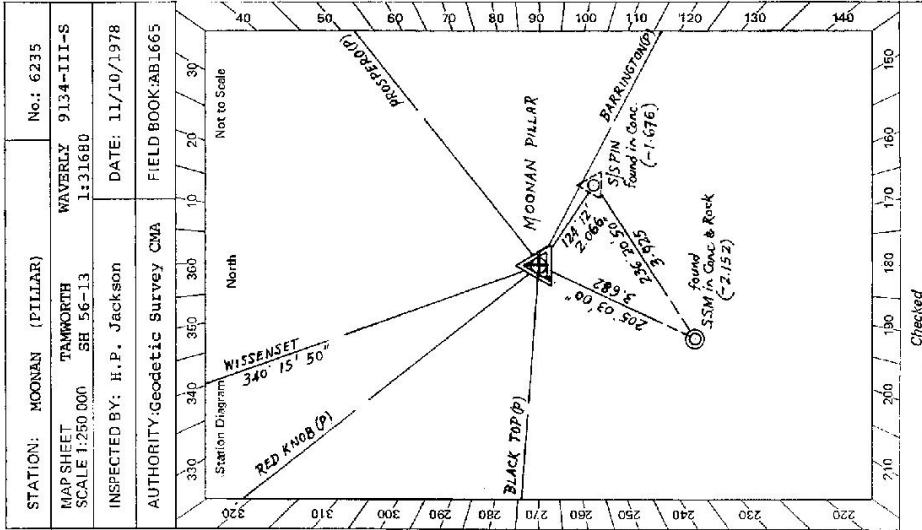

Checked

STATION MOONVAN (PILLAR) No. : 6235

Owner's Name: .....  
 Address: .....  
 Phone: .....  
 Current Occupant: .....  
 Address: .....  
 Phone: .....  
 Access Report of...../19.....was found suitable/unsuitable.  
ACCESS

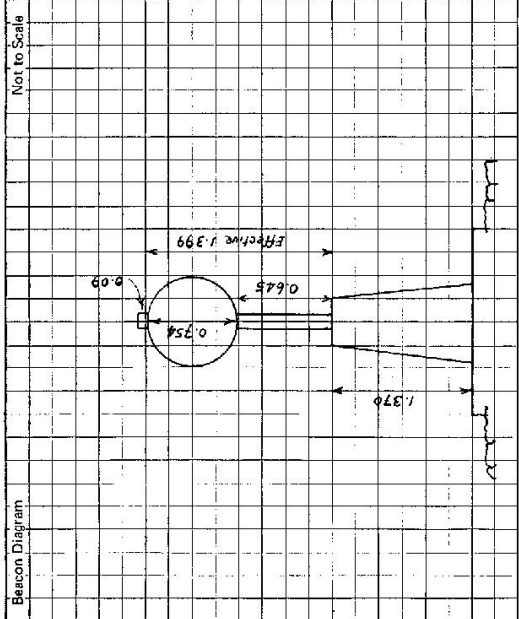

This section to be completed by officer constructing pillar.

Original station mark found/not found.

Description of mark: .....

Original beacon found/not found.

Description of beacon: .....

Height Top of Vanes to Top Mark.....m.

Height of mark.....m. above G.L. below G.L.

Diameter of Vanes.....m. Height of Calm.....m.

Original Beacon has/has not been destroyed by me.

Date	Record of Station

TS 6235

GEODETTIC SURVEY OF N.S.I.K.

CENTRAL MAPPING AUTHORITY


GEODETTIC STATION RECONNAISSANCE and MAINTENANCE REPORT

STATION: *Moonan*

MAP SHEET SCALE 1:250 000

INSPECTED BY: *A SIVERSEN* DATE: *9/11/79*

AUTHORITY: *C.M.A.* FIELD BOOK: *1732*

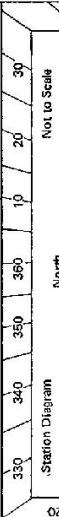

- Description:
- Cleared by lanes bearing..... Note: Cross out word or words which do not apply from Trig. Mast
  - Mast & Vanes have been painted white & black respectively.
  - The station/pillar was unpiled/not unpiled/constructed on..... 19..... dimensions now being: Description of mark..... should be explicit, e.g. S/Steel Pillar Plate, Steel plug, Brass plug, Bolt, G.I. Pipe
- Height of mark..... m. <sup>above</sup>/<sub>below</sub> rock/concrete; Mark is..... m. <sup>above</sup>/<sub>below</sub> G.L.
- Height of Top Vanes to Top Mark/Pillar plate..... m. Diameter of Vanes (vertical)..... m.
- Height of Cairn..... m. Diameter of Cairn..... m. Name Plate found/not found/placed.
- Length of Mast..... m. (approximate if not unpiled)
- A..... set in conc/rock has been placed/found, bearing..... °M from Mast/Plug/Pillar
  - A..... set in conc/rock has been placed/found, bearing..... °M from Mast/Plug/Pillar
  - A..... set in conc/rock has been placed/found, bearing..... °M from Mast/Plug/Pillar
  - A..... set in conc/rock has been placed/found, bearing..... °M from Mast/Plug/Pillar
8. Action required: File "y" in bottom of change

STANDPOINT:

Mark	Direction	Horiz. Distance	Height Difference	Mark	Direction	Horiz. Distance	Height Difference
			above standpt.				above standpt.
			below standpt.				below standpt.
			above standpt.				above standpt.
			below standpt.				below standpt.
Prepared by: *[Signature]* 16/1/79. Checked: *[Signature]* Noted on U.T.M. Card

STATION	MOONAN TS 6235
Owner's Name: <u>Mr. Allan Colleson</u>	Current Occupant: .....
Address: <u>"TRAVELLERS"</u>	Address: .....
Phone: <u>(051) 461134</u>	Phone: .....
Access Report of: <u>9.1.19</u>	<b>ACCESS</b> <u>NOTE: PHONE OWNER PRIOR TO</u>
<u>0.00</u>	<u>AT GUNBY PO + STONE HEAD WITH TOWARDS MOONAN PLAT ON SCALED RD</u>
<u>17.05</u>	<u>PASS RD TO WAVERLY ON LEFT SIGN WAVERLY 18" 29 MOONAN PLAT SCENE 24</u>
<u>17.20</u>	<u>BRIDGE OVER HUNTER RIVER</u>
<u>17.45</u>	<u>TURN RIGHT OFF MOONAN PLAT RD SIGN WOLLOOMAT STEWARDS BRICK 18"</u>
<u>19.50</u>	<u>TURN LEFT THROUGH GATE TO HOUSE (OWNER)</u>
<u>26.05</u>	<u>TAKE GATE BEHIND GARAGE</u>
<u>26.20</u>	<u>PASS SHED 4 YARDS FOLLOW TRACK TO RIGHT OF FENCE.</u>
<u>26.30</u>	<u>IRON GATE TAKE PAINT WHEEL TRACKS TO RIGHT ABOUT 20 METRES PAST GATE</u>
<u>26.60</u>	<u>(KEEP TO RIGHT OF GATE UNTIL 27.60)</u>
<u>26.95</u>	<u>DAM ON LEFT.</u>
<u>27.00</u>	<u>IRON GATE</u>
<u>27.45</u>	<u>DAM ON LEFT</u>
<u>27.50</u>	<u>IRON GATE</u>
<u>27.60</u>	<u>AT DAM TAKE TRACK TO LEFT ACROSS GULLY</u>
<u>27.70</u>	<u>FOLLOW TO POE CULTUR BANK</u>
<u>27.80</u>	<u>GO AROUND RHS OF DAM</u>
<u>27.85</u>	<u>AFTER PASSING DAM TURN LEFT ACROSS GULLY + TAKE WELL DEFINED ROAD UP HILL</u>
<u>28.35</u>	<u>IRON GATE FOLLOW TRACK TO RIGHT ALONG CENTRE OF RINGE</u>
<u>28.80</u>	<u>DAM ON LEFT</u>
<u>29.45</u>	<u>IRON GATE</u>
<u>30.45</u>	<u>FENCE TURNS TO LEFT FOLLOWING RAIL FENCE PAST DAM</u>
<u>30.80</u>	<u>FOLLOW TRACK + FENCE TO RIGHT</u>
<u>31.15</u>	<u>FOLLOW TRACK TO RIGHT OFF FENCE</u>
<u>31.55</u>	<u>BOTTOM OF STEEP SLOPE</u>
<u>31.95</u>	<u>IRON GATE</u>
<u>32.10</u>	<u>TRIG</u>

Beacon Diagram	Not to Scale	This section to be completed by officer constructing pillar.
		Original station mark found/not found.
		Description of mark: .....
		Original beacon found/not found.
		Description of beacon: .....
		Height Top of Vanes to Top Mark .....m.
		Height of mark: .....m. above G.L. below
		Diameter of Vanes .....m. Height of Cairn .....m.
		Original Beacon has/has not been destroyed by me.