

TS

GEODETTIC SURVEY OF N.S.#

CENTRAL MAPPING AUTHORITY


GEODETTIC STATION RECONNAISSANCE and MAINTENANCE REPORT

STATION: **NARANGARIE PILLAR** No.: **6236**

MAP SHEET SCALE 1:250 000

INSPECTED BY: **V. M.S. LILYRAY** DATE: **21-10-73**

AUTHORITY: **C.M.A** FIELD BOOK: **1657**

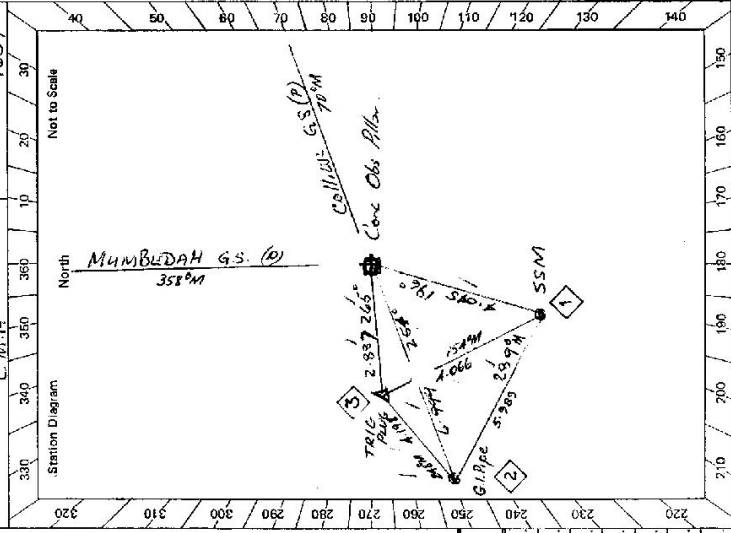

Description:	STANDPOINT: CON. OBS. PILLAR		STANDPOINT: TRIG. PILE	
	Mark	Direction	Mark	Direction
1. Cleared by lanes bearing..... <i>Note: Cross out word or words which do not apply</i> 3.60..... from Trig. Mast				
2. Mast & Vanes have been painted white & black respectively. ✓				
3. The station/pillar was unpiled/not unpiled/constructed on..... 2.0.10.19.7.3. dimensions now being: Description of mark... S.S. PILLAR ... should be explicit, e.g., S/Steel Pillar Plate, Steel plug, Brass plug, Bolt, G.I. Pipe Height of mark... 3.85 ... ^{above} / _{below} G.L. Height of Top Vanes to Top Mark/Pillar plate... 1.417 ... ^{above} / _{below} G.L. Diameter of Vanes (vertical)... 0.756 ...m. Height of Cairn.....m. Diameter of Cairn.....m. Name Plate found/not found/placed .				
Length of Mast..... 1.574 ...m. (approximate if not unpiled)				
4. A... TRIG. PILE ... set in stone/rock has been placed/found , bearing... 2.65 °M from Mast/Plug/Pillar				
5. A... S.S.M. ... set in stone/rock has been placed/found , bearing... 1.96 °M from Mast/Plug/Pillar				
6. A... COLLIER G.S. (D) ... set in stone/rock has been placed/found , bearing... 2.54 °M from Mast/Plug/Pillar				
7. A..... set in stone/rock has been placed/found , bearing.....°M from Mast/Plug/Pillar				
8. Action required:.....				

Station Diagram

Prepared by: **V. M.S. LILYRAY** Checked: **V. M.S. LILYRAY** Noted on U.T.M. Card

STATION **WARANGLABLE PILLAR 6236**


Owner's Name: **D WELLS**
 Address: **PINE RIDGE**
LAWSON PARK RD
 Phone:

Current Occupant:
 Address:
 Phone:

ACCESS

Access Report of 21/10/1988 was found suitable/unsuitable.

00 LEADVILLE DRIVE TOWARDS DUNEDIN
 2-8 TURN RIGHT ONTO LAWSON PARK ROAD
 3-1 RAILWAY CROSSING.
 6-8 CROSS ROAD. GO STRAIGHT AHEAD, (OWNER LIVES TO RIGHT DOUBLE LINE)
 9-8 TURN SHARP RIGHT.
 11-5 ROAD TURNS SHARP LEFT, GO STRAIGHT AHEAD, THROUGH DOUBLE GATE
 12-7 PANS SIDE X WATER TANK. FOLLOW PAINT TRACK TO GATE.
 14-1 IRON GATE, TURN RIGHT UP HILL TO G.S

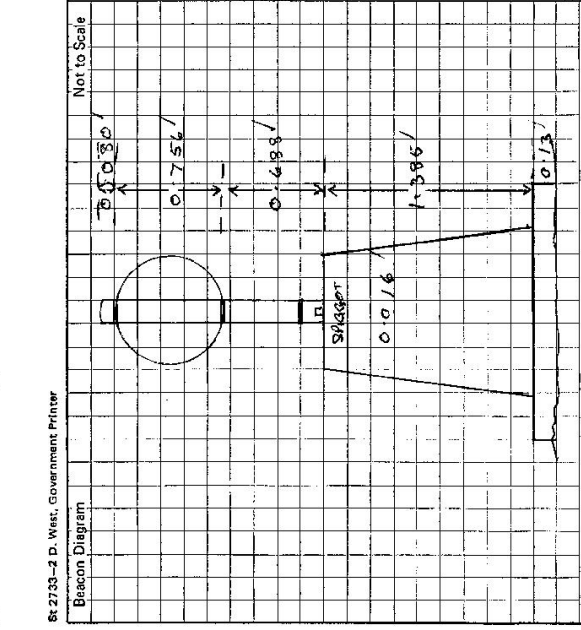

This section to be completed by officer constructing pillar.

Original station mark found/~~not found~~:
 Description of mark: **BRASS PLUG IN ROCK RD**

Original beacon found/~~not found~~:
 Description of beacon: **P.V.C. MAST x 3/VANES**

Height Top of Vanes to Top Mark: **2.983** m.
 Height of mark: **0.35** above rock/cont. m. below G.L.
 Diameter of Vanes: **0.204** m. Height of Cairn: m.

Original Beacon has/~~has not~~ been destroyed by me.

Date	Record of Station