

7498

CENTRAL MAPPING AUTHORITY  
 Department of Lands  
 Trigonometrical Survey of N.S.W.  
 RECONNAISSANCE and MAINTENANCE REPORT

STATION *Vineyets Lookout TS 6243*

Co: *Macquarie* Ph: *LANDSDOWNE*


Map Sheet: *CANDREN HAVEN* No: *5434*

Inspected by: *M.L. Morrison* Date: *19<sup>th</sup> July 1977*

Authority: Field Book: *1580*

Beacon Diagram: Not to Scale

**NO BEACON**

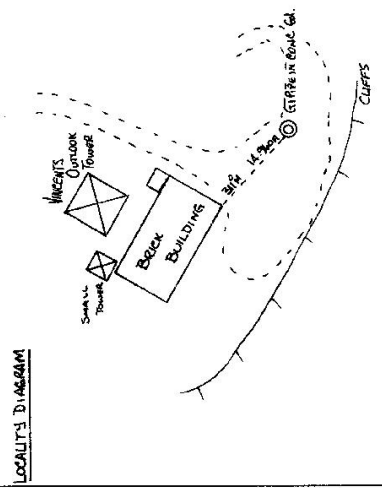

This Trig. Station has been: Note: Cross out word or words which do not apply

1. ~~Completely cleared to permit 360° vision to surrounding Trig.~~
2. Cleared by lances bearing..... from Trig. Mast
3. Trig. Mast & Vanes have been painted white & black respectively.
4. The Trig. was unpiled/not unpiled, dimensions now being: .....
- Description of mark..... should be explicit, e.g. Steel plug, Brass plug, Bolt, G.I. Pipe
- Height of mark..... m <sup>above</sup> <sub>below</sub> rock/concrete ..... m <sup>above</sup> <sub>below</sub> G.L.
- Height of Top Vanes to Top Mark..... m. Diameter of Vanes (vertical)..... m.
- Height of Cairn..... m. Diameter of Cairn..... m.
- Length of Mast..... m. (approximate if not unpiled)
5. A..... set in conc/rock has been placed..... m. bearing.....°M from Trig. Mast
6. A..... set in conc/soil has been placed..... m. bearing.....°M from Trig. Mast
7. A..... set in conc/soil has been placed..... m. bearing.....°M from Trig. Mast
8. A..... set in conc/rock has been placed..... m. bearing.....°M from Trig. Mast
9. Connection..... to..... m. bearing.....°M
10. Connection..... to..... m. bearing.....°M
11. Connection..... to..... m. bearing.....°M
12. Connection..... to..... m. bearing.....°M
13. Diff. Ht. .... is..... m. <sup>above</sup> <sub>below</sub>
14. Diff. Ht. .... is..... m. <sup>above</sup> <sub>below</sub>
15. Diff. Ht. .... is..... m. <sup>above</sup> <sub>below</sub>
16. Diff. Ht. .... is..... m. <sup>above</sup> <sub>below</sub>

Prepared by: *M.L. Morrison* Checked: \_\_\_\_\_ Noted on U.T.M. Card

Date	Record of Station
	<i>TOWER IS ON TOP OF HILL. NO TRIG. STATION. HORIZONTAL IS ON</i>
	<i>BASE OF TOWER. (1) DIAL IN CONC. ST.</i>
	<i>IRON PILE UNDER TOWER OBSERVED BY BUILDING</i>

Checked



CENTRAL MAPPING AUTHORITY

GEODETIC SURVEY OF N.S.W.


GEODETIC STATION RECONNAISSANCE and MAINTENANCE REPORT

STATION: **VINCENT** No.: **6243**

MAP SHEET SCALE 1:250 000  
INSPECTED BY: **L. L. HOLLIS** DATE: **30th August '11**

AUTHORITY: **C. M.A.** FIELD BOOK: **01171**

- Description:
1. Cleared by lanes bearing.....  
 Note: Cross out word or words which do not apply
2. Mast & Vanes have been painted white & black respectively.
3. The ~~station~~/pillar was ~~unpainted~~/constructed on ~~24.11.1978~~..... dimensions now being:  
 Description of marks ~~Steel Plug, Brass Plug, Bolt, G.I. Pipe~~
- Height of mark ~~3.285~~.....m. <sup>above</sup> ~~below~~ ~~mark~~ Mark is ~~1.525~~.....m. <sup>above</sup> ~~below~~ G.L.  
 Diameter of Vanes (vertical).....m.
- Height of Top Vanes to Top ~~Mark~~/Pillar plate ~~1.476~~.....m.  
 Diameter of Cairn.....m. Name Plate ~~found~~/placed.
- Length of Mast.....m. (approximate if not unpiled)
4. ~~A. C. I. R. P.~~..... set in conc/~~mark~~ has been ~~placed~~/found, bearing.....°M from ~~Mark~~/Pillar
5. ~~A. C. I. R. P.~~..... set in conc/~~mark~~ has been placed/~~found~~, bearing.....°M from ~~Mark~~/Pillar
6. ~~A. C. I. R. P.~~..... set in conc/~~rock~~ has been placed/~~found~~, bearing.....°M from Mast/Plug/Pillar
7. ~~A. C. I. R. P.~~..... set in conc/~~rock~~ has been placed/~~found~~, bearing.....°M from Mast/Plug/Pillar
8. Action required:.....

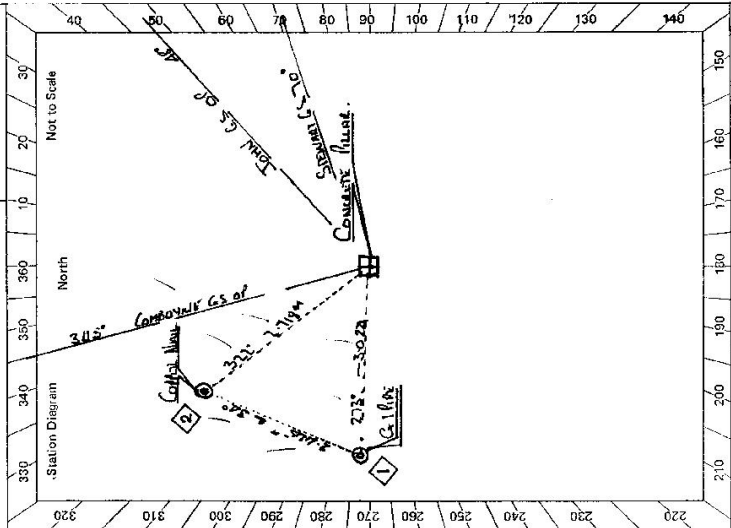


Mark	Direction	Horiz. Distance	Height Difference	Mark	Direction	Horiz. Distance	Height Difference
STANDPOINT: <b>RUSS</b>				STANDPOINT: <b>G. I. R. P.</b>			
Stewart	0 00 00		above standpt.	Stewart	0 00 00		above standpt.
G.I. R. P.	263 06 30	3.034	below standpt.	Russ	23 06 36	3.023	above standpt.
Composite Pillar	253 10 19	2.778	below standpt.	Composite Pillar	274 41 26		below standpt.
Iron Pillar	272 41 19		above standpt.	Composite Pillar	324 37 00	7.445	above standpt.
	338 26 00		above standpt.	Iron Pillar	338 26 26		below standpt.
			below standpt.				below standpt.

Prepared by:..... Checked:.....  
 Noted on U.T.M. Card

St 2733-2 D. West, Government Printer

Beacon Diagram

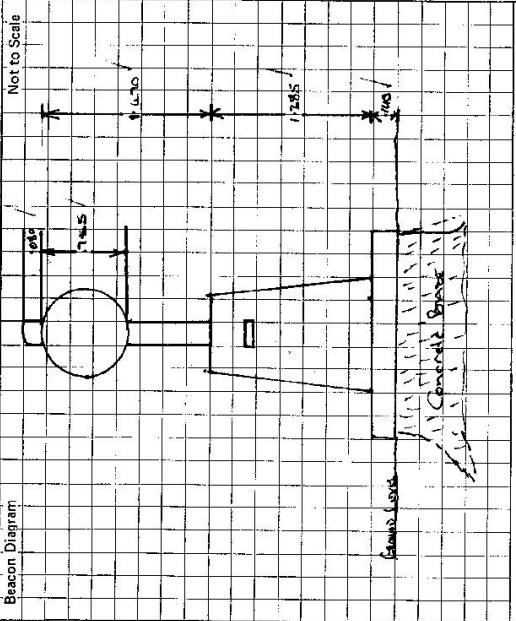

This section to be completed by officer constructing pillar.

Original station mark ~~found~~/not found.

Description of mark: ~~None~~

Original beacon found/not found.

Description of beacon: ~~None~~

Height Top of Varies to Top Mark.....m.

Height of mark.....m. above G.L. below

Diameter of Varies .....m. Height of Cairn .....m.

Original Beacon has/has not been destroyed by me.

STATION

WALLESLEY (P) TS 6243

Owner's Name: ~~FRANKLIN, JOHN~~

Address: ~~TRAFALGAR~~

Phone: .....

Current Occupant: .....

Address: .....

Phone: .....

ACCESS

Access Report of 21/8/1978 was found suitable/unsuitable.

- 0-00 Km. Looked over P.O. Tower. None
- 0-35 Turned LEFT into Boulevard de St-John 2 km. Contraband Store. Forest. Lookout
- 2-05 Over Railway Bridge, Turned LEFT saw houses out road
- 3-00 Cross Rd., Straight ahead. Saw a Mile to Lookout
- 7-05 " Followed Sign Vincent's Outlook
- 11-35 TURN LEFT
- 12-40 Turn LEFT saw 2 km Vincent's Outlook
- 14-00 Turned LEFT up Hill to Tower
- 14-20 ESCORTED SECTION

Date

Record of Station

CENTRAL MAPPING AUTHORITY

GEODETIC SURVEY OF M.S.W.

GEODETIC STATION RECONNAISSANCE and MAINTENANCE REPORT

Description:

1. Cleared by lanes bearing  $330^\circ$  to  $352^\circ$  to  $14^\circ$  to  $26^\circ$ ,  $69^\circ$  to  $81^\circ$  from Trig. Mast  
*Note: Cross out word or words which do not apply*  
 $105$  to  $215$  from Trig. Mast
2. Mast & Vanes have been painted white & black respectively.
3. The station/pillar was unpiled/not unpiled/constructed on..... 19....., dimensions now being:

Description of mark..... should be explicit, e.g., S/Steel Pillar Plate, Steel plug, Brass plug, Bolt, G.I. Pipe

Height of mark  $1.385$  m. <sup>above</sup> rock/concrete; Mark is  $1.545$  m. <sup>above</sup> G.L.

Height of Top Vanes to Top Mark/Pillar plate  $1.455$  m. Diameter of Vanes (vertical)  $0.75$  m.

Height of Cairn..... m. Diameter of Cairn..... m. Name Plate found/~~not found~~/placed.

Length of Mast..... m. (approximate if not unpiled)

4. A..... set in conc/rock has been placed/found, bearing..... M from Mast/Plug/Pillar

5. A..... set in conc/rock has been placed/found, bearing..... M from Mast/Plug/Pillar

6. A..... set in conc/rock has been placed/found, bearing..... M from Mast/Plug/Pillar

7. A..... set in conc/rock has been placed/found, bearing..... M from Mast/Plug/Pillar

8. Action required:.....

STANDPOINT:

STANDPOINT:

Mark	Direction	Horiz. Distance	Height Difference	Mark	Direction	Horiz. Distance	Height Difference
			above standpt.				above standpt.
			below				below
			above standpt.				above standpt.
			below				below
Prepared by:

Checked:

Noted on U.T.M. Card

S: 2733-1

Checked

STATION: **UNIVERS' LOOKOUT (P)** No.: **6243**

MAP SHEET: **HASTINGS**

INSPECTED BY: **C PARKES** DATE: **28/9/81**

AUTHORITY: **CMA** FIELD BOOK: **1923**

Station Diagram

North

+

MASI → LANES RECORDED

SEE BACK PAGE

Not to Scale

St. 2733-2 D. West, Government Printer	STATION <b>WINCENTS LOOKOUT TS 6243</b>	Owner's Name: <b>FOREST / COMMISSION</b> Address: <b>TRAFEL</b> Phone: <b>5223111</b>	Current Occupant: Address: Phone:	ACCESS Access Report of <b>2.12.1978</b> was found suitable <del>for</del> COOPERBROOK RD. TRAVEL NORTH 0.35 TURN LEFT INTO BANGLACHU BL SIGN COOPERBROOK STATE FOREST LOOKOUT. 2.45 OVER RAILWAY BRIDGE, TURN LEFT SIGN WINCENTS OUTLOOK. 3.90 CROSS ROAD, STRAIGHT AHEAD SIGN 9 MILE RJ LOOKOUT. 7.95 CROSS ROAD FOLLOW SIGN WINCENTS OUTLOOK. 12.35 DEER LEFT. 12.40 TURN LEFT SIGN 2 KM WINCENTS OUTLOOK. 14.00 TURN RIGHT UP HILL TO TOWER. 14.25 WINCENTS OUTLOOK C.S. OP.
Beacon Diagram		Not to Scale		
		This section to be completed by officer constructing pillar. Original station mark found/not found. Description of mark: Original beacon found/not found. Description of beacon: Height Top of Vanes to Top Mark.....m. Height of mark.....m. above G.L. below Diameter of Vanes .....m. Height of Cairn .....m. Original Beacon has/has not been destroyed by me.		
		Date		
		Record of Station		