

LAND INFORMATION CENTRE

GEODETIC SURVEY OF N.S.W.

GEODETIC STATION RECONNAISSANCE and MAINTENANCE REPORT

Note: Cross out word or words which do not apply


1. Cleared by Janes bearing 360° from Trig. Mast
2. Mast & Vanes have been painted white & black respectively.
3. The station/~~pillar~~ was unplied/~~not unplied~~/~~corrected~~ on 2nd August 1999 dimensions now being:  
 Description of mark: Fluorescent cone should be explicit, e.g. S/Steel Pillar Plate, Steel plug, Brass plug, Bolt, G.I. Pipe  
 Height of mark: above rock/concrete: Mark is above G.L.  
 Height of Top Vanes to Top Mark/Pillar plate: above m. Diameter of Vanes (vertical): above m.  
 Height of Cairn: above m. Diameter of Cairn: above m. Name Plate found/~~not found~~/~~placed~~: AN M D 1 stamped in conc  
 Length of Mast: above m. (approximate if not unplied)
4. A. set in conc/rock has been placed/found: bearing: 9° M from Mast/Plug/Pillar
5. A. set in conc/rock has been placed/found: bearing: 9° M from Mast/Plug/Pillar
6. A. set in conc/rock has been placed/found: bearing: 9° N from Mast/Plug/Pillar
7. A. set in conc/rock has been placed/found: bearing: 9° M from Mast/Plug/Pillar
8. Action required: 3 steel guard posts are gone & need replacing

STANDPOINT:

STANDPOINT:

Mark	Direction	Horiz. Distance	Height Difference	Mark	Direction	Horiz. Distance	Height Difference
			above standpt.				above standpt.
			below				below standpt.
			above standpt.				above standpt.
			below				below standpt.
Prepared by: [Signature] Checked: [Signature] Station: 30.8 99 Station Diagram: Not on U.T.M. Card

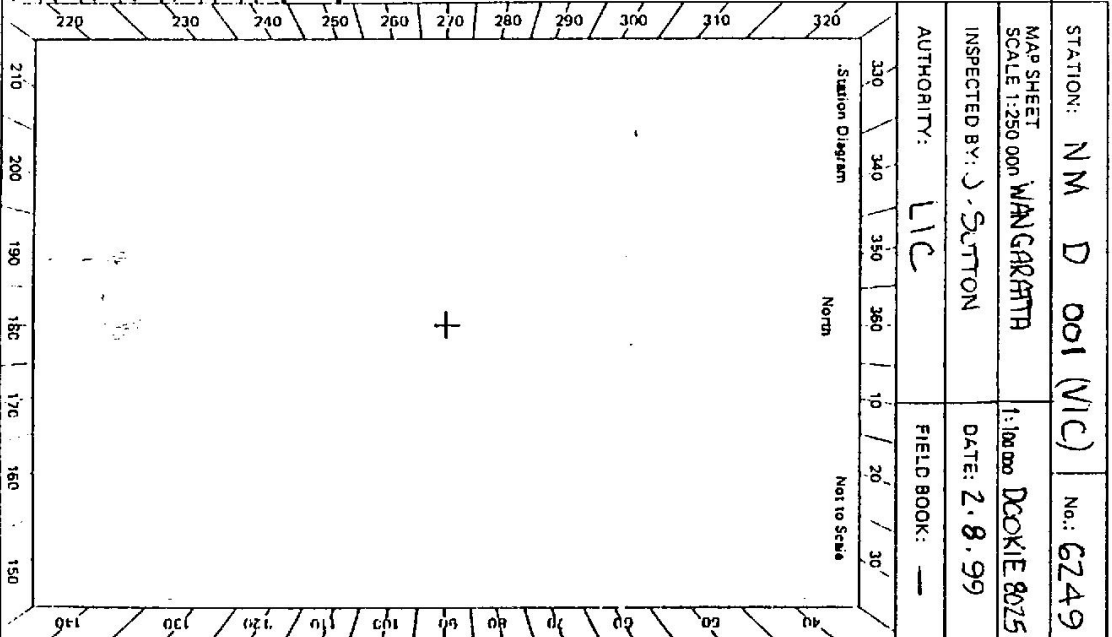

STATION: NM D 001 (VIC) No.: 6249  
 MAP SHEET SCALE 1:250 000 WANGARATTA  
 INSPECTED BY: J. SUTTON DATE: 2.8.99  
 AUTHORITY: LIC FIELD BOOK: -

Checked

