


STATION ALLEN TS 6251

Owners Name:
 Current Occupant:
 Address:
 Address:

Access 30-8-75

Not to Scale

Station Diagram

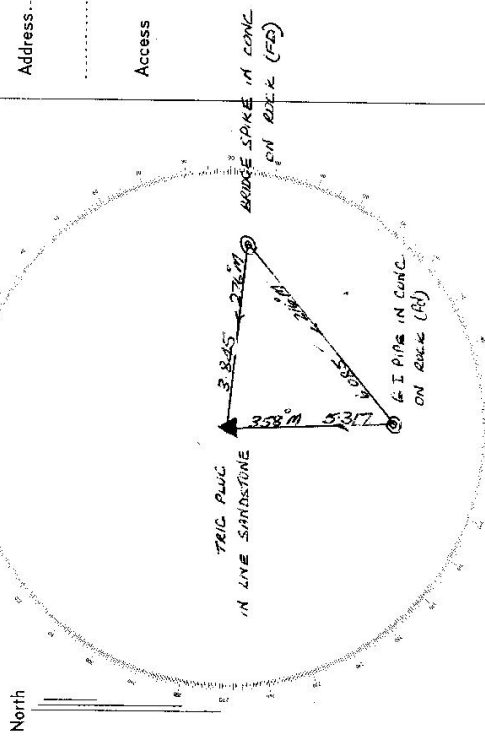

List of Observed Directions:-

Standpoint: TRIG PILE		Standpoint:	
Station	Direction	Station	Direction
WYENY PILLAR T.S.	00 00 00		
G.I. PIPE	27 27 21		
YAMBO PILLAR T.S.	201 07 07		
HOUSE SPIRE	05 57 46		
WOODLOR PILLAR T.S.	323 00 34		
Station	Direction	Station	Direction

CENTRAL MAPPING AUTHORITY

GEODETIC SURVEY OF M.S.W.
 GEODETIC STATION RECONNAISSANCE and MAINTENANCE REPORT

Description:
 1. Cleared by lanes bearing.....
 Note: Cross out word or words which do not apply

2. Mast & Vanes have been painted white & black respectively.
 Note: Cross out word or words which do not apply

3. The station/pillar was unpiled/not unpiled/constructed on.....19....., dimensions now being:

Description of mark.....should be explicit, e.g., S/Steel Pillar Plate, Steel plug, Brass plug, Bolt, G.I. Pipe

Height of mark.....m. ^{above} rock/concrete; ^{below} G.L.

Height of Top Vanes to Top Mark/Pillar plate.....m. Diameter of Vanes (vertical).....m.

Height of Cairn.....m. Diameter of Cairn.....m. Name Plate found/not found/placed.

Length of Mast.....m. (approximate if not unpiled)

4. A.....^{above} conc/rock has been placed/found, bearing.....°M from Mast/Plug/Pillar

5. A.....^{below} set in conc/rock has been placed/found, bearing.....°M from Mast/Plug/Pillar

6. A.....^{above} set in conc/rock has been placed/found, bearing.....°M from Mast/Plug/Pillar

7. A.....^{below} set in conc/rock has been placed/found, bearing.....°M from Mast/Plug/Pillar

8. Action required:.....

STANDPOINT:

Mark	Direction	Horiz. Distance	Height Difference	Mark	Direction	Horiz. Distance	Height Difference
			above standpt.				above standpt.
			below standpt.				below standpt.
			above standpt.				above standpt.
			below standpt.				below standpt.
Prepared by: D. KAIN.

Checked: Noted on U.T.M. Card

S: 2733-1

STATION: Alison Roof Top Pillar No.: 625/
 MAP SHEET SCALE 1:250 000 1:100 000
 S.D.N.E.Y CROSSFORD
 INSPECTED BY: D. J. KAIN. DATE: 16.2.1996
 AUTHORITY: L.I.C. FIELD BOOK: NIL

GEODETTIC SURVEY OF NSW

CENTRAL MAPPING AUTHORITY

GEODETTIC STATION RECONNAISSANCE and MAINTENANCE REPORT

Description: *Note: Cross out word or words which do not apply*

1. Cleared by lanes bearing..... from Trig. Mast
2. Mast & Vanes have been painted white & black respectively.
3. The station/pillar was unpiled/not unpiled/constructed on..... 19....., dimensions now being: Description of mark..... should be explicit, e.g., S/Steel Pillar Plate, Steel plug, Brass plug, Bolt, G.I. Pipe
- Height of mark.....m. above rock/concrete; Mark is.....m. above G.L.
- Height of Top Vanes to Top Mark/Pillar plate.....m. Diameter of Vanes (vertical).....m.
- Height of Cairn.....m. Diameter of Cairn.....m. Name/plate found/not found/placed.
- Length of Mast.....m. (approximate if not unpiled)
4. A..... set in conc/rock has been placed/found, bearing.....° M from Mast/Plug/Pillar
5. A..... set in conc/rock has been placed/found, bearing.....° M from Mast/Plug/Pillar
6. A..... set in conc/rock has been placed/found, bearing.....° M from Mast/Plug/Pillar
7. A..... set in conc/rock has been placed/found, bearing.....° M from Mast/Plug/Pillar
8. Action required.....

ACC

STANDPOINT:

Mark	Direction	Horiz. Distance	Height Difference	Mark	Direction	Horiz. Distance	Height Difference
			above standpt				above standpt
			below				below
			above standpt				above standpt
			below				below
Prepared by: *[Signature]*

Checked: *[Signature]*

Noted on U.T.M. Card

SI 2733-1

STATION: **ALXISON** No.: **6251**

MAP SHEET SCALE 1:250,000 **SYDNEY**

INSPECTED BY: **A. Sivertsen** DATE: **June 1990**

AUTHORITY: **LIC** FIELD BOOK: **-**

Station Diagram

North

Not to Scale

**** Current owner in process of leasing / selling this property - selling agent RAINE & HORNE TOUKLEY**

GS 24

St. 2733-2 D. West, Government Printer

Beacon Diagram	Not to Scale	STATION	ALLISON (P) 6251
<p>Owner's Name: EJ & M BROOKS * Current Occupant: See front</p> <p>Address: 38 FIONA RD Address:</p> <p>Phone: BEECECPT Phone:</p> <p>Phone: (02) 4841971 Phone:</p> <p>*** LIC LOCK *** ACCESS</p> <p>Access Report of 17/16/1990 was found suitable/unsuitable. 2nd JUNE 1990</p> <p>0.0 T-intersection WYONG . PACIFIC HWY / ANZAC AVE. Take ANZAC AVE.</p> <p>0.62 Travel straight ahead in to ALLISON ROAD</p> <p>2.19 Turn R into HUE RD sign DOORALONG / WYEE</p> <p>5.85 Pass DICKSON RD on L</p> <p>7.50 Turn L through double steel gate. ** CMA LOCK **</p> <p>7.95 Turn R and park at back of house. Follow track from Barb-B-Q up through rocks to Trig. 5 mins easy walk.</p> <p>ACCESS from SPARKES ROAD (TOUKLEY END)</p> <p>0.0 Intersection of SPARKES ROAD / HUE RD near TOURLEY exit from Expressway. TAKE HUE RD to South.</p> <p>0.5 Pass SANDRA ST on R</p> <p>1.2 Pass HOLLOWAY DR on L</p> <p>1.35 Turn R into double steel gates (7.5 above) CMA LOCK</p> <p>1.8 Turn R and park at back of house then follow track from Barb-B-Q up through rocks to Trig 5 mins easy walk.</p>			
<p>This section to be completed by officer constructing pillar.</p> <p>Original station mark found/not found.</p> <p>Description of mark:</p> <p>Original beacon found/not found.</p> <p>Description of beacon:</p> <p>Height Top of Vane to Top Mark.....m. abovem. belowm.</p> <p>Height of mark.....m. above rock/cornerm. below G.L.m.</p> <p>Diameter of Vanem. Height of Cairnm.</p> <p>Original Beacon has/not been destroyed by me.</p>			
		Date	Record of Station
		19.6.90	Remission to place CMA lock from MRS BROOKS.