

GEODETTIC SURVEY OF N.S.W.

CENTRAL MAPPING AUTHORITY

GEODETTIC STATION RECONNAISSANCE and MAINTENANCE REPORT

Description:

1. Cleared by lanes bearing..... *118°M to 82°M* *Note: Cross out word or words which do not apply*

2. Mast & Vanes have been painted white & black respectively. *1*

3. The station/pillar was *unpainted* *not unpainted* /constructed on..... *20 11 19 78* dimensions now being:

Description of mark..... *Steel Plate* should be explicit, e.g., S/Steel Pillar Plate, Steel plug, Brass plug, Bolt, G.I. Pipe

Height of mark..... *1.37* m. above *rock* *concrete*; Mark is *1.46* m. above *G.L.*

Height of Top Vanes to Top *Rock* /Pillar plate *1.435* m. Diameter of Vanes (vertical)..... *0.75* m.

Height of Cairn..... m. Diameter of Cairn..... m. Name Plate *found* /not found/placed.

Length of Mast..... m. (approximate if not unpainted)

4. A. *Cartridge Case* set in conc/*rock* has been *placed* /found, bearing..... *125* °M from *Mast/Pillar*

5. A. *SSM* set in conc/*rock* has been *placed* /found, bearing..... *170* °M from *Mast/Pillar*

6. A. *G.I. Pipe* set in conc/*rock* has been *placed* /found, bearing..... *222* °M from *Mast/Pillar*

7. A. set in conc/*rock* has been placed /found, bearing..... °M from Mast/Plug/Pillar

8. Action required:.....

STANDPOINT: <i>PILLAR PLATE</i>			STANDPOINT: <i>CARTRIDGE CASE</i>		
Mark	Direction	Horiz. Distance	Mark	Direction	Horiz. Distance
<i>Anonymous Sighting</i>	<i>0 00 00</i>	<i>above</i> <i>standpt.</i>	<i>Anonymous Sighting</i>	<i>0 00 00</i>	<i>above</i> <i>standpt.</i>
<i>G.I. Pipe</i>	<i>M 01 20</i>	<i>2859/1648</i>	<i>G.I. Pipe</i>	<i>AR 13 06</i>	<i>1588/1096</i>
<i>Broken Top G.S.</i>	<i>170 23 56</i>	<i>above</i> <i>standpt.</i>	<i>Conc Obs. Pillar</i>	<i>164 33 38</i>	<i>1793/1744</i>
<i>SSM</i>	<i>321 42 16</i>	<i>3 084, 1639</i>	<i>WHIP G.S. (D)</i>	<i>273 31 53</i>	<i>above</i> <i>standpt.</i>
<i>CARTRIDGE CASE</i>	<i>344 34 38</i>	<i>1793/1742</i>	<i>SSM</i>	<i>295 45 31</i>	<i>1593/1011</i>
		<i>above</i> <i>standpt.</i>			<i>above</i> <i>standpt.</i>
		<i>below</i> <i>standpt.</i>			<i>below</i> <i>standpt.</i>
		<i>below</i> <i>standpt.</i>			<i>below</i> <i>standpt.</i>


Prepared by:

Checked:


Noted on U.T.M. Card

S: 2733-1

Checked

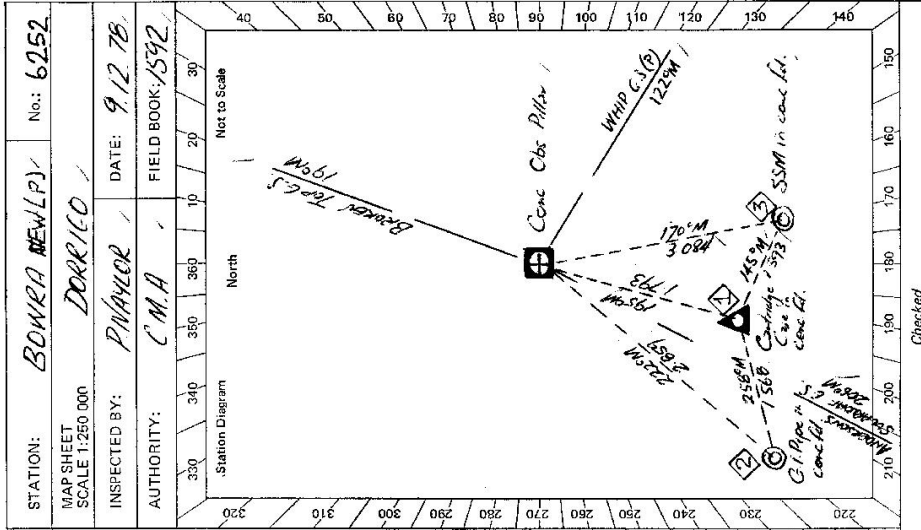

S-2733-2 D. West, Government Printer

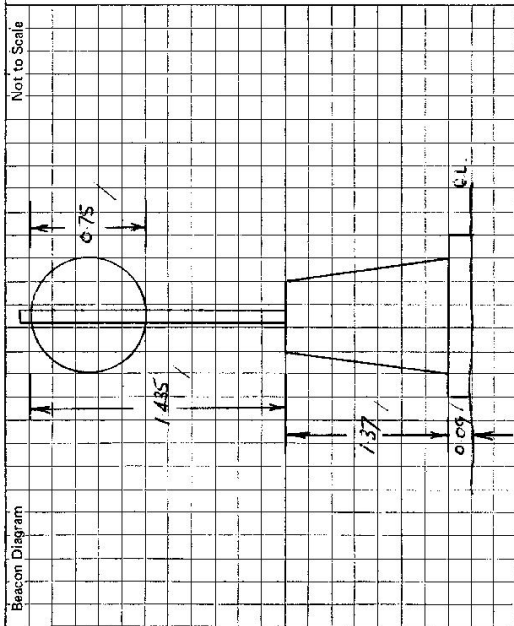

This section to be completed by officer constructing pillar.

Original station mark found/~~not found~~.Description of mark: CARTRIDGE CASE IN CONC.Original beacon found/~~not found~~.Description of beacon: CARTRIDGE CASE IN CONC.Height Top of Vanes to Top Mark: 3.597 m.Height of mark: 0.073 above 0.073 below G.L.Diameter of Vanes: 0.091 m. Height of Cairn: 1.06 m.Original Beacon has/~~has not~~ been destroyed by me.

STATION

SCWEN NEW (P) 6252

Owner's Name: MISTHA TIRATAddress: CRESTON COMMISSIONPhone: MARKSVILLE

Current Occupant:

Address:

Phone:

ACCESS 9-12-78Access Report of 1-10-19 was found not found.KM

- 10.00 BOWENVILLE P.C. TAKE SOUTH ARM - TAKE ARM RD
- 0.50 TAKE TANKERS ARM - SOUTH ARM ROAD TO YOUR RIGHT
- 5.95 TAKE SOUTH ARM ROAD TO YOUR RIGHT
- 6.80 PASS MCALPINES CREEK ROAD ON YOUR LHS
- 9.50 PASS OVER GRANITE BRIDGE
- 9.95 OVER STEEL GRID AND RAMP ALICE ROAD ON YOUR LHS
- 10.70 OVER STEEL GRID
- 11.65 OVER STEEL GRID
- 14.75 TAKE MARATHA ARM ROAD TO YOUR RIGHT
- 17.20 TAKE ALICE ROAD TO YOUR LEFT
- 17.60 PASS DROVE ROAD ON YOUR LHS
- 21.60 TAKE WEEP TRAIL UP BANK ON YOUR LHS
- 21.90 BOWEN PILLAR

Date

Record of Station

CENTRAL MAPPING AUTHORITY

GEODETIC STATION RECONNAISSANCE and MAINTENANCE REPORT

Description:

Note: Cross out word or words which do not apply

1. Cleared by lanes bearing..... from Trig. Mast
2. Mast & Vanes have been painted white & black respectively.
3. The station/pillar was unpiled/not unpiled/constructed on..... 19....., dimensions now being:
Description of mark..... should be explicit, e.g., S/Steel Pillar Plate, Steel plug, Brass plug, Bolt, G.I. Pipe
Height of mark.....m. above below rock/concrete; Mark is.....m. above below G.L.
Height of Top Vanes to Top Mark/Pillar plate.....m. Diameter of Vanes (vertical).....m.
Height of Cairn.....m. Diameter of Cairn.....m. Name Plate found/not found/placed.....m.
Length of Mast.....m. Approximate if not unpiled)
4. A..... set in conc/rock has been placed/found, bearing.....°M from Mast/Plug/Pillar
5. A..... set in conc/rock has been placed/found, bearing.....°M from Mast/Plug/Pillar
6. A..... set in conc/rock has been placed/found, bearing.....°M from Mast/Plug/Pillar
7. A..... set in conc/rock has been placed/found, bearing.....°M from Mast/Plug/Pillar

3. ~~Action required:..~~

STANDPOINT:

STANDPOINT:

Mark	Direction	Horiz. Distance	Height Difference	Mark	Direction	Horiz. Distance	Height Difference
			above standpt				above standpt
			below standpt				below standpt
			above standpt				above standpt
			below standpt				below standpt
Prepared by:

Checked:

2017-2018

Noted on U. T. M. Card

St 2733-1

STATION: BOWRA WATER CSOP	No.: 6252
MAP SHEET SCALE 1:250 000	DORRIGO
INSPECTED BY: P. LOCK	DATE: 13-6-79
AUTHORITY: CMA	FIELD BOOK: <i>See field book</i>

Station Diagram

North

Not to Scale

Checked

S: 2733-2 D. West, Government Printer

STATION BOWRA NEW GSOP 6252																	
Beacon Diagram <div style="border: 1px solid black; width: 100px; height: 100px; margin: 5px auto;"></div>		<table style="width: 100%; border-collapse: collapse;"> <tr> <td style="width: 20%;">Owner's Name: MISTAKE - FOREST</td> <td style="width: 20%;">Current Occupant:</td> </tr> <tr> <td>Address: Foresty Commission</td> <td>Address:</td> </tr> <tr> <td>Macksville</td> <td>Phone:</td> </tr> <tr> <td>Phone:</td> <td>ACCESS 13-6-79</td> </tr> </table> <p>Copy of Access Report of 7/12/19. It was found suitable/unsuitable.</p> <p>0.0 Km Bowraville P.O. Take South Arm Taylor's Arm Road</p> <p>0.5 Take South Arm - Taylor's Arm Road to your right</p> <p>5.45 Take South Arm Road to the right</p> <p>7.2 End of Runway - continue following ground road passing Mt. Hughes Creek Road at T-junction</p> <p>15.65 Cross Grants Bridge</p> <p>16.1 Cross grid and turn left onto Alice Road.</p> <p>16.85 Over Steel grid</p> <p>17.25 Over Grid</p> <p>20.95 Veer right continuing on Alice Road at 4-way intersection</p> <p>23.5 Turn left onto Jasper's Creek Road at T-junction</p> <p>23.9 Run Stone Rd on left</p> <p>27.9 Turn right up Paint rough 4 wheel drive track</p> <p>28.2 BOWRA NEW GSOP</p>								Owner's Name: MISTAKE - FOREST	Current Occupant:	Address: Foresty Commission	Address:	Macksville	Phone:	Phone:	ACCESS 13-6-79
Owner's Name: MISTAKE - FOREST	Current Occupant:																
Address: Foresty Commission	Address:																
Macksville	Phone:																
Phone:	ACCESS 13-6-79																
This section to be completed by officer constructing pillar.																	
Original station mark found/not found.																	
Description of mark:																	
Original beacon found/not found.																	
Description of beacon:																	
Height Top of Vane to Top Mark:m.																	
Height of mark:m. above rock/concm. below G.L.																	
Diameter of Vane:m. Height of Cairnm.																	
Original Beacon has/not been destroyed by me.																	
Date					Record of Station												