

6254
No.: 3875


CENTRAL MAPPING AUTHORITY
GEODETTIC SURVEY OF N.S.W.
GEODETTIC STATION RECONNAISSANCE and MAINTENANCE REPORT

STATION: T.S. RED HILL (P)
MAP SHEET SCALE 1:250 000
INSPECTED BY: W.E. Sainsbery
AUTHORITY: Dept. of Main Roads
DATE: 10th Oct 1978
FIELD BOOK:

MAP SHEET SCALE 1:250 000
INSPECTED BY: W.E. Sainsbery
AUTHORITY: Dept. of Main Roads
DATE: 10th Oct 1978
FIELD BOOK:

STATION: T.S. RED HILL (P)
MAP SHEET SCALE 1:250 000
INSPECTED BY: W.E. Sainsbery
AUTHORITY: Dept. of Main Roads
DATE: 10th Oct 1978
FIELD BOOK:

STATION: T.S. RED HILL (P)
MAP SHEET SCALE 1:250 000
INSPECTED BY: W.E. Sainsbery
AUTHORITY: Dept. of Main Roads
DATE: 10th Oct 1978
FIELD BOOK:

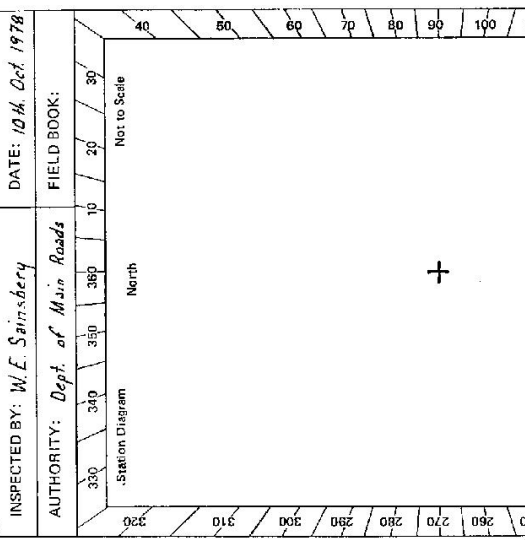

Description:
1. Cleared by lanes bearing.....
2. Mast & Vanes have been painted white & black respectively.
3. The station/pillar was unpiled/not unpiled/constructed on.....
Description of mark.....
Height of mark.....m.
Height of Top Vanes to Top Mark/Pillar plate.....m.
Height of Cairn.....m.
Length of Mast.....m.
4. A.....
5. A.....
6. A.....
7. A.....
8. Action required:.....

Note: Cross out word or words which do not apply
..... from Trig. Mast
..... should be explicit, e.g. S/Steel Pillar Plate, Steel plug, Brass plug, Bolt, G.I. Pipe
..... dimensions now being:
..... above G.L.
.....m. Diameter of Vanes (vertical).....m.
.....m. Diameter of Cairn.....m. Name Plate found/not found/placed.
.....m. (approximate if not unpiled)

Note: Cross out word or words which do not apply
..... from Trig. Mast
..... should be explicit, e.g. S/Steel Pillar Plate, Steel plug, Brass plug, Bolt, G.I. Pipe
..... dimensions now being:
..... above G.L.
.....m. Diameter of Vanes (vertical).....m.
.....m. Diameter of Cairn.....m. Name Plate found/not found/placed.
.....m. (approximate if not unpiled)

STANDPOINT:	Mark	Height Difference	Horiz. Distance	Direction	Mark	Height Difference	Horiz. Distance	Direction	Height Difference
		above standpt.				above standpt.			above standpt.
		below standpt.				below standpt.			below standpt.
		above standpt.				above standpt.			above standpt.
		below standpt.				below standpt.			below standpt.
Prepared by:
Checked:
Noted on U.T.M. Card

Prepared by:
Checked:
Noted on U.T.M. Card

Prepared by:
Checked:
Noted on U.T.M. Card

GEODETIC SURVEY OF M.S.W.

CENTRAL MAPPING AUTHORITY

GEODETIC STATION RECONNAISSANCE and MAINTENANCE REPORT

Description:

1. Cleared by lanes bearing..... 360° *Note: Cross out word or words which do not apply*
2. Mast & Vanes have been painted white & black respectively. ✓
..... from Trig. Mast
3. The station/pillar was ~~unplaced/not emptied~~/constructed on 29 11 19 78 dimensions now being:
Steel plate should be explicit, e.g. S/Steel Pillar Plate, Steel plug, Brass plug, Bolt, G.I. Pipe
Description of mark.....
Height of mark..... 1.37 m. ^{above}/_{below} feet/concrete; Mark is 1.50 m. ^{above}/_{below} G.L.
Height of Top Vanes to Top Mark/Pillar plate 1.170 m. Diameter of Vanes (vertical) 0.755 m. ✓
Height of Cairn..... m. Diameter of Cairn..... m. Name Plate ~~placed~~/not ~~placed~~/placed.
Length of Mast..... m. (approximate if not unplied)
4. A. BRASS TRIG PILE set in conc./rock has been ~~placed~~/found, bearing 253° M from Mast/Plug/Pillar
5. A. COPPER NAIL set in conc./rock has been ~~placed~~/found, bearing 370° M from Mast/Plug/Pillar
6. A..... set in conc./rock has been placed/found, bearing..... M from Mast/Plug/Pillar
7. A..... set in conc./rock has been placed/found, bearing..... M from Mast/Plug/Pillar
8. Action required:.....


STANDPOINT:		Pillar Plate		STANDPOINT:		BRASS TRIG PILE	
Mark	Direction	Horiz. Distance	Height Difference	Mark	Direction	Horiz. Distance	Height Difference
PARRORUMBA G.S(P)	0° 00' 00"	0° 00' 00"	above standpt.	PARRORUMBA G.S(P)	0° 00' 00"	0° 00' 00"	above standpt.
BRASS TRIG PILE	358 51 00	2.982	1.854	COPPER NAIL	122 42 45	3.384	0.284
COPPER NAIL	67 28 20	3.014	1.593	CONC. PLS. PILLAR	178 49 25	2.984	1.854
GIBRALTAR G.S (P)	271 21 05			GIBRALTAR G.S (P)	271 20 40		

Prepared by: *Paul King*

Checked: *Paul King*

Notes on U.T.M. Card

ST 2733-1

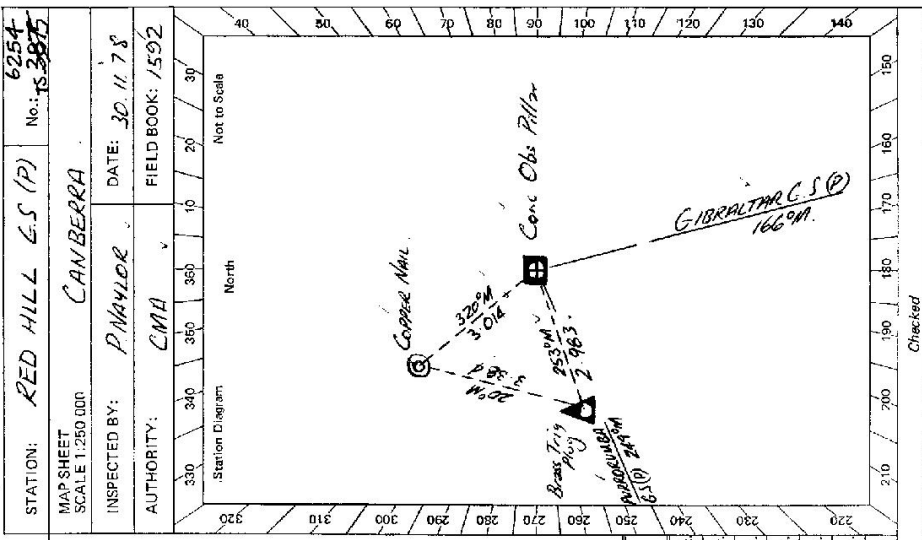

Checked

STATION: RED HILL G.S (P) No: 6254
 MAP SHEET SCALE 1:250 000 No: 18 3875
 INSPECTED BY: P. NAYLOR DATE: 30.11.78
 AUTHORITY: CMA FIELD BOOK: 1592

STATION **RED HILL C.S. (P) TS 2873**
 6254


Owner's Name: **Mr B DIBORNEY**
 Address: **"ELLENDAW"**
% PO. BUNGENDORE
 Phone: **38 1233**

Current Occupant:
 Address:
 Phone:

ACCESS

Access Report of **30.11.1938** was found suitable/unsuitable.

Km
 0.0 **BUNGENDORE PO Travel West towards GUNVARDRO**
 0.6 **TURN RIGHT TOWARDS GOULBURN SIGN 6.63 km**
 7.2 **TURN LEFT - GRID - ENTRANCE TO "CORAMBOULEY" "LAKELANDS" "ELLENDAW" 7km**
 7.9 **CAUSEWAY**
 8.4 **GRID - STRAIGHT AHEAD**
 9.8 **GRID**
 10.3 **ENTRANCE TO SAND QUARRY ON LEFT - STRAIGHT AHEAD**
 11.3 **BRIDGE**
 11.6 **TAKE LEFT FORK**
 12.0 **GRID**
 12.5 **BRIDGE**
 12.6 **TAKE RIGHT FORK - FOLLOW MAIN TRACK**
 12.9 **GRID**
 13.7 **TAKE LEFT FORK**
 13.8 **GRID**
 13.9 **HOUSE ON RIGHT - DWIVER - STRAIGHT AHEAD**
 14.3 **GRID**
 14.6 **FOLLOW TRACK STRAIGHT AHEAD ALONG FENCE**
 15.1 **GATE - FOLLOW MAIN TRACK**
 15.7 **TAKE LEFT FORK TOWARDS TRIE**
 16.3 **RED HILL PILLAR**

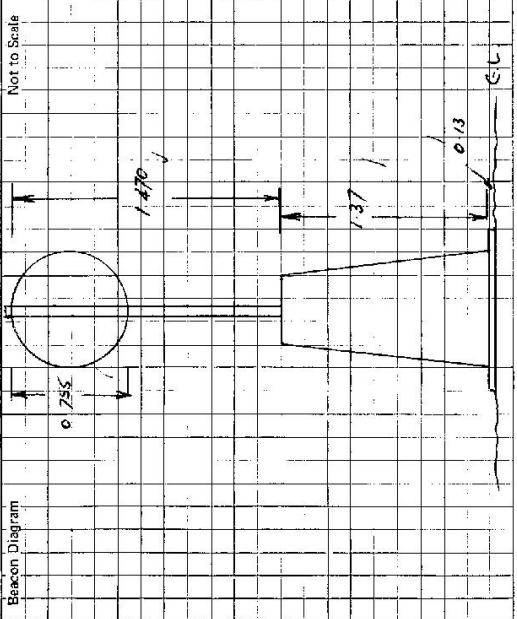

This section to be completed by officer constructing pillar.

Original station mark found/lost/used.

Description of mark: **Base of Trip Pillar in Conc.**

Original beacon found/lost/used.

Description of beacon: **Small Conical Base in Conc.**

Height Top of Vanes to Top Mark m.

Height of mark **0.66** above **0.00** feet/conc m. below G.L.

Diameter of Vanes m. Height of Cairn m.

Original Beacon has ~~been~~ been destroyed by me.

Date	Record of Station

LAND INFORMATION CENTRE

GEODETTIC SURVEY OF N.S.W. *BATCH 10 1653*

GEODETTIC STATION RECONNAISSANCE and MAINTENANCE REPORT

STATION: *RED HILL G.S. (P)* No.: *6254*


MAP SHEET SCALE 1:250 000

CANBERRA

INSPECTED BY: *G. FORD* DATE: *28-9-94*

AUTHORITY: *L. I. C.* FIELD BOOK: *—*

- Description: *360°* Note: *Cross out word or words which do not apply*
- Cleared by lanes bearing..... from Trig. Mast
 - Mast & Vanes have been painted white & black respectively. ✓
 - The station/pillar was ~~unplaced~~ *not unplaced*/constructed on *29-11* 19*78*., dimensions now being: *1.140* m. *1.140* m. *0.750* m.
- Description of mark: *Steel Pillar* should be explicit, e.g., S/Steel Pillar Plate, Steel plug, Brass plug, Bolt, G.I. Pipe
- Height of mark.....m. ^{above} rock/concrete; Mark is.....m. ^{above} _{below} G.L.
- Height of Top Vanes to Top Mark/Pillar plate.....m. Diameter of Vanes (vertical).....m.
- Height of Cairn.....m. Diameter of Cairn.....m. Name Plate found/not found/placed.
- Length of Mast.....m. (approximate if not unplaced)
- A..... *BRASS TRIG PLUG* set in conc/reek has been placed/found, bearing.....° M from Mast/Plug/Pillar
 - A..... *COPPER MARK* set in conc/reek has been placed/found, bearing.....° M from Mast/Plug/Pillar
 - A..... set in conc/rock has been placed/found, bearing.....° M from Mast/Plug/Pillar
 - A..... set in conc/rock has been placed/found, bearing.....° M from Mast/Plug/Pillar
8. Action required:.....

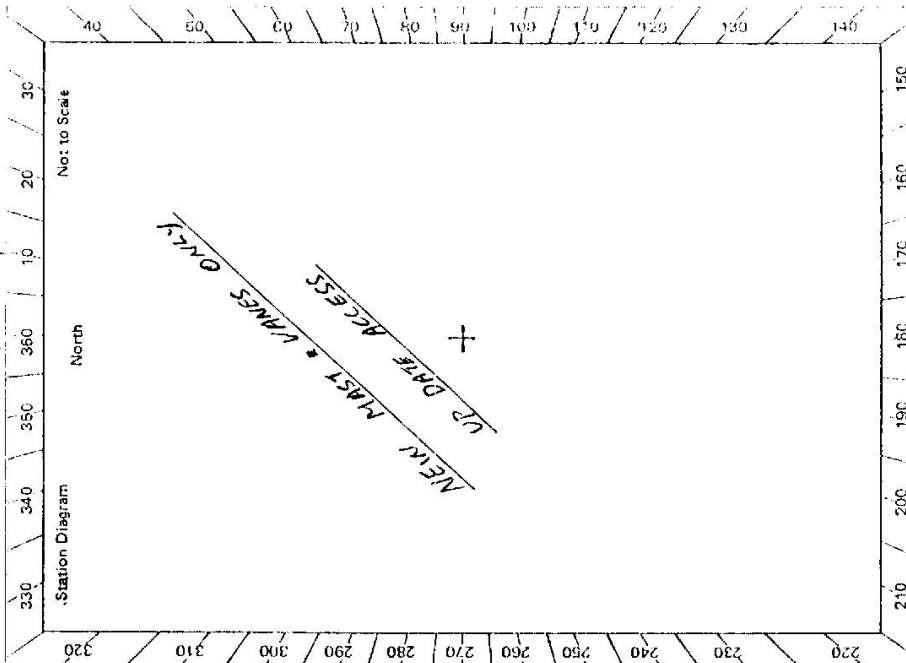

STANDPOINT:				STANDPOINT:			
Mark	Direction	Horiz. Distance	Height Difference	Mark	Direction	Horiz. Distance	Height Difference
			above standpt.				above standpt.
			below				below
			above standpt.				above standpt.
			below				below
Prepared by: *G Ford 10/10/94* Checked: *Noted on U.T.M. Card*

Checked

STATION **RED HILL GS (P) IS 6254**


Owner's Name: **MR B OSBORNE**
 Address: **"ELLENDON"**
 Phone: **38 12 33**

Current Occupant:
 Address:
 Phone:

ACCESS

Access Report of **28/1/1994** was found suitable/unsuitable.
0.00 BUNGENDORE RD. TRAVEL WEST TOWARDS GUNDAROO
0.6 TURN RIGHT TOWARDS GOULBURN (SIGN 6.68KM)
6.6 TURN LEFT INTO DIRT ROAD "LAHELANDS, CHARANDOOKEY, ELLENDON"
6.95 GRID 7.7 CAUSEWAY 8 GRID 9.45 GRID 11.0 GRID
11.3 VEER LEFT BETWEEN PINE TREES FOLLOW ROAD TO RIGHT SIGN POSTED ELLENDON
11.6 GRID 12.2 GRID
13.3 VEER LEFT 13.4 GRID
13.45 PASS DRIVEWAY TO OWNERS HOUSE
13.5 GRID
13.9 GRID
14.4 FOLLOW TRACK AROUND TO THE RIGHT
14.6 GATEWAY
15.0 PASS TRACK TO RIGHT
15.6 GATE
15.8 RED HILL PILLAR.

25 2733-2 D. West, Government Printer

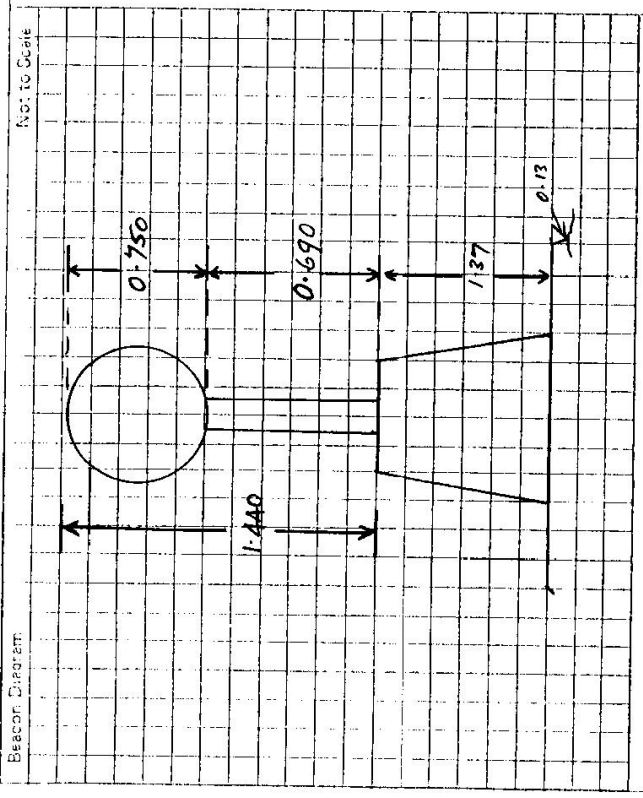

This section to be completed by officer constructing pillar.

Original station mark found/not found.

Description of mark:

Original beacon found/not found.

Description of beacon:

Height Top of Vanes to Top Markm.
 above rock/concm. below G.L.

Height of markm. abovem. below G.L.

Diameter of Vanesm. Height of Cairnm.

Original Beacon has/has not been destroyed by me.

Date	Record of Station