

CENTRAL MAPPING AUTHORITY

GEODETIC SURVEY OF N.S.W.
 GEODETIC STATION RECONNAISSANCE and MAINTENANCE REPORT

Description:

1. Cleared by lanes bearing $50^{\circ}M L 75^{\circ}M / 103^{\circ}M$ to $165^{\circ}M$ $235^{\circ}M$ & $266^{\circ}M$ from Trig, Mast

2. Mast & Vanes have been painted white & black respectively.

3. The station/pillar was ~~unplaced/not unplaced~~/constructed on 19 m, dimensions now being:

Description of mark $1.430^{\circ}M$ $1.430^{\circ}M$ should be explicit, e.g. S/Steel Pillar Plate, Steel plug, Brass plug, Bolt, G.I. Pipe

Height of mark 1.37 m above ~~mark~~/concrete; Mark is 1.53 m above G.L.

Height of Top Vanes to Top ~~mark~~/Pillar plate 1.430 m. Diameter of Vanes (vertical) 0.75 m.

Height of Cairn 1.37 m. Diameter of Cairn 1.37 m. Name Plate ~~found~~/not ~~found~~/placed.

Length of Mast 1.37 m. (approximate if not unplaced)

4. A. ~~Brass Trig Pillar~~ set in conc/~~rock~~ has been ~~placed~~/found, bearing $355^{\circ}M$ from ~~Mast/Vane~~/Pillar

5. A. ~~C.I. Pipe~~ set in conc/~~rock~~ has been ~~placed~~/found, bearing $258^{\circ}M$ from ~~Mast/Vane~~/Pillar

6. A. ~~SSM~~ set in conc/~~rock~~ has been ~~placed~~/found, bearing $50^{\circ}M$ from ~~Mast/Vane~~/Pillar


7. A. ~~SSM~~ set in conc/~~rock~~ has been placed/found, bearing $152^{\circ}M$ from ~~Mast/Vane~~/Pillar

8. Action required: ~~SSM~~

STANDPOINT: <u>Pillar Plate</u>			STANDPOINT: <u>Brass Trig Pole</u>			
Mark	Direction	Horiz. Distance	Height Difference	Direction	Horiz. Distance	Height Difference
<u>Picket GS</u>	<u>0 00 00</u>		<u>above</u> <u>standpt</u>	<u>0 00 00</u>		<u>above</u> <u>standpt</u>
<u>MAXVILLE GS (P)</u>	<u>64 36 34</u>	<u>2 262</u>	<u>above</u> <u>standpt</u>	<u>64 36 34</u>	<u>2 262</u>	<u>above</u> <u>standpt</u>
<u>Broken Top GS</u>	<u>193 50 22</u>		<u>below</u> <u>standpt</u>	<u>81 46 08</u>		<u>below</u> <u>standpt</u>
<u>C.I. Pipe</u>	<u>194 26 06</u>	<u>2 361</u>	<u>above</u> <u>standpt</u>	<u>111 13 06</u>	<u>2 742</u>	<u>above</u> <u>standpt</u>
<u>Brass Trig Pole</u>	<u>291 17 26</u>	<u>2 740</u>	<u>below</u> <u>standpt</u>	<u>149 02 19</u>	<u>3 025</u>	<u>above</u> <u>standpt</u>
<u>SSM</u>	<u>345 19 04</u>	<u>2 032</u>	<u>below</u> <u>standpt</u>			<u>below</u> <u>standpt</u>

Prepared by: [Signature] 10.12.78 Checked: [Signature] Noted on U.T.M. Card

SI 2733-1

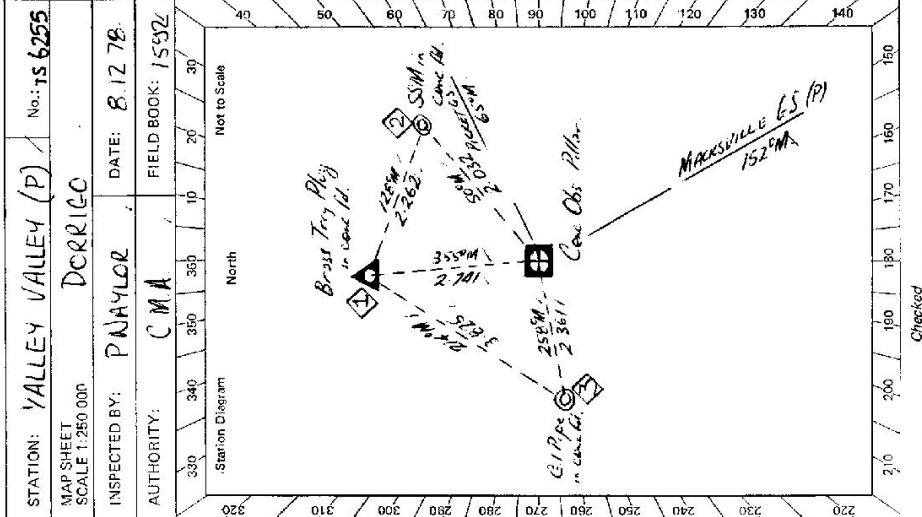

Checked

CENTRAL MAPPING AUTHORITY

GEODETIC SURVEY OF N.S.W.

GEODETIC STATION RECONNAISSANCE and MAINTENANCE REPORT

STATION: **VALLEY VALLEY [P]** No: **6255**

MAP SHEET SCALE 1:250 000


INSPECTED BY: **R. J. PIERCE** DATE: **20/3/83**

AUTHORITY: **D.M.R.** FIELD BOOK: **C5220**

Description: *Note: Cross out word or words which do not apply*

1. Cleared by lanes bearing **60° 56' M**, **102° 16' M**, **266° 26' M** from Trig. Mast
2. Mast & Vanes have been painted white & black respectively.
3. The station/pillar was ~~unplaced/not-emplaced/constructed on~~ **19** m, dimensions now being: Description of mark **S/STEEL PLATE** should be explicit, e.g., S/Steel Pillar Plate, Steel plug, Brass plug, Bolt, G.I. Pipe
Height of mark **1.37** m. ^{above} ~~mark~~/concrete: **1.43** ^{above} G.L.
Height of Top Vanes to ~~Top Mark~~/Pillar plate **1.37** m. Diameter of Vanes (vertical) **0.75** m.
Height of Cairn **1.37** m. Diameter of Cairn **1.37** m. Name Plate found/not-found/placed.
Length of Mast **1.37** m. (approximate if not unplaced)
4. A **1.37** m. set in conc/rock has been placed/found, bearing **60° 56' M** from Mast/Plug/Pillar
5. A **1.37** m. set in conc/rock has been placed/found, bearing **102° 16' M** from Mast/Plug/Pillar
6. A **1.37** m. set in conc/rock has been placed/found, bearing **266° 26' M** from Mast/Plug/Pillar
7. A **1.37** m. set in conc/rock has been placed/found, bearing **102° 16' M** from Mast/Plug/Pillar
8. Action required:


STANDPOINT:		STANDPOINT:					
Mark	Direction	Horiz. Distance	Height Difference	Mark	Direction	Horiz. Distance	Height Difference
			above standpt.				above standpt.
			below standpt.				below standpt.
			above standpt.				above standpt.
			below standpt.				below standpt.
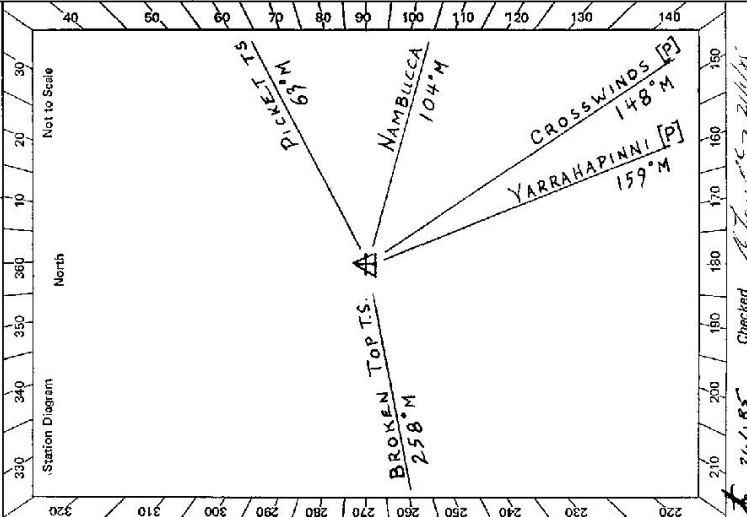

Prepared by: **R. J. Pierce** Checked: **R. J. Pierce** 21.1.85 Noted on U.T.M. Card

SI 2793-2 D. West, Government Printer

STATION VALLEY VALLEY [P] TS 6255

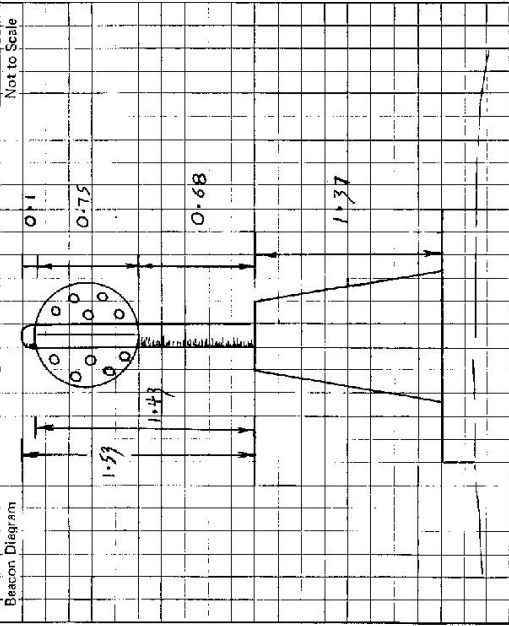

Owner's Name:
 Address:
 Phone:

Current Occupant:
 Address:
 Phone:

ACCESS

Access Report of 22/3/19 was found suitable/unsuitable.

This section to be completed by officer constructing pillar.

Original station mark found/not found.

Description of mark:

Original beacon found/not found.

Description of beacon:

Height Top of Vane to Top Mark m.

Height of mark m. above/ below

Diameter of Vane m. Height of Cairn m.

Original Beacon has/has not been destroyed by ma.

Date	Record of Station

ST 2733-2 D. West, Government Printer	STATION VALLEY VALLEY (P) TS 6255	Owner's Name: <u>ASST. PETER MILLS</u> Address: <u>BONVILLE</u> Phone: <u>0666 534248</u> Current Occupant: Address: Phone: ACCESS <u>8-12-1978</u> Access Report of <u>11/2/1978</u> was found suitable/ unsuitable . <u>KM</u> / 0.0 <u>BONVILLE PD TRAVEL TOWARD MACKSVILLE</u> / 1.1 <u>TURN LEFT - SIGN'S LITTLE LEEZ X BELLINGEN</u> / 5.6 <u>STRAIGHT AHEAD</u> / 6.7 <u>TURN RIGHT - SIGN BELLINGEN</u> / 11.2 <u>SHARP TURN RIGHT - THIS TURN IS JUST AFTER A VERY SHARP LEFT HAND BEND - IT IS DIFFICULT TO SEE AS IT FALLS AWAY FROM THE ROAD IN THE OPPOSITE DIRECTION TO WHICH YOU ARE TRAVELLING.</u> / 12.9 <u>TAKE RIGHT FORK - TRACK VERY STEEP</u> / 13.9 <u>VALLEY VALLEY PILLAR</u>
Beacon Diagram Not to Scale		Date
		Record of Station
This section to be completed by officer constructing pillar. Original station mark found/ not found . Description of mark: <u>BRASS TRIG PILE</u> Original beacon found/ not found . Description of beacon: <u>MAST VANES SUPPORTED BY WIRE STAYS</u> Height Top of Vanes to Top Mark: <u>1.395</u> m. Height of mark: <u>0.02</u> m. above G.L. below rock/cont. 0.22 m. below Diameter of Vanes: <u>1.0</u> m. Height of Cairn: Original Beacon has/ has not been destroyed by ms.		