


GEODETTIC SURVEY OF N.S.W.

CENTRAL MAPPING AUTHORITY

GEODETTIC STATION RECONNAISSANCE and MAINTENANCE REPORT

Description:

1. Cleared by lances bearing.....~~40~~.....~~345~~.....
 Note: Cross out word or words which do not apply
 from Trig. Mast
2. Mast & Vanes have been painted white & black respectively. ✓
3. The station/pillar was ~~unplaced/not supplied~~/constructed on.....~~19.18~~..... dimensions now being:
 Description of mark.....~~Steel~~..... should be explicit, e.g., S/Steel Pillar Plate, Steel plug, Brass plug, Bolt, G.I. Pipe
 Height of mark.....~~1.50~~.....^{above} ~~rock~~/concrete; Mark is ~~1.50~~.....^{above} G.L.
 Height of Top Vanes to Top ~~Mast~~/Pillar plate.....~~4.48~~..... m. Diameter of Vanes (vertical).....~~750~~..... m.
 Height of Cairn..... m. Diameter of Cairn..... m. Name Plate found/not found/Placed.
 Length of Mast..... m. (approximate if not supplied)
4. ~~Recess~~ ~~Iron~~ ~~Plate~~..... set in conc/~~rock~~ has been placed/~~found~~, bearing.....~~81~~.....° M from Mast/~~Wing~~/Pillar ✓
5. A.....~~G.I. Pipe~~..... set in conc/~~rock~~ has been placed/~~found~~, bearing.....~~39~~.....° M from Mast/~~Plug~~/Pillar ✓
6. A..... set in conc/~~rock~~ has been placed/~~found~~, bearing.....° M from Mast/~~Plug~~/Pillar
7. A..... set in conc/~~rock~~ has been placed/~~found~~, bearing.....° M from Mast/~~Plug~~/Pillar
8. Action required:.....

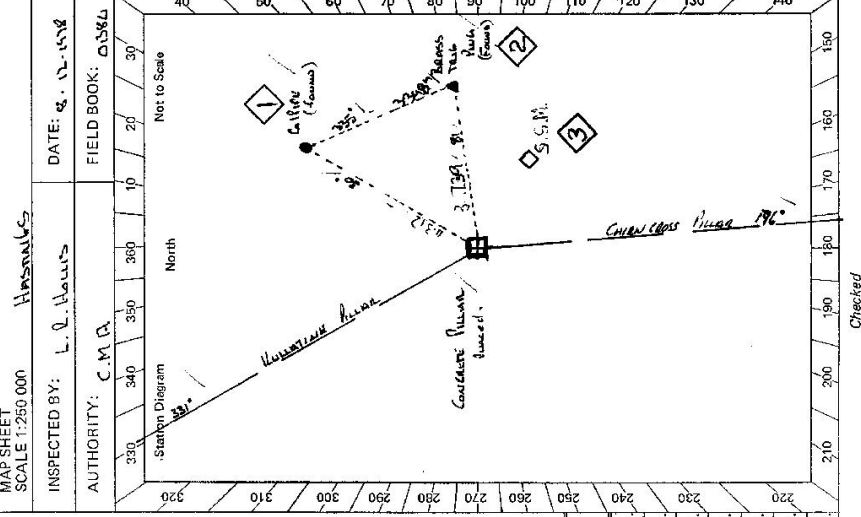

STANDPOINT: Pillar Plate		STANDPOINT: Brass Plate				
Mark	Direction	Horiz. Distance	Height Difference	Direction	Horiz. Distance	Height Difference
Kollatime P	0 00 00		above standpt.	0 00 00		above standpt.
G.I. Pipe	61 25 30	1.54	below standpt.	4 52 00	1.45	above standpt.
Brass Plate	10 43 40	1.57	below standpt.	20 45 40		below standpt.
Crosshair P	20 6 43	1.56	below standpt.	20 05 20	1.56	above standpt.
			below standpt.			below standpt.
			below standpt.			below standpt.
			below standpt.			below standpt.

Prepared by:


Checked:

Noted on U.T.M. Card

8: 2733-2 D. West, Government Printer

STATION

BALLENISBURA 6259

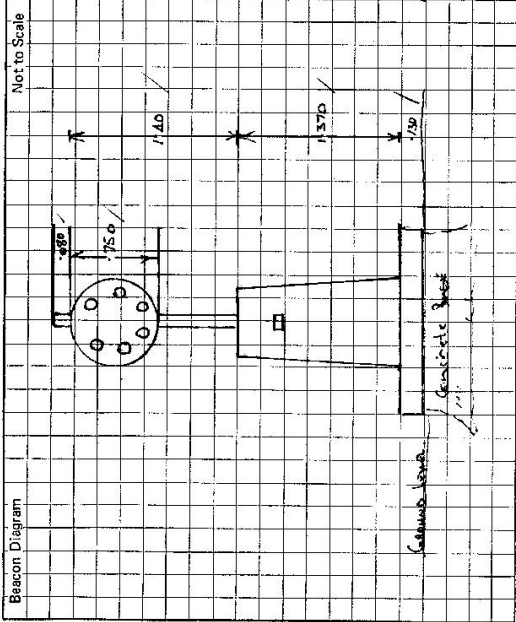

Owner's Name:
 Address:
 Phone:

Current Occupant: Mr. P. Gassman
 Address:
 Phone:

ACCESS

NY Access Report of 8/11/19. Was found suitable/unavailable.

50:00 From Pacific Highway as seen Westward. Take Merivale St. Roadside where
 SUN SHERWOOD IN DIRECTION OF R.
 Turn Left onto Dyer Rd
 Pass Downward to the Right
 Turn Right Sun Poles on Forest Rd
 Concrete Cornerway
 Turn Left
 Turn Left
 Turn Left Forel
 Locken Gate
 Common Corral

This section to be completed by officer constructing pillar.

Original station mark found/~~not found~~.

Description of mark:

Original beacon found/~~not found~~.

Description of beacon:

Height Top of Vanes to Top Mark: m.

Height of mark: m. above ~~weak/conc.~~ m. below G.L.

Diameter of Vanes: m. Height of Cairn: m.

Original Beacon has/~~has not been~~ destroyed by me.

Date	Record of Station

GEODETTIC SURVEY OF M.S.W

CENTRAL MAPPING AUTHORITY

GEODETTIC STATION RECONNAISSANCE and MAINTENANCE REPORT

Description:

1. Cleared by lanes bearing.....
 Note: Cross out word or words which do not apply
 from Trig. Mast
2. Mast & Vanes have been painted white & black respectively.
3. The station/pillar was unpiled/not unpiled/constructed on.....19....., dimensions now being:
 Description of mark.....should be explicit: e.g., S/Steel Pillar Plate, Steel plug, Brass plug, Bolt, G.I. Pipe
 Height of mark.....m.....^{above} rock/concrete; Mark is.....m.....^{above} G.L.
- Height of Top Vanes to Top Mark/Pillar platem. Diameter of Vanes (vertical).....m.
- Height of Cairn.....m. Diameter of Cairn.....m. Name Plate found/not found/placed.
- Length of Mast.....m. (approximate if not unpiled)
4. A.....set in conc/rock has been placed/found, bearing.....° M from Mast/Plug/Pillar
5. A.....set in conc/rock has been placed/found, bearing.....° M from Mast/Plug/Pillar
6. A.....set in conc/rock has been placed/found, bearing.....° M from Mast/Plug/Pillar
7. A.....set in conc/rock has been placed/found, bearing.....° M from Mast/Plug/Pillar
8. Action required:.....

STANDPOINT:

Mark	Direction	Horiz. Distance	Height Difference	Mark	Direction	Horiz. Distance	Height Difference
			above standpt.				above standpt.
			below standpt.				below standpt.
			above standpt.				above standpt.
			below standpt.				below standpt.
Prepared by:

Checked:

Noted on U.T.M. Card

St 2733-1

STATION: **BALENGARRA** No: **6259**

MAP SHEET SCALE 1:250 000 **HASTINGS**

INSPECTED BY: **C. DICKSON** DATE: **30th MARCH '13**

AUTHORITY: **C.M.A** FIELD BOOK: **173B**

North

ACCESS ONLY

+

(SEE REVERSE SIDE)

Not to Scale

