

GEODETTIC SURVEY OF N.S.W.

CENTRAL MAPPING AUTHORITY

GEODETTIC STATION RECONNAISSANCE and MAINTENANCE REPORT

STATION: Butterfly No.: 6264

MAP SHEET SCALE 1:250 000 4857465

INSPECTED BY: L.R.Hous DATE: 27th August 2015

AUTHORITY: C.M.A FIELD BOOK: 01651

- Description:
- Cleared by lanes bearing 360°  Note: Cross out word or words which do not apply from Trig. Mast
  - Mast & Vanes have been painted white & black respectively.
  - The station/pillar was reconstructed/constructed on Site. Trip.....19.78... dimensions now being:
  - Description of mark Steel Plate should be explicit, e.g., S/Steel Pillar Plate, Steel plug, Brass plug, Bolt, G.I. Pipe
  - Height of mark 1.44 m. <sup>above</sup> rock/concrete; Mark is 1.44 m. <sup>above</sup> G.L.
  - Height of Top Vanes to Top Mark/Pillar plate 1.430 m. Diameter of Vanes (vertical) 0.750 m.
  - Height of Cairn.....m. Diameter of Cairn.....m. Name Plate found/not found/placed.....
  - Length of Mast.....m. (approximate if not unplied)
  - A Brass Trip.....set in conc/rock has been placed/found, bearing 216° M from Mast/Plug/Pillar
  - A S.S.M.....set in conc/rock has been placed/found, bearing 197° M from Mast/Plug/Pillar
  - A C.M.A.....set in conc/rock has been placed/found, bearing 160° M from Mast/Plug/Pillar
  - A.....set in conc/rock has been placed/found, bearing.....° M from Mast/Plug/Pillar
8. Action required:.....

Mark	Direction	Horiz. Distance	Height Difference	Mark	Direction	Horiz. Distance	Height Difference
<u>Dial 65</u>	<u>0 00 00</u>			<u>Dial 60</u>	<u>0 00 00</u>		
<u>Dial 65.0.P</u>	<u>169 50 50</u>			<u>Rock Plate</u>	<u>167 51 00</u>	<u>4.721</u>	<u>-1.886</u>
<u>G.I. Plate</u>	<u>291 39 40</u>	<u>2.956</u>	<u>1347</u>	<u>Dial 65.0.P</u>	<u>169 50 20</u>		
<u>S.S.M</u>	<u>330 25 40</u>	<u>4.228</u>	<u>1398</u>	<u>G.I. Plate</u>	<u>200 33 10</u>	<u>3.934</u>	<u>+5.60</u>
<u>Brass Trip Pl</u>	<u>337 52 00</u>	<u>4.970</u>	<u>1490</u>	<u>S.S.M</u>	<u>281 21 20</u>	<u>2.153</u>	<u>+1.579</u>

STANDPOINT: Steel Trip Pl


STANDPOINT: Rock Trip Pl

Checked: L.R.Hous

Prepared by: L.R.Hous

Noted on U.T.M. Card

Sr 2733-1

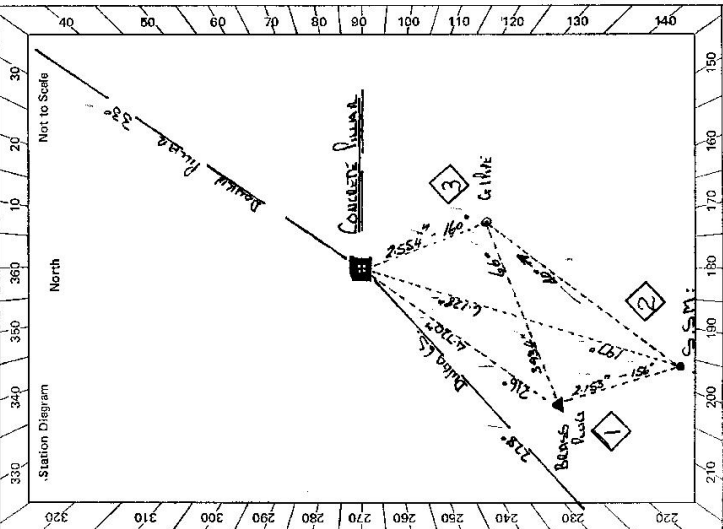


STATION BUTTERFLY - 6264

Owner's Name: Mr. Mark Anthony  
 Address: Butterfly, Co. Wick  
 Phone: 087 2345678

Current Occupant: Mark Anthony  
 Address: Butterfly, Co. Wick  
 Phone: 087 2345678

ACCESS  
 MY Access Report of 21/8/1978 was found suitable/unsuitable.

- / 0000 WALKWAY TO TOWER WTH
- / 0100 TOWER LEFT
- / 1000 TOWER RIGHT
- / 1100 TOWER LEFT SWAN ISLANDS
- / 7500 TOWER LEFT SWAN ISLANDS FISH II
- / 1500 TOWER LEFT NEW FOR PARKER'S OWNERS THE TOWER LIGHT
- / 1400 WALKWAY FLAT WTH
- / 2000 TOWER LIGHT AT VANDOS, THREMGH, JAW END, TOWER LIGHT
- / 2040 TOWER LEFT (GARDEN) BY FORCE INVESTIGATION
- / 2100 WIDE GARDEN, FENCED TOWER OF HILL AND RAIL LINE
- / 2300 LONDON RAIL LINE
- / 2400 GEORGE SPITHEAD.

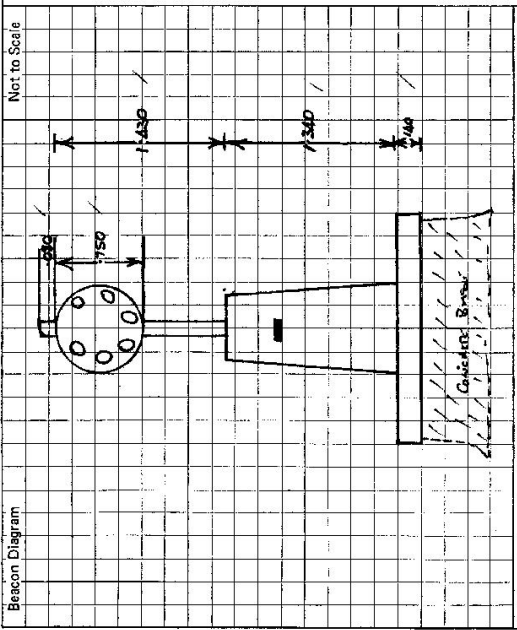

This section to be completed by officer constructing pillar.

Original station mark found/~~not found~~.

Description of mark: Butterfly, Co. Wick, Ireland

Original beacon found/~~not found~~.

Description of beacon: Concrete, Masonry, Dismantled

Height Top of Vanes to Top Mark: 2.332 m.

Height of mark: 0.750 m. above ~~below~~ G.L.

Diameter of Vanes: 1.000 m. Height of Cairn: 0.000 m.

Original Beacon has ~~been~~ been destroyed by me. ✓

Date	Record of Station

CENTRAL MAPPING AUTHORITY

GEODETTIC SURVEY OF N.S.W.

GEODETTIC STATION RECONNAISSANCE and MAINTENANCE REPORT

Description:

1. Cleared by lanes bearing All Round *Notes: Cross out word or words which do not apply* from Trig. Mast

2. Mast & Vanes have been painted white & black respectively, yes 30/27/15/86 dimensions now being: Replaced

3. The station either was omitted/not impeded/constructed on 1/5/1986

Description of mark Steel Plug/Pillar Plate should be explicit, e.g., S/Steel Pillar Plate, Steel plug, Brass plug, Bolt, G.I. Pipe

Height of mark 3.30 m, above rock/concrete; Mark is at m, above G.L.

Height of Top Vanes to Top Mark/Pillar plate 1.470 m. Diameter of Vanes (vertical) 0.750 m.

Height of Cairn 0 m. Diameter of Cairn 0 m. Name Plate found/not found/placed.

Length of Mast 0 m. (approximate if not unplied)

4. A. 0 set in conc/rock has been placed/found, bearing 0°M from Mast/Plug/Pillar

5. A. 0 set in conc/rock has been placed/found, bearing 0°M from Mast/Plug/Pillar

6. A. 0 set in conc/rock has been placed/found, bearing 0°M from Mast/Plug/Pillar

7. A. 0 set in conc/rock has been placed/found, bearing 0°M from Mast/Plug/Pillar

8. Action required: Vanes stolen, new vanes required

STANDPOINT:

STANDPOINT:

Mark	Direction	Horiz. Distance	Height Difference	Mark	Direction	Horiz. Distance	Height Difference
			above standpt				above standpt
			below				below
			above standpt				above standpt
			below				below
Prepared by: gllan

Checked: 13/6/86

Noted on U.T.M. Card

Checked

STATION: BUTTERFLY No. 6264  
 MAP SHEETS WINGHAM SCALE 1:100 000  
 SCALE 1:250 000 3334-2-2  
 INSPECTED BY: J. Sherwin DATE: 19/6/86  
 AUTHORITY: CMA FIELD BOOK: -

Station Diagram

Not to Scale

GS 24

<p>STATION <b>BUTTERFLY (P)</b> 6264</p> <p>Owner's Name: <b>SHANE (Jimmy) Fox</b></p> <p>Address: .....</p> <p>Phone: .....</p> <p>Manager: <b>Eric Fox</b></p> <p>Current Occupant: .....</p> <p>Address: .....</p> <p>Phone: .....</p> <p>ACCESS <b>19-5-86</b></p>	<p>Access Report of <del>XXXXXX</del> was found <del>unsuitable</del>/unsuitable.</p> <p>0:00 Wingham Po Travel North</p> <p>0:10 Turn <del>Left</del> <b>Right</b></p> <p>1:10 Turn <del>Left</del> <b>Right</b> Sign <b>ELANDS</b></p> <p>1:23 Turn <del>Left</del> <b>Right</b> Sign <b>WERRAL FLAT.</b></p> <p>7:80 Turn <del>Left</del> <b>Right</b></p> <p>20:20 Werral Flat Hall.</p> <p>21:36 Just past old School site turn right through wire gate</p> <p>21:44 Through Sliprails along fence East towards steep ridge.</p> <p>21:52 Through old fence line proceed straight up steep ridge.</p> <p>22:71 Ridge levels Bears left through scattered trees. FOLLOW RIDGE</p> <p>23:40 TRIG <b>VISIBLE AHEAD SLIGHTLY LEFT.</b></p> <p>24:45 GO THROUGH <b>SLIPRAILS. STRAIGHT UP STEEP RIDGE.</b></p> <p>25:26 BUTTERFLY G.S. (P)</p>
<p>Beacon Diagram</p> <p>TM 1570</p> <p>J.U. 1370</p> <p>SV. 1300</p> <p>0:00</p> <p>1300</p>	<p>This section to be completed by officer constructing pillar.</p> <p>Original station mark found/<del>not found</del>: <b>5/Steel Pillar Plate</b></p> <p>Description of mark: .....</p> <p>Original beacon <del>found</del>/not found.</p> <p>Description of beacon: <b>To be replaced</b> .....</p> <p>Height Top of Vanes to Top Mark .....m.</p> <p>Height of mark: .....m. above G.L. below G.L.</p> <p>Diameter of Vanes .....m. Height of Cairn .....m.</p> <p>Original Beacon has/has not been destroyed by me.</p>
<p>Date</p> <p>Records of Station</p>	