




84 2733-2 D. West, Government Printer

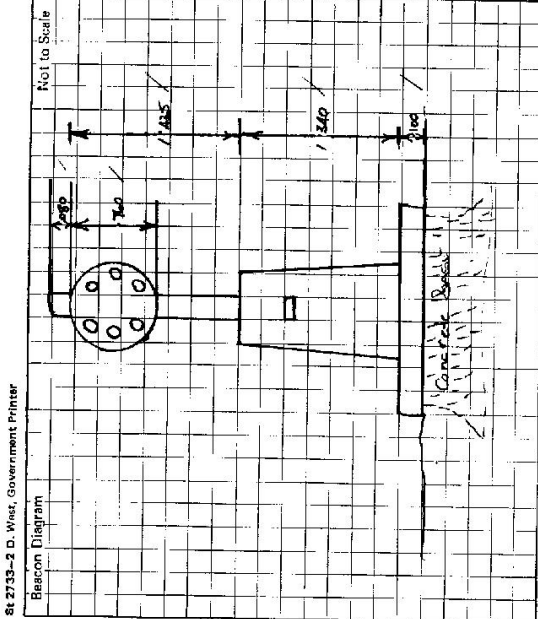

STATION **EVARDS, (P) TS 6265**

Owner's Name: .....  
 Address: .....  
 Phone: .....

Current Occupant: **North Queensland...**  
 Address: .....  
 Phone: .....

**ACCESS**

RV Access Report of 23/3/19 was found suitable/unsuitable.  
 EVARDS, P.O. GENERAL STORE, TOWN OF TOWNSWAY, QUEENSLAND  
 REFLECTOR SURMOUNT AND B.L. CAIRN  
 TOWER THROUGH WOODEN GATE  
 GEODETIC STATION :

This section to be completed by officer constructing pillar.

Original station mark found/~~not found~~.

Description of mark: ~~Concrete Pillar~~ **White Pillar**

Original beacon found/~~not found~~.

Description of beacon: **CRIMINAL MARK**

Height Top of Vanes to Top Mark: **4.033** m.

Height of mark: **0.87** m. ~~above~~ **below** G.L.

Diameter of Vanes: **1.20** m. Height of Cairn: **1.20** m.

Original Beacon has/~~has not~~ been destroyed by me.

Date	Record of Station



