

GEODETTIC SURVEY OF N.S.W.

CENTRAL MAPPING AUTHORITY

GEODETTIC STATION RECONNAISSANCE and MAINTENANCE REPORT

Description:

1. Cleared by lanes bearing $359^{\circ} 23' 28''$ to $15^{\circ} 19' 36''$ ~~to $203^{\circ} 22' 26''$ and $215^{\circ} 53' 57''$~~ from Trig. Mast

2. Mast & Vanes have been painted white & black respectively.

3. The ~~stand~~/pillar was ~~concrete~~ constructed on ~~SS M~~ ~~1350~~ ^{above} G.L. dimensions now being: 3.0 m. above concrete; 1.5 m. above G.L.

Description of marks SS.M should be explicit, e.g., S/Steel Pillar Plate, Steel plug, Brass plug, Bolt, G.I. Pipe

Height of mark 1350 m. above ~~mark~~ ^{above} G.L. Mark is 1515 m. above G.L.

Height of Top Vanes to Top ~~Mark~~/Pillar plate 1410 m. Diameter of Vanes (vertical): 76 mm.

Height of Cairn 1410 m. Diameter of Cairn 1410 mm. Name Plate found/not found/placed.

Length of Mast 1410 m. (approximate if not unpiled)

4. SS.M ~~mark~~ set in conc/~~rock~~ has been ~~found~~/found, bearing 301 °M from ~~mark~~/Pillar

5. SS.M ~~mark~~ set in conc/~~rock~~ has been ~~found~~/found, bearing 249 °M from ~~mark~~/Pillar

6. SS.M ~~mark~~ set in conc/~~rock~~ has been ~~found~~/found, bearing 345 °M from Mast/Plug/Pillar

7. SS.M ~~mark~~ set in conc/~~rock~~ has been placed/found, bearing °M from Mast/Plug/Pillar

8. Action required:

Mark	Direction	Horiz. Distance	Height Difference	Mark	Direction	Horiz. Distance	Height Difference
Booke GS	0 00 00	0 00 00	above standpt.	Booke GS	0 00 00	0 00 00	above standpt.
G.I. Pipe	26 07 10	3.005	above standpt.	G.I. Pipe	112 50 16	2.431	above standpt.
Big Hill GS	114 53 26		below standpt.	Big Hill GS	114 53 35		below standpt.
SS.M	287 51	20.30119	below standpt.	SS.M	157 31	14.327	above standpt.
Booke Trig. Level	337 32	46.1328	below standpt.	SS.M	202 09	30.311	below standpt.
			below standpt.				below standpt.
			below standpt.				below standpt.

STANDPOINT: Booke Trig. Plate

Noted on U.T.M. Card

Checked:

Prepared by: Platts 15.12.78

S: 2733-1

STATION: DAL Hill G.I. KILGAE No: TS 6272

MAP SHEET HASTINGS

INSPECTED BY: P. PLATTS DATE: 6-12-78

AUTHORITY: C.M.A. FIELD BOOK: 1669

Station Diagram

North

Not to Scale

Checked


STATION **443 Hill Hill** TS **6272**

Owner's Name: **Mr. M. G. S. S. S.**
 Address: **443 Hill Hill**
 Phone: **VIA WILLOW**
 Current Occupant:
 Address:
 Phone:

ACCESS

Access Report of **6/12/2018** was found suitable/unsuitable.

- 6100 **FEATURE**
- 6100 **P.C. WILLOW TRAVEL SOUTH TOWARDS MAIN STREET.**
- 620 **CROSS INTERSECTION - FOLLOW SIGN CALDWELL.**
- 630 **TURN RIGHT SIGN NIMMALA W.**
- 630 **TURN RIGHT OAK HILL CROSS OVER.**
- 630 **PASS GATE TO MR. WOODMACK'S HOUSE.**
- 630 **GATE.**
- 670 **IRON GATE - YARD ON RIGHT.**
- 680 **TAKE FAINT TRACK TO LEFT.**
- 690 **IRON GATE AT FENCE BORDER - GO THROUGH AND**
- 710 **TURN RIGHT - FOLLOW FAINT TRACK ALONG FENCE LINE**
- 710 **IRON GATE AT FENCE INTERSECTION**
- 710 **FOLLOW FAINT TRACK TO TOP OF RIDGE**
- 710 **TO TRAIL.**
- 710 **GENETIC SECTION OAK HILL**

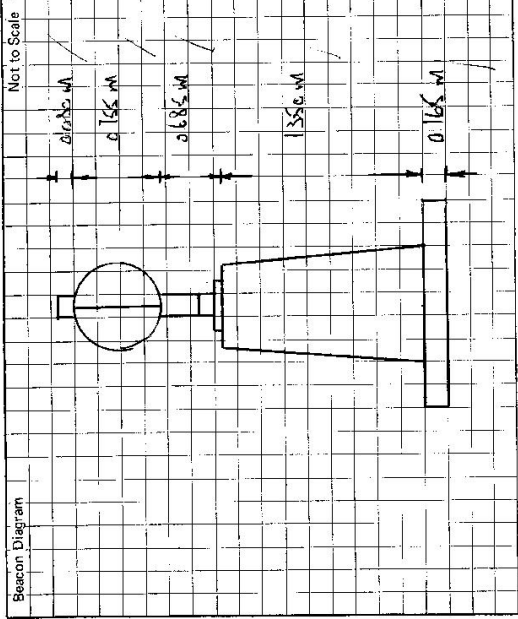

8r-2733-2 D. West, Government Printer

This section to be completed by officer constructing pillar.

Original station mark found/.....
 Description of mark: **BRASS TUBE PILE**
 Original beacon found/.....
 Description of beacon: **CONC. BASE & DISC**
 Height Top of Vanes to Top Mark: **3.645** m.
 Height of mark: **0.035** m. above G.L.
 Diameter of Vanes: **1.615** m. Height of Cairn: **1.290** m.
 Original Beacon has/..... been destroyed by me.

Date	Record of Station