

GEODETTIC SURVEY OF N.S.W.

CENTRAL MAPPING AUTHORITY

GEODETTIC STATION RECONNAISSANCE and MAINTENANCE REPORT

STATION: *Albionville P.* No.: *6274*

MAP SHEET: *1:250 000*


INSPECTED BY: *L. J. HOLLIS*

DATE: *18.11.1978*

AUTHORITY: *C.M.A.*

FIELD BOOK: *ALBIONVILLE*

- Note: Cross out word or words which do not apply*
1. Cleared by lanes bearing.....m. *from Mast*..... from Trig. Mast
  2. Mast & Vanes have been painted white & black respectively. ✓
  3. The station/pillar was ~~replaced~~ constructed on *16.11.1978*..... dimensions now being: Description of mark..... should be explicit, e.g., S/Steel Pillar Plate, Steel plug, Brass plug, Bolt, G.I. Pipe Height of mark.....m. <sup>above</sup> rock/concrete; Mark is *SSM*.....m. <sup>above</sup> G.L.
  - Height of Top Vanes to Top Mark/Pillar plate *1.445*.....m. Diameter of Vanes (vertical) *2.52*.....m.
  - Height of Cairn.....m. Diameter of Cairn.....m. Name Plate found/not found/placed.
  - Length of Mast.....m. (approximate if not unpeeled)
  4. *Replaced*.....set in conc./rock has been placed/found, bearing.....°M from Mast/Plug/Pillar
  5. *SSM*.....set in conc./rock has been placed/found, bearing.....°M from Mast/Plug/Pillar
  6. *SSM*.....set in conc./rock has been placed/found, bearing.....°M from Mast/Plug/Pillar
  7. *SSM*.....set in conc./rock has been placed/found, bearing.....°M from Mast/Plug/Pillar
  8. Action required:.....

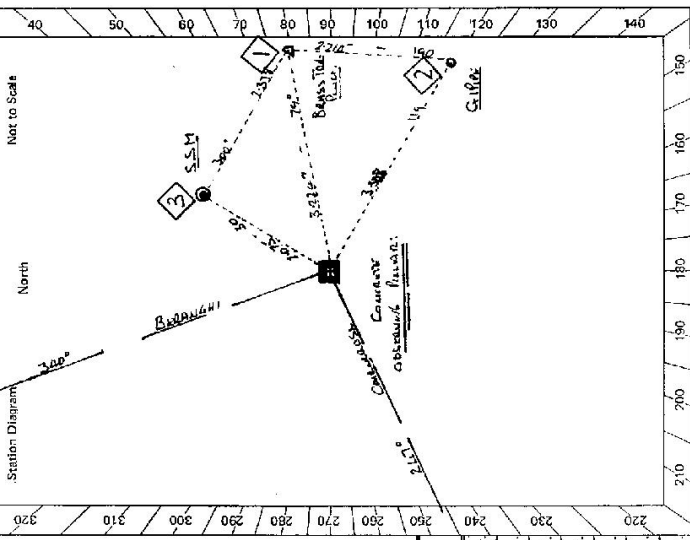

STANDPOINT: <i>Pillar Plate</i>		STANDPOINT: <i>SSM</i>	
Mark	Direction	Horiz. Distance	Height Difference
<i>REDAUGHLI P.</i>	<i>0 00 00</i>		above standpt.
<i>SSM</i>	<i>08 43 00</i>	<i>2.214</i>	below standpt.
<i>BRASS PLUG</i>	<i>265 24 50</i>		below standpt.
<i>C.M.A.</i>	<i>280 45 50</i>	<i>3.224</i>	above standpt.
<i>CAIRN</i>	<i>320 49 10</i>	<i>2.52</i>	below standpt.

Prepared by: *L. J. Hollis* Checked: *L. J. Hollis* *Noted on U.T.M. Card*

St 2733-2 D. West; Government Printer Beacon Diagram	Not to Scale 	STATION <u>NOONBA P. TS 6274</u> Owner's Name: <u>MISS ANITA RAMFIS</u> Address: ..... Phone: ..... Current Occupant: <u>NATIONAL PARKS</u> Address: <u>(M. JOHN WATSON)</u> Phone: ..... ACCESS MY Access Report of 18/11/1978 was found suitable/unavailable. 00.00 <u>CONCRETE HEAD P.O. TOWER WEST</u> 0.05 <u>TOW RIGHT</u> 0.10 <u>TOW LEFT TOWERS NORTHWEST</u> 0.40 <u>TOW LEFT SURF TOW MARKED BY TOW NUMBER 10</u> 11.40 <u>BEACON</u> 11.65 <u>TOW LEFT OFF R</u> 11.90 <u>GROUND STATION</u>
This section to be completed by officer constructing pillar. Original station mark found/ <del>not found</del> . Description of mark: <u>CONCRETE TOW P.O.</u> Original beacon found/ <del>not found</del> . Description of beacon: <u>CONCRETE TOW P.O.</u> Height Top of Vanes to Top Mark: <u>3.22</u> m. Height of mark: <u>0.62</u> m. above <del>below</del> G.L. Diameter of Vanes: <u>0.16</u> m. Height of Cairn: <u>0.20</u> m. Original Beacon has/ <del>has not</del> been destroyed by me.		Record of Station Date ..... ..... .....



STATION T.S. 3541 NOONIAN (P) IS 6274


Owners Name.....

Current Occupant.....


Address.....

Address.....

Access  
from Crescent Head 10 km.

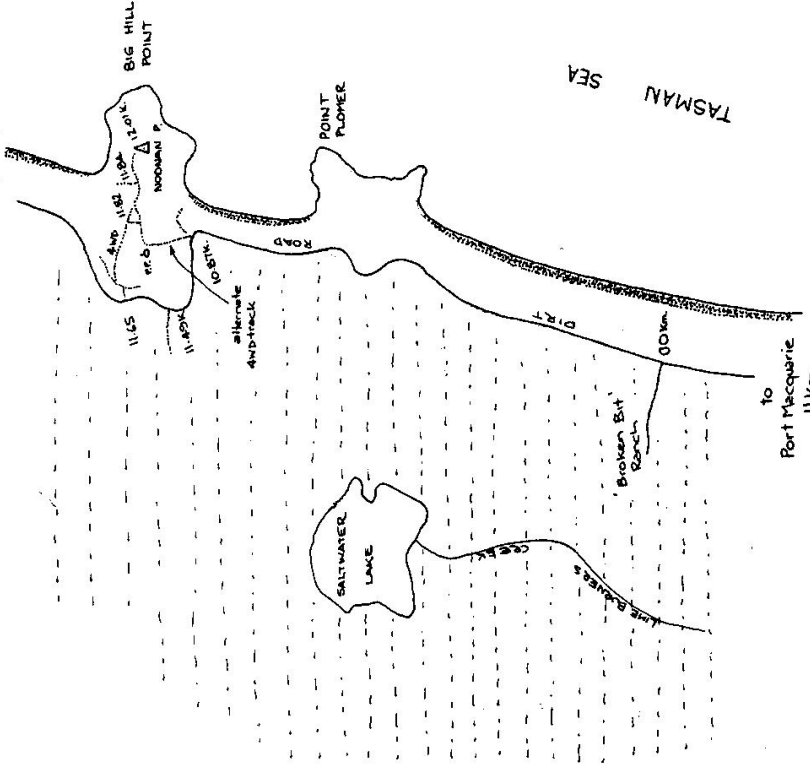

Station Diagram

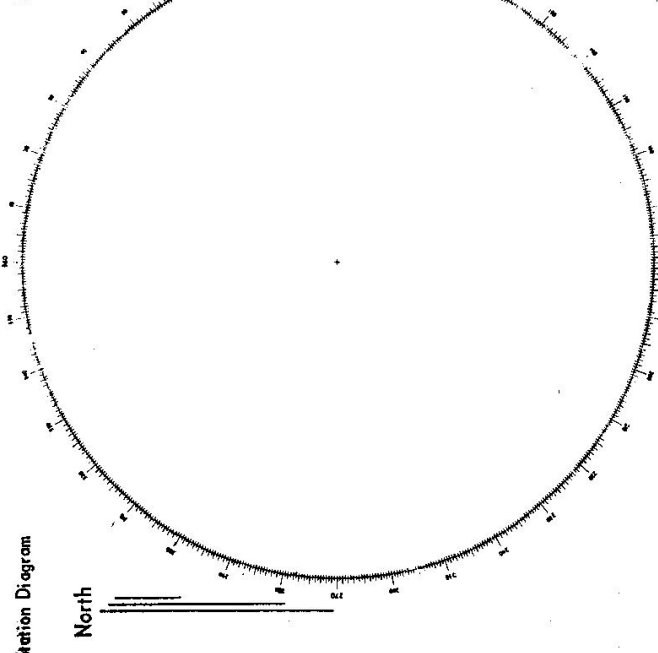

List of Observed Directions:-

Standpoint:		Standpoint:	
Station	Direction	Station	Direction

CENTRAL MAPPING AUTHORITY

GEODETIC STATION RECONNAISSANCE and MAINTENANCE REPORT

Description:

1. Cleared by lanes bearing  $130^{\circ} 00' M - 217^{\circ} 00' M$ ,  $239^{\circ} 00' M - 245^{\circ} 00' M$ ,  $55^{\circ} 00' M - 330^{\circ} 00' M$  from Trig. Mast

2. Mast & Vanes have been painted white & black respectively.

3. The station pillar was ~~replaced~~ not unpiled/constructed on 11th March 1987, dimensions now being:

Description of mark: ~~Steel~~ Steel Pillar Plate, Steel plug, Brass plug, Bolt, G.I. Pipe

Height of mark:  $1.36$  m. above ~~feet~~ feet/concrete; Mark is  $1.53$  m. above G.L.

Height of Top Vanes to Top ~~Mark~~ Pillar plate:  $1.815$  m. Diameter of Vanes (vertical):  $0.75$  m.

Height of Cairn: ..... m. Diameter of Cairn: ..... m. Name Plate found/ ~~not found~~ placed.

Length of Mast:  $7.00$  m. (approximate if not unpiled)

4. ~~At~~ SSM set in conc. ~~feet~~ feet has been ~~placed~~ found, bearing  $29^{\circ} 00' M$  from Mast ~~Plug/Pillar~~

5. ~~A Brass Trig. Plug~~ Plug set in conc. ~~feet~~ feet has been ~~placed~~ found, bearing  $76^{\circ} 00' M$  from Mast ~~Plug/Pillar~~

6. ~~A G.I. Pipe~~ Pipe set in conc. ~~feet~~ feet has been ~~placed~~ found, bearing  $119^{\circ} 00' M$  from Mast ~~Plug/Pillar~~

7. A ..... set in conc./rock has been placed/ found, bearing .....  $^{\circ} M$  from Mast ~~Plug/Pillar~~

8. Action required: Clear lantern & stacking


STANDPOINT:

Mark	Direction	Horiz. Distance	Height Difference	Mark	Direction	Horiz. Distance	Height Difference
			above standpt				above standpt
			below standpt				below standpt
			above standpt				above standpt
			below standpt				below standpt
Prepared by: J. S. ... 11/3/87

Checked: ...


Noted on U.T.M. Grid

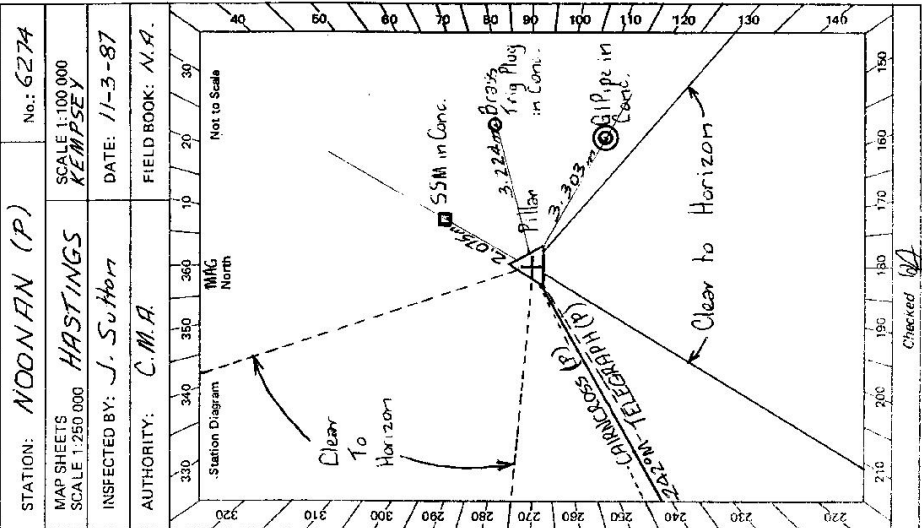

Checked: ...

© 2730-2 © West Government Printer

Beacon Diagram

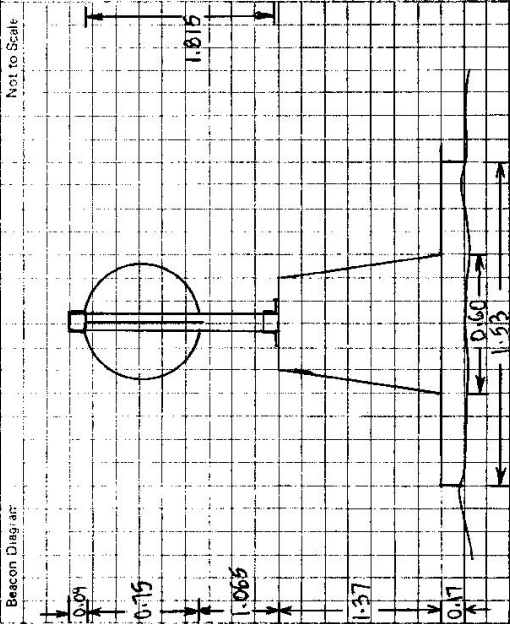

This section to be completed by officer constructing pillar.

Original station mark found/~~not found~~.

Description of mark: .....

Original beacon found/~~not found~~.

Description of beacon: .....

Height Top of Vanes to Top Mark.....m.

Height of mark.....m. above rock/conc.....ft. below G.L.

Diameter of Vanes.....m. Height of Cairn.....m.

Original Beacon has/has not been destroyed by me.

STATION

NOONAN (P) TS 6274

Owner's Name: .....

Address: .....

Phone: .....

ACCESS 11-3-1987

Access Report of 18/7/18/22 was found ~~unsuitable~~/unsuitable.

Kms  
 0.00 From Crescent Head Post Office travel west towards Kempsey (along Pacific St)  
 0.35 Turn left at signpost 'Point Plummer 16'  
 11.90 Cross bridge  
 12.75 Turn left off road and follow NPWS trail to Trig.  
 13.00 Geodetic Station.

Date

Record of Station