


St: 2783-2 D. West, Government Printer

STATION Boiga TS: 6277

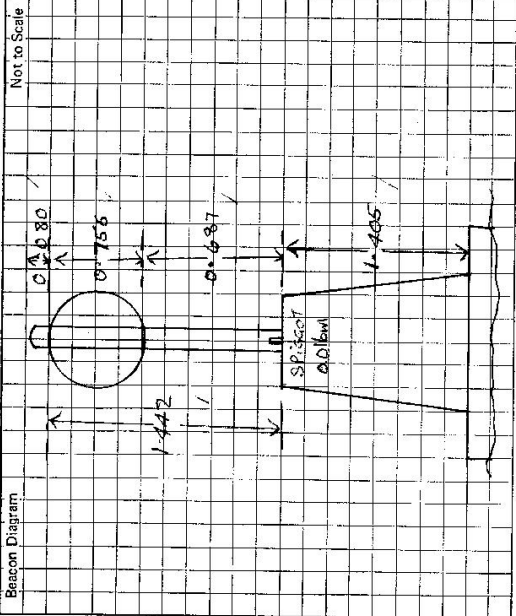

Owner's Name: JOHN HARSH
 Address:
 Phone:
 Current Occupant:
 Address:
 Phone:

ACCESS
 Access Report of 6/11/1978 was found suitable Access.

This section to be completed by officer constructing pillar.

Original station mark found/~~not found~~.
 Description of mark: BRASS PINS IN ROCKS
 Original beacon found/~~not found~~.
 Description of beacon: CAIRN MADE OF VANES
 Height Top of Vanes to Top Mark: 3.972 m.
 Height of mark: 0.038 m. above rock/beam. below G.L.
 Diameter of Vanes: 0.215 m. Height of Cairn: 1.70 m.
 Original Beacon has/~~has not been destroyed~~ by me.

Date	Record of Station