

STATION BIRDS R & TS 6278

Owners Name..... Current Occupant.....

Address..... Address.....


14-7-1975

Access
 LITHGOW POST OFFICE 0.600m.
 TAKE ROAD NORTH TO NENNES PMST OLD STAKE PINE.
 TURN LEFT AT 6.93m AT TRACK OLD HOUSE ON RIGHT AT
 TURNOFF. FOLLOW MAIN TRACK.
 Take rightward fork at 8.5m (SSM in cone at fork).
 Take track to right at 13.1m
 TS is inside road at 13.6m.

Not to Scale

Station Diagram

North

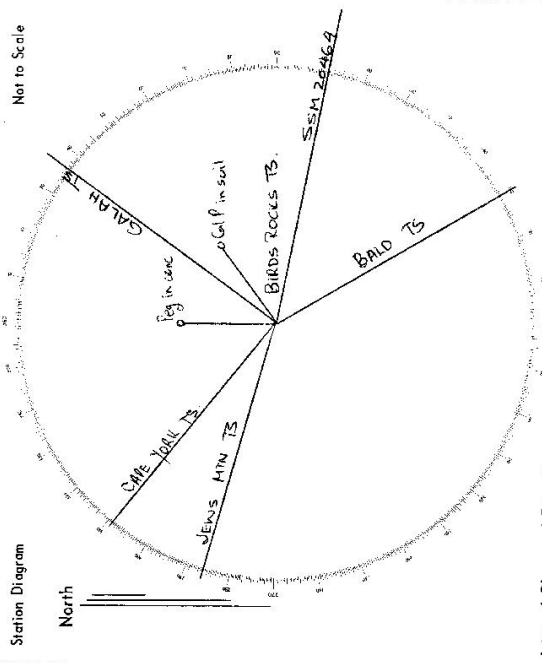


List of Observed Directions:-

| Stationpoint: TRIG PLUG | | Stationpoint: TRIG PLUG | |
|-------------------------|------------|-------------------------|------------|
| Station | Direction | Station | Direction |
| SSM 20464 | 0°00'00" | SSM 20464 | 0°00'00" |
| BALD TS | 48°05'20" | BALD TS | 48°05'23" |
| JEWIS MTN TS | 185°54'38" | PEG IN CONC | 249°58'34" |
| GALAH TS | 306°25'58" | GA. PIPE IN SOIL | 312°41'05" |
| TRIG PLUG | | TRIG PLUG | |
| Station | Direction | Station | Direction |
| BALD TS | 0°00'00" | | |
| JEWIS MTN TS | 137°49'15" | | |
| CAPE YORK TS | 158°49'34" | | |

| | |
|--|--|
| STATION <u>6085 Rock</u> * <u>6278</u> | Owner's Name: Address: Phone: Current Occupant: Address: Phone: ACCESS Access Report of <u>11/19</u> was found suitable/unavailable. <u>LITHGOW</u> 0-0 LITHGOW PASS DIFILE, TRAVEL EAST ALONG RAILWAY PDE 1-5 TURN LEFT INTO ATKINSON ST. 2-2 RAIL CROSSING 4-3 "SHEW" STATE MINE ROAD 5-4 PASS ROAD SIGN (CLARKE & SPURRY) 10-6 TURN LEFT ONTO BRANNYSIDE RD 12-6 FORK, GO RIGHT 13-2 FORK, GO RIGHT, SIGN SUNNYSIDE 15-9 /300 GO LEFT 16-8 PASS TRAIL ON RIGHT 20-4 FORK, TURN RIGHT 21-0 TURN LEFT, G.S. |
| Beacon Diagram Not to Scale | This section to be completed by officer constructing pillar. Original station mark found/not found. Description of mark: <u>S/S TRIG PLAG</u> Original beacon found/not found. Description of beacon: <u>CARR MARB - VAINES</u> Height Top of Vanes to Top Mark: <u>3.640</u> m. Height of mark <u>0.050</u> m. above G.L. below <u>mark/cont</u> m. below G.L. Diameter of Vanes: <u>1.010</u> m. Height of Cairn: <u>1.00</u> m. Original Beacon has/not been destroyed by me. |
| | Date: Record of Station: |

St 2733-2 D. Watt, Government Printer

STATION Bridges Rock 6278

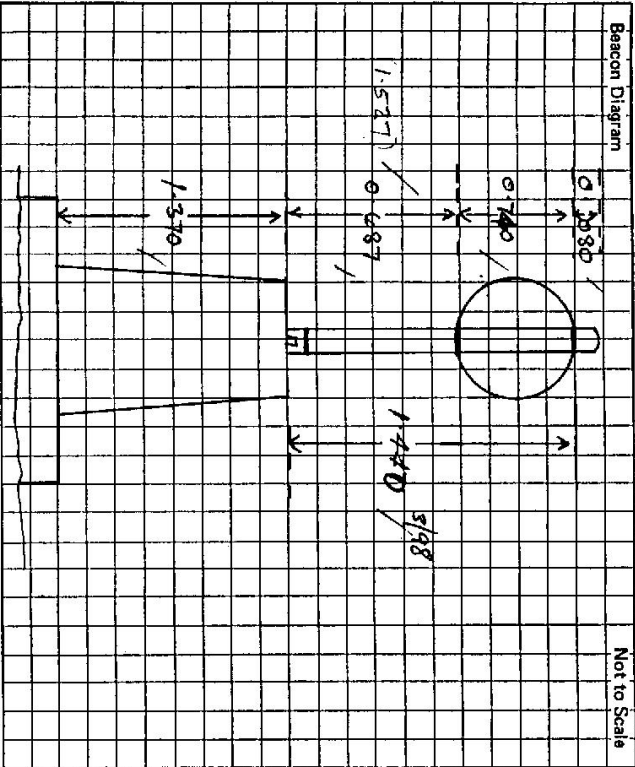

Original station mark found/~~not found~~:
 Description of mark: S/S TRIG PLUG

Original beacon found/~~not found~~:
 Description of beacon: CAIRN MAST & VANES

Height Top of Vanes to Top Mark: 3.640 ✓

Height of mark: 0.527 above rect/conc below rect/conc m. above G.L.

Diameter of Vanes: 1.010 m. Height of Cairn: 1.00 m.

Original Beacon has/has not been destroyed by me.

Owner's Name:
 Address:
 Phone:
 Access Report of: 1/19 was found suitable/unsuitable.
LITHGOM.

Current Occupant:
 Address:
 Phone:
 ACCESS

0.0 LITHGOM POST OFFICE, TRAVEL EAST ALONG RAILWAY ROE, LEFT, TURN RIGHT INTO INCH ST
 1.5 TURN LEFT INTO ATKINSON ST.
 2.2 RAIL CROSSING
 4.3 "SLOW" STATE MINE MT ROAD
 5.4 PASS ROAD SIGN CLARENCE SYDNEY
 10.6 TURN LEFT ONTO ~~Brownysoe Rd~~ BLACKFELLOWS HANNS FIRE TRAIL
 12.6 FORK, GO RIGHT
 13.2 FORK, GO RIGHT SIGN SUNNYSIDE
 13.9 FORK GO ~~LEFT~~ FOLLOW MAIN ROAD STURMANT AHEAD
 18.8 PASS TRACK ON RIGHT
 20.4 FORK, TURN RIGHT
 21.0 TURN LEFT, G.S.

INSPECTED BY: G. FORD DATE: MARCH 1998

Date: Record of Station: