

STATION Wang IS (P) TS 6282


Current Occupant

Owners Name


Address

3-9-1976

Access 4WD in wet conditions (to point where vehicle is left) then 1/2 hour walk

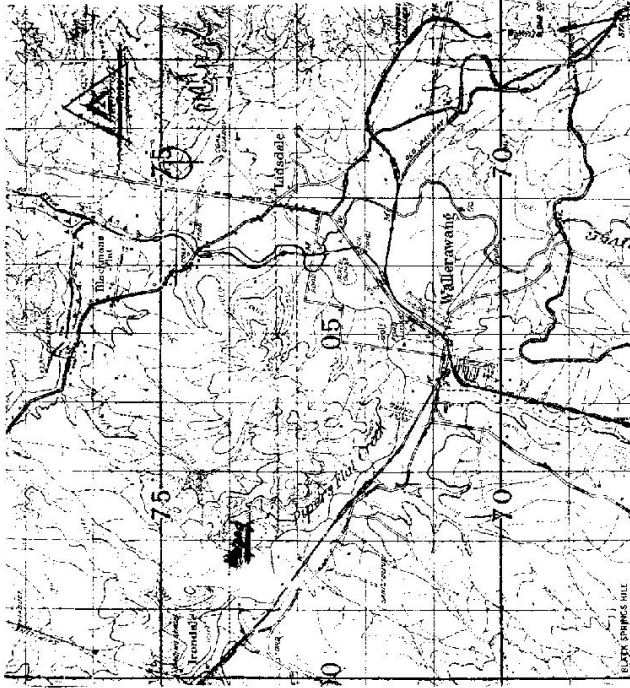

D. West, Government Printer, New South Wales - 1976

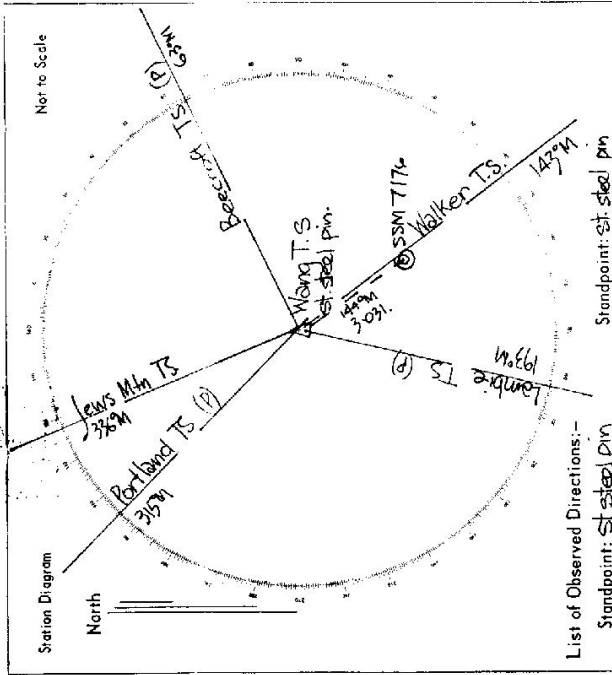

List of Observed Directions:-

Standpoint: st. steel pin		Standpoint: st. steel pin	
Station	Direction	Station	Direction
Walker T.S. (P)	359° 51' 60"	Beacraft T.S. (P)	359° 51' 60"
Lambie T.S.	149° 40' 55.8"	SSM 7176	79° 52' 46.5"
Lewis Mtn T.S.	193° 16' 22.7"	Lambie T.S. (P)	128° 46' 58.5"
Beacraft T.S. (P)	268° 51' 55.4"		
st. steel pin		st. steel pin	
Station	Direction	Station	Direction
Lewis Mtn T.S.	359° 51' 60"		
Lambie T.S. (P)	246° 24' 35"		
Portland T.S. (P)	347° 09' 57"		

GEODEIC SURVEY OF N.S.W.

CENTRAL MAPPING AUTHORITY

GEODEIC STATION RECONNAISSANCE and MAINTENANCE REPORT

Description:

1. Cleared by lanes bearing. $55^{\circ} 96'$, $125^{\circ} 145'$, $161^{\circ} 175'$, $188^{\circ} 197'$, 235° from Trig. Mast

2. Mast & Vanes have been painted white & black respectively.

3. The station/pillar was ~~unplaced~~/constructed on $5-12$1976..... dimensions now being:

Description of mark **R/T Pillar** should be explicit, e.g., S/Steel Pillar Plate, Steel plug, Brass plug, Bolt, G.I. Pipe

Height of mark 3.00 m. ^{above}/_{below} reek/concrete; Mark is.....m. ^{above}/_{below} G.L.

Height of Top Vanes to Top Mark/Pillar plate 1.43 m. Diameter of Vanes (vertical) 0.753 m.

Height of Cairn.....m. Diameter of Cairn.....m. Name Plate found/~~not found~~/placed.

Length of Mast 1.513 m. (~~approximate if not applied~~)

4. A **S/S Trig. Plug** set in conc/rock has been placed/found, bearing 181° M from Mast/Plug/Pillar

5. A **S.S.M. 7176** set in conc/reek has been placed/found, bearing 160° M from Mast/Plug/Pillar

6. A **Copper Nail** set in conc/reek has been placed/found, bearing 114° M from Mast/Plug/Pillar

7. A..... set in conc/rock has been placed/found, bearing..... M from Mast/Plug/Pillar

8. Action required:.....


STANDPOINT: Roof Top Pillar				STANDPOINT: S/S Trig. Plug			
Mark	Direction	Horiz. Distance	Height Difference	Mark	Direction	Horiz. Distance	Height Difference
Walker Pillar	$359^{\circ} 59' 60''$		above standpt.	Walker Pillar	$359^{\circ} 59' 60''$		above standpt.
S/S Trig Plug	$39^{\circ} 14' 00''$	$2.540/1.914$	above standpt.	S.S.M 7176	$00^{\circ} 45' 15''$	3.029	above standpt.
S.S.M 7176	$18^{\circ} 13' 40''$	$5.258/1.551$	above standpt.	Jews Mount P.	$193^{\circ} 16' 25''$		above standpt.
Jews Mount P.	$193^{\circ} 15' 45''$		above standpt.	Wang R/T Pillar	$219^{\circ} 15' 40''$	2.538	above standpt.
Copper Nail	$331^{\circ} 15' 00''$	$2.165/1.484$	above standpt.	Copper Nail	$268^{\circ} 39' 20''$	2.647	above standpt.
			below standpt.				below standpt.
			below standpt.				below standpt.

Prepared by:

Checked: **W. K. 12-76**

Noted on U.T.M. Card

ST 2733-1

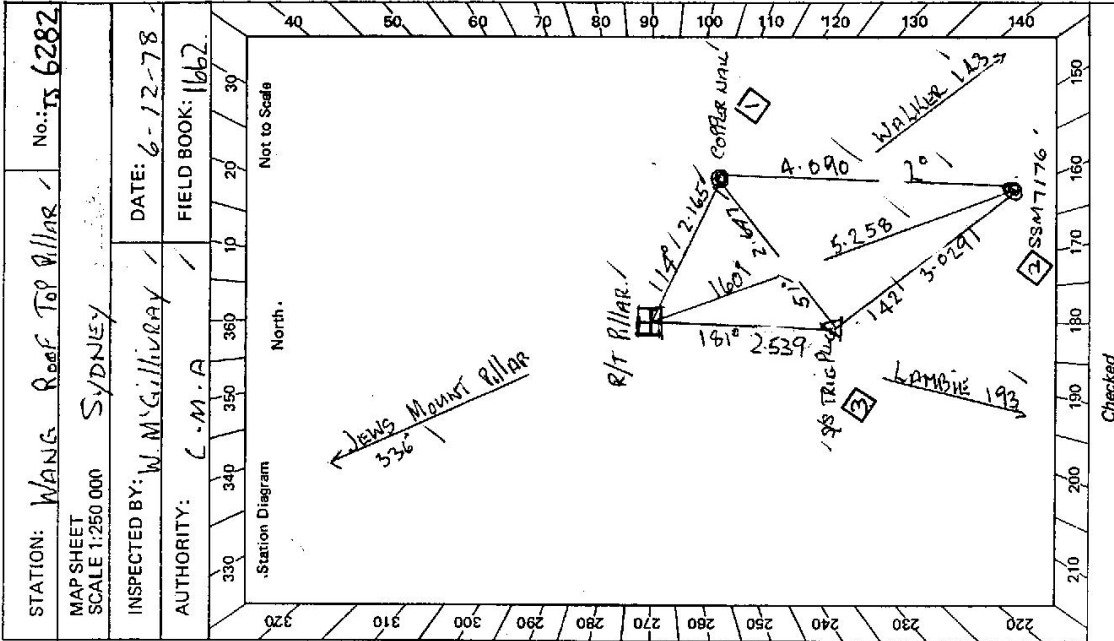

Checked

STATION: **WANG Roof Top Pillar** / No.: **TS 6282**

MAPSHEET SCALE 1:250 000 **SYDNEY**

INSPECTED BY: **W. M. Gillivray** / DATE: **6-12-78**

AUTHORITY: **C.M.A.** / FIELD BOOK: **1662**

STATION **WANG R/T PILLAR TS 6282**

Owner's Name:
 Address: **Willow Trees**
 Phone:


Current Occupant:
 Address:
 Phone:

ACCESS

Access Report of **6.12.1978** was found suitable/unsuitable.

WALLERAWANG

- 0.0 Post Office WALLERAWANG, TRAVEL TOWARDS PORTLAND.
- 0.7 TURN RIGHT OVER GRID SIGN ON GATE "WILLOW TREES"
- 1.1 TURN RIGHT THROUGH GATE HOUSE ON LEFT. DRIVE PAST HOUSE & SHEDS, GATE.
- 1.3 GATE.
- 1.6 RISK CROSSING
- 1.8 GATE.
- 2.6 GATE.
- 3.4 GATE.
- 3.7 GATE.
- 4.2 WIRE GATE BETWEEN 2 CAIRNS
- 4.8 TURN RIGHT ONTO GRAVEL TRACK, TRACK LEAD TO PORTLAND ROAD (2 LOCKED GATES)
- 5.0 TAKE TRACK UP HILL RED TANK ON RIGHT.
- 5.4 TURN RIGHT ONTO BUSH TRACK.
- 5.6 END OF TRACK WITHOUT "WILCH"

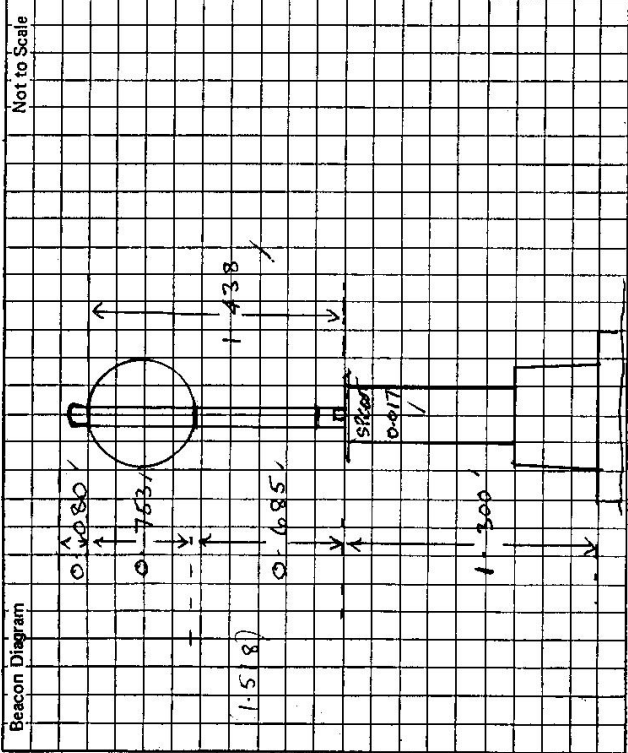

Not to Scale

This section to be completed by officer constructing pillar.

Original station mark found/~~not found~~.

Description of mark: **S/S TRIG. PLUG**

Original beacon found/~~not found~~.

Description of beacon: **CAIRN MAST & VANES**

Height Top of Vanes to Top Mark: **3.615** ✓

Height of mark **0.25** above rock/ **0.60** above G.L. ✓
 below

Diameter of Vanes **1.010** ✓

Height of Cairn **0.70** ✓

Original Beacon has/~~has not~~ been destroyed by me.

Date	Record of Station

GEODETTIC SURVEY OF M.S.W.

CENTRAL MAPPING AUTHORITY

GEODETTIC STATION RECONNAISSANCE and MAINTENANCE REPORT

Description:

- Note: Cross out word or words which do not apply*
- Cleared by lances bearing... ~~50m~~ ^{10m} ~~of~~ ^{to} ~~lance~~ ^{only} ~~from~~ ^{from} Trig. Mast
 - Mast & Vanes have been painted white & black respectively.
In S. Rected
 - The station/pillar was ~~replaced~~ ^{replaced} on ~~31.7~~ ^{19.86} dimensions now being:
Calculated by Pillar Note should be explicit, e.g. S/Steel Pillar Plate, Steel plug, Brass plug, Bolt, G.I. Pipe
Height of mark... ~~3.04~~ ^{1.515} m. above ~~rock~~ ^{concrete}; Mark is... ~~4.50~~ ^{4.50} m. above G.L.
Height of Top Vanes to Top ~~mark~~ ^{mark} Pillar plate... ~~4.35~~ ^{4.35} m. Diameter of Vanes (vertical)... ~~75.0~~ ^{75.0} m.
Height of Cairn... m. Diameter of Cairn... m. Name Plate found/~~not found~~/placed.
Length of Mast... ~~1.515~~ ^{1.515} m. (approximate if not supplied)
 - A... ~~1.515~~ ^{1.515} m. set in ~~conc~~ ^{conc}/rock has been ~~placed~~ ^{placed}/found, bearing... ~~181~~ ¹⁸¹ ° M from Mast/Plug/Pillar
 - A... ~~1.116~~ ^{1.116} m. set in ~~conc~~ ^{conc}/rock has been ~~placed~~ ^{placed}/found, bearing... ~~160~~ ¹⁶⁰ ° M from Mast/Plug/Pillar
 - A... ~~1.14~~ ^{1.14} m. set in ~~conc~~ ^{conc}/rock has been ~~placed~~ ^{placed}/found, bearing... ~~114~~ ¹¹⁴ ° M from Mast/Plug/Pillar
 - A... m. set in ~~conc~~ ^{conc}/rock has been ~~placed~~ ^{placed}/found, bearing... ° M from Mast/Plug/Pillar
 - Action required:

STANDPOINT:

Mark	Direction	Horiz. Distance	Height Difference	Mark	Direction	Horiz. Distance	Height Difference
			above standpt.				above standpt.
			below				below
			above standpt.				above standpt.
			below				below
Prepared by: **D. KAIN** Checked: **T. KAIN** *Noted on U.T.M. Card 14/01/00*

407


STATION: **WANG PILLAR S.S.** No: **6282**
 MAP SHEETS: **SYDNEY** SCALE: **1:100,000**
 SCALE: **1:250,000** **WALLERAWANGS.**
 INSPECTED BY: **D. J. KAIN** DATE: **31.7.1986**
 AUTHORITY: **C. M. A.** FIELD BOOK: **COCS11**

Station Diagram

North

Not to Scale

8 2735-2 D. West, Government Printer

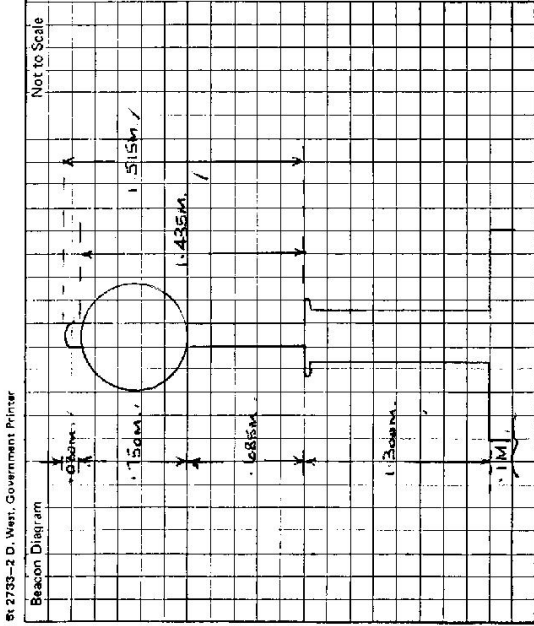

STATION WANG G.S. (P) TS 6282.

FREEHOLD LAND
 Owner's Name: MR. MICHAEL TURNER
 Address: POSTLAND ROAD
 WALLERAWANG.
 Phone: (082) 560727
 55 1887 (House)
 55 1784 (Green Line 57m)
 Access Report of 5/12/19. It was found accessible/unavailable.
 Current Occupant: MR. MICHAEL TURNER
 Address:
 Phone:
 31-7-1986

- Kilms.
- / 0.00 AT WALLERAWANG POST OFFICE, TRAVEL TOWARD PORTLAND.
 - / 0.76 CROSS RAILWAY LINE.
 - / 2.99 PASS CEMETERY ON YOUR R.H.S.
 - / 4.16 THROUGH DOUBLE IRON GATES ON YOUR R.H.S.
 - / 4.33 OVER RAILWAY CROSSING AND THROUGH IRON GATE.
 - / 4.72 THROUGH IRON GATE.
 - / 4.18 CREEK CROSSING OVER SMALL CONCRETE BRIDGE.
 - / 5.00 STRAIGHT AHEAD.
 - / 5.30 THROUGH IRON GATE.
 - / 5.35 PASS OWNERS HOUSE ON YOUR R.H.S. (CALL IN).
 - / 5.62 FOLLOW TRACK UP HILL.
 - / 6.15 PASS QUARRY ON YOUR L.H.S. FOLLOW MAIN TRACKS AROUND TOP OF QUARRY AT BASE OF HILL - VEHICLE STOP WITHOUT WHICH. 5 MINUTE WALK UP TRACK OTHERWISE.

This section to be completed by officer constructing pillar.

Original station mark found/~~not found~~.

Description of mark: S.I. / S.I. IRON PLUG /

Original beacon ~~found~~/not found.

Description of beacon:

Height Top of Vanes to Top Mark.....m.

Height of mark: 0.25 above rock/above 4.00 above G.L. below

Diameter of Vanesm. Height of Cairnm.

Original Beacon has/has not been destroyed by me.

Date	Record of Station