

IS 6285
No.: 4687

CENTRAL MAPPING AUTHORITY
GEODETTIC SURVEY OF N.S.W.

GEODETTIC STATION RECONNAISSANCE and MAINTENANCE REPORT

Description:

1. Cleared by lanes bearing..... Note: Cross out word or words which do not apply
..... from Trig. Mast

2. Mast & Vanes have been painted white & black respectively.

3. The station/pillar was unpiled/not unpiled/constructed on..... 19....., dimensions now being:
G.I. PILE (A)

Description of mark..... should be explicit, e.g., S/Steel Pillar Plate, Steel plug, Brass plug, Bolt, G.I. Pipe

Height of mark.....m. above rock/concrete; Mark is.....m. above G.L.

Height of Top Vanes to Top Mark/Pillar plate.....m. Diameter of Vanes (vertical).....m.

Height of Cairn.....m. Diameter of Cairn.....m. Name Plate found/~~not found~~ placed.

Length of Mast.....m. (approximate if not unplied) IN CONC. BOLLARD.

4. A..... set in conc/rock has been placed/found, bearing.....°M from Mast/Plug/Pillar

5. A..... set in conc/rock has been placed/found, bearing.....°M from Mast/Plug/Pillar

6. A..... set in conc/rock has been placed/found, bearing.....°M from Mast/Plug/Pillar

7. A..... set in conc/rock has been placed/found, bearing.....°M from Mast/Plug/Pillar

8. Action required:..... LANKS PILLAR CAN BE CONSTRUCTED SOUTH OF EXISTING BOLLARD BUT
ACROSS THE DRIVE TO GET AWAY FROM THE TREES.

STANDPOINT:

Mark	Direction	Horiz. Distance	Height Difference	Mark	Direction	Horiz. Distance	Height Difference
			above standpt.				above standpt.
			below				below
			above standpt.				above standpt.
			below				below
Prepared by: *[Signature]*

Checked: *[Signature]*

SI 2733-1

STATION: SCOTT
MAP SHEET SCALE 1:250 000
INSPECTED BY: C. BOSLOPER
AUTHORITY: CMA
DATE: 20/10/78
FIELD BOOK:

GEODETIC SURVEY OF N.S.W.

CENTRAL MAPPING AUTHORITY

GEODETIC STATION RECONNAISSANCE and MAINTENANCE REPORT

Description:

1. Cleared by lanes bearing..... Note: Cross out word or words which do not apply
2. Mast & Vanes have been painted white & black respectively. from Trig. Mast
3. The station/pillar was unspited/not unspited/constructed on dimensions now being: 8-12-19.7.8, dimensions now being: Description of mark: Sts. Pillar. Plate should be explicit, e.g., S/Steel Pillar Plate, Steel plug, Brass plug, Bolt, G.I. Pipe
Height of mark: 3.85 m. above reek/concrete; Mark ism. above G.L.
Height of Top Vanes to Top Mark/Pillar plate 1.447 m. Diameter of Vanes (vertical).....m.
Height of Cairn.....m. Diameter of Cairn.....m. Name Plate found/not found/placed.
Length of Mast 1.527 m. (approximate if not unspited)
4. A G.I. Pipe (Trig. Plug) set in conc/reek has been placed/removed, bearing 294 M from Mast/Plug/Pillar
5. A Copper Nail set in conc/reek has been placed/removed, bearing 243 M from Mast/Plug/Pillar
6. A..... set in conc/reek has been placed/removed, bearing..... M from Mast/Plug/Pillar
7. A..... set in conc/reek has been placed/removed, bearing..... M from Mast/Plug/Pillar
8. Action required:.....

STANDPOINT: CONC OBS PILLAR

STANDPOINT: G.I. PIPE TRIG PLAG


Mark	Direction	Horiz. Distance	Height Difference	Mark	Direction	Horiz. Distance	Height Difference
BELMONT PILLAR	359 59 60 ✓		above standpt	BELMONT PILLAR	359 59 60 ✓		above standpt
COPPER NAIL	128 19 05 / 4-718	1-169	above standpt	COPPER NAIL	17 14 50 / 1-210	1-572	below standpt
SCOTT TRIG PLAG	178 24 40 / 13-634	10-389	below	RICHMOND RES	346 29 50 ✓		above standpt
RICHMOND RES	348 29 20 /		above standpt	SCOTT PILLAR	358 24 45 / 13-635	10-389	below
			below				above standpt
			above standpt				below
			below				above standpt
			above standpt				below

Prepared by:

Checked: 19-12-78

Noted on U.T.M. Card

SF 2733-1

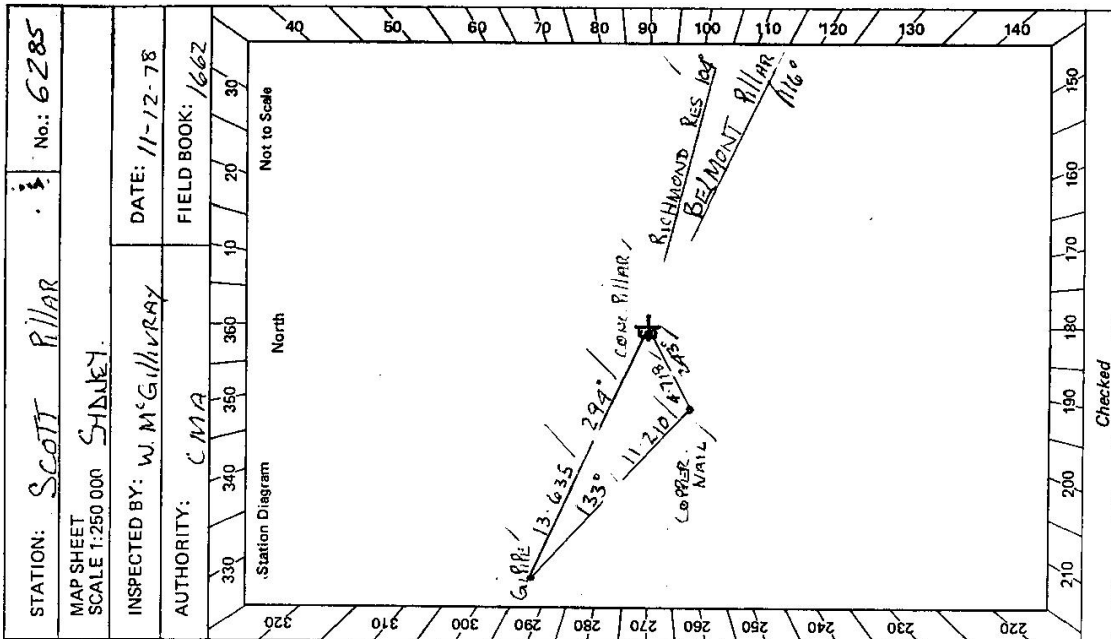

Checked

STATION: SCOTT PILLAR

MAP SHEET SCALE 1:250 000 SHANEY

INSPECTED BY: W.M. GILLIVRAY


DATE: 11-12-78

AUTHORITY: CMA

FIELD BOOK: 1662

No.: 6285

Sr 2733-2 D. West, Government Printer

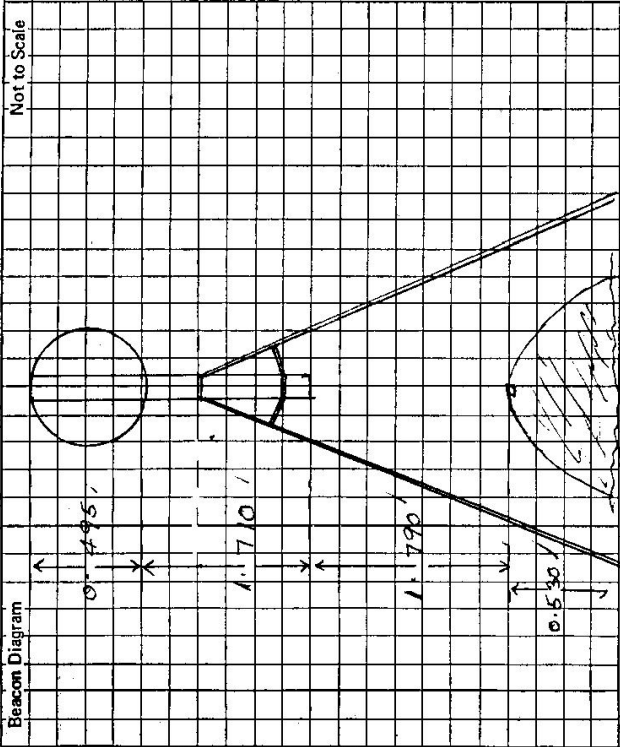

This section to be completed by officer constructing pillar.

Original station mark found/~~not found~~.

Description of mark: S.A. Pillar in grassy cone

Original beacon found/~~not found~~.

Description of beacon: Older Height Mast x Vanes

Height Top of Vanes to Top Mark: 3.995 m.

Height of mark: 0.530 above rock/ceac / 0.530 below G.L.

Diameter of Vanes: 0.495 m. Height of Cairn m.

Original Beacon has/~~not been~~ destroyed by me.

11

STATION	Scott Pillar JS 6285				
Owner's Name: <u>Mr. M. Hill</u>	Current Occupant: <u> </u>	Address: <u>CHERRY PARK</u>	Address: <u> </u>	Address: <u> </u>	Address: <u> </u>
Address: <u>KURRAJONG HEIGHTS</u>	Phone: <u> </u>	Phone: <u>677174</u>	Phone: <u> </u>	Phone: <u> </u>	Phone: <u> </u>
Access Report of: <u> </u> / <u>19%</u> was found suitable/ unsuitable .	ACCESS				
Date	Record of Station				

CS

<p>St 2733-2 D, West, Government Printer</p>	<p>STATION</p> <p style="font-size: 24pt; font-weight: bold;">SCOTT TS 6285</p>	<p>Owner's Name: <u>MALCOLM HILL</u> Address: <u>CHERRY PARK</u> <u>KURRAJOONS HEIGHTS</u> Phone: <u>67712</u></p> <p>Current Occupant: Address: Phone: <u>20/10/1978</u></p>	<p>ACCESS <u>20/10/1978</u></p> <p>Access Report of <u>7/16</u> found suitable/unsuitable.</p>	<p>SIGN MARK TRIG. BEANS: TRIG. STATION SCOTT. HEIGHT ABOVE SEA LEVEL 1966 ft. LAT. 33° 02' 57" S LONGS 150° 37' 20" EAST Established by dept of lands as part of the basis for SURVEY AND MAPPING OPERATIONS IN NSW. (please note errors in lat, long and height)</p>	
<p>Beacon Diagram</p> <p>Not to Scale</p>					
<p>This section to be completed by officer constructing pillar.</p> <p>Original station mark found/not found.</p> <p>Description of mark:</p> <p>Original beacon found/not found.</p> <p>Description of beacon:</p> <p>Height Top of Vanas to Top Mark.....m. above below Height of mark.....m. rock/cont.....m. below G.L. Diameter of Vanes.....m. Height of Cairn.....m.</p> <p>Original Beacon has/has not been destroyed by me.</p>				<p>Date</p> <p>Record of Station</p>	

CENTRAL MAPPING AUTHORITY

GEODETIC SURVEY OF N.S.W.

GEODETIC STATION RECONNAISSANCE and MAINTENANCE REPORT

Description:

1. Cleared by vanes bearing..... Note: Cross out word or words which do not apply

2. Mast & Vanes have been painted white & black respectively. from Trig. Mast

3. The station/pillar was unpainted/not-unpainted/constructed on..... 8-12-1978, dimensions now being:

Description of mark: Steel Pillar Plate should be explicit, e.g., S/Steel Pillar Plate, Steel plug, Brass plug, Bolt, G.I. Pipe

Height of mark: 3.65 m. ^{above} ~~below~~ feet/concrete; Mark is..... m. ^{above} ~~below~~ G.L.

Height of Top Vanes to Top Mark/Pillar plate 4.47 m. Diameter of Vanes (vertical)..... m.

Height of Cairn..... m. Diameter of Cairn..... m. Name Plate found/not found/placed.

Length of Mast 5.27 m. (approximate-if-not-unpiled)

4. G.I. Pipe (Trig Plug) set in conc/rock has been placed/removed, bearing 294° M from Mast/Plug/Pillar

5. Copper Nail set in conc/rock has been placed/removed, bearing 273° M from Mast/Plug/Pillar

6. A..... set in conc/rock has been placed/removed, bearing.....° M from Mast/Plug/Pillar

7. A..... set in conc/rock has been placed/removed, bearing.....° M from Mast/Plug/Pillar

8. Action required:.....


Mark	Direction	Horiz. Distance	Height Difference	Mark	Direction	Horiz. Distance	Height Difference
BEI MAST PILLAR	359° 59' 60"		above standpt.	BEI MAST PILLAR	359° 59' 60"		above standpt.
COOPER NAIL	128° 19' 05"	4.718	below standpt.	COOPER NAIL	17° 14' 50"	11.210	below standpt.
SCOTT TRIG PLUG	178° 24' 40"	13.634	above standpt.	RICHMOND RES	348° 29' 50"		above standpt.
RICHMOND RES	348° 29' 20"		above standpt.	SCOTT PILLAR	358° 24' 45"	13.635	below standpt.
			below standpt.				above standpt.
			above standpt.				below standpt.
			below standpt.				above standpt.
			above standpt.				below standpt.

STANDPOINT: CONC OBS PILLAR STANDPOINT: G.I. PIPE TRIG PLUG

Prepared by:

Checked: W.H. 19.12.78 Noted on U.T.M. Card

SI 2733-1

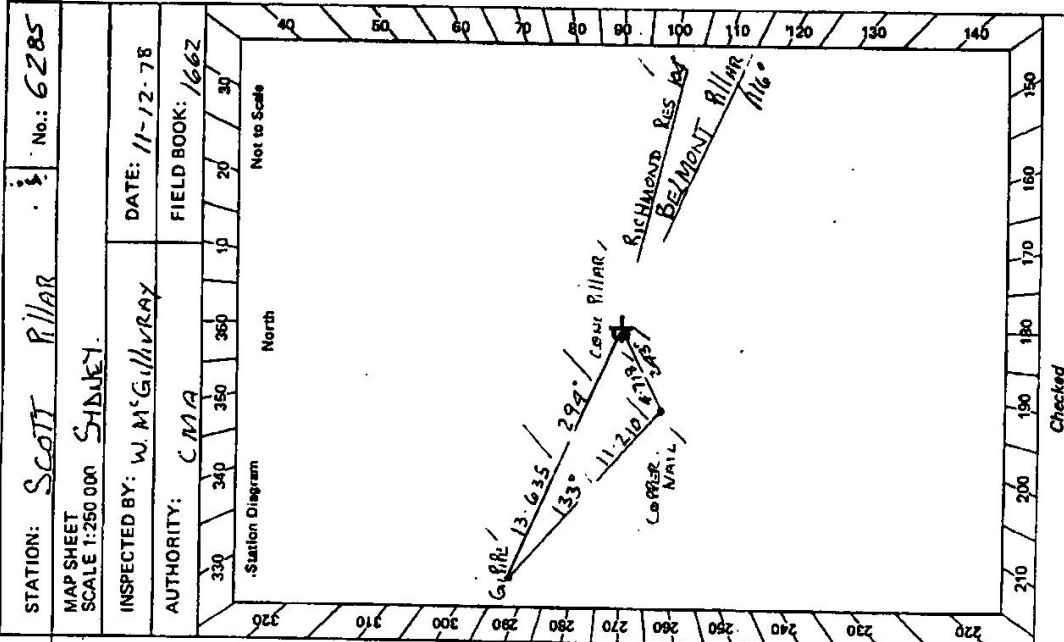


STATION: SCOTT PILLAR No.: 6285
 MAP SHEET SCALE 1:250,000 SHAJEY
 INSPECTED BY: W.M. GILHURAY DATE: 11-12-78
 AUTHORITY: CMA FIELD BOOK: 1662

Checked

SI 2733-2 D, West, Government Printer

Beacon Diagram

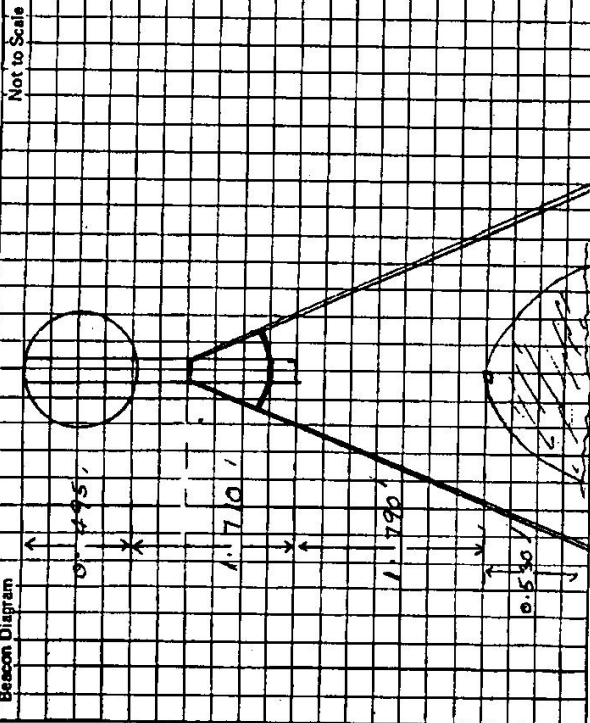

This section to be completed by officer constructing pillar.

Original station mark found/~~not found~~.

Description of mark: *CAIRN IN GRASS*

Original beacon found/~~not found~~.

Description of beacon: *MARKER*

Height Top of Vanes to Top Mark: *3.995* m.

Height of mark: *0.530* m. *above* rock/~~below~~ *0.530* m. *below* G.L.

Diameter of Vanes: *0.495* m. Height of Cairn *—* m.

Original Beacon has/~~has not been~~ destroyed by me.

STATION

SCOTT PILLAR & TS 6285

Owner's Name: *MR M. HILL*
 Address: *CHESSY PARK*
KARRAJONG HEIGHTS
 Phone: *677174*

Current Occupant:
 Address:
 Phone:

ACCESS

Access Report of: *1976* was found suitable/~~unsuitable~~.

Date


Record of Station

11

IS 6285

No.: 4997

STATION: **SCOTT**
 MAP SHEET SCALE 1:250 000 **SYDNEY**
 INSPECTED BY: **C. BOSLOPER** DATE: **20/10/78**
 AUTHORITY: **CMA** FIELD BOOK:

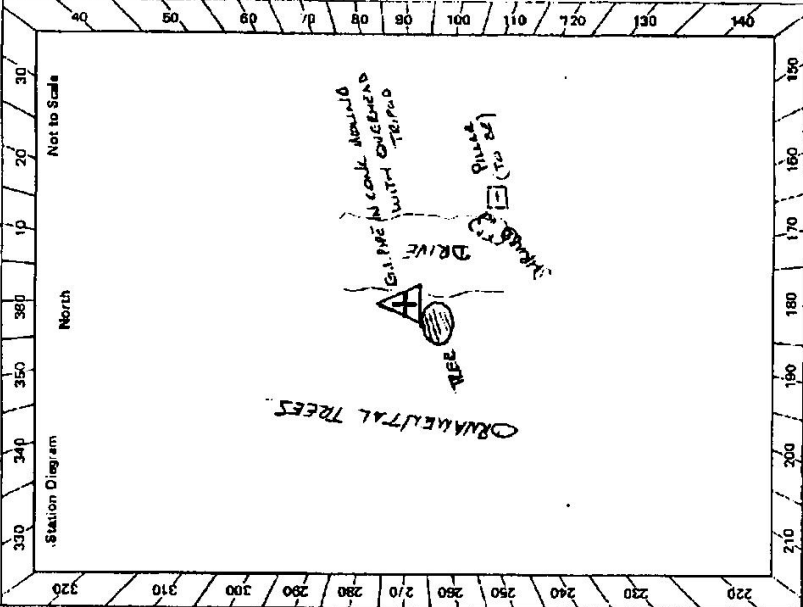

CENTRAL MAPPING AUTHORITY
 GEODETTIC SURVEY OF N.S.W.
 GEODETTIC STATION RECONNAISSANCE and MAINTENANCE REPORT

Description: *Note: Cross out word or words which do not apply*

1. Cleared by lanes bearing..... from Trig, Mast
2. Mast & Vanes have been painted white & black respectively.
3. The station/pillar was unpiled/not unpiled/constructed on..... 19....., dimensions now being: G.I. Pipe & Mast
 Description of mark..... should be explicit, e.g. S/Steel Pillar Plate, Steel plug, Brass plug, Bolt, G.I. Pipe
 Height of mark..... m. ^{above} _{below} rock/concrete; Mark is..... m. ^{above} _{below} G.L.
 Height of Top Vanes to Top Mark/Pillar plate..... m. Diameter of Vanes (vertical)..... m.
 Height of Cairn..... m. Diameter of Cairn..... m. Name Plate found/~~not found~~ placed..... m. ^{above} _{below} G.L.
 Length of Mast..... m. (approximate if not unpiled)
4. A..... set in conc/rock has been placed/found, bearing..... ° M from Mast/Plug/Pillar
5. A..... set in conc/rock has been placed/found, bearing..... ° M from Mast/Plug/Pillar
6. A..... set in conc/rock has been placed/found, bearing..... ° M from Mast/Plug/Pillar
7. A..... set in conc/rock has been placed/found, bearing..... ° M from Mast/Plug/Pillar

8. Action required: **MARKS PULLED, CAN BE RE-CONSTRUCTED SOUTH OF EXISTING BEACON BUT ACCESS THE DRIVE, TO GET STANDPOINT:**

Mark	Direction	Horiz. Distance	Height Difference	Mark	Direction	Horiz. Distance	Height Difference
			above standpt				above standpt
			below standpt				below standpt
			above standpt				above standpt
			below standpt				below standpt
			above standpt				above standpt
			below standpt				below standpt
			above standpt				above standpt
			below standpt				below standpt

Prepared by: *[Signature]* Checked: *[Signature]* Noted on U.T.M. Card

<p>6. 2733-2 D. West, Government Printer</p>	<p>STATION</p>	<p>SCOTT TS 6285</p>	<p>Owner's Name: MALCOLM HILL Address: "C HERRY PARK" KURRAJOONG HEIGHTS Phone: 677114</p> <p>Current Occupant: Address: Phone: 20/10/1978</p> <p>ACCESS 20/10/1978</p> <p>Access Report of 1978 found suitable/unsuitable.</p> <p>TERM. STATION SCOTT. HEIGHT ABOVE SEALEVEL 1766 ft Lat. 31° 02' 57M LONG 150° 37' 20' EAST</p> <p>Established by Dept of Lands as part of the basis for SURVEY AND MAPPING OPERATIONS IN NSW.</p> <p>(please note errors in lat, long and height.)</p>
			<p>Record of Station</p>
<p>Owner's Name: MALCOLM HILL Address: "C HERRY PARK" KURRAJOONG HEIGHTS Phone: 677114</p> <p>Access Report of 1978 found suitable/unsuitable.</p>			<p>Date</p>
<p>Not to Scale</p>			<p>Record of Station</p>
<p>This section to be completed by officer constructing pillar.</p>			<p>Record of Station</p>
<p>Original station mark found/not found.</p>			<p>Record of Station</p>
<p>Description of mark:</p>			<p>Record of Station</p>
<p>Original beacon found/not found.</p>			<p>Record of Station</p>
<p>Description of beacon:</p>			<p>Record of Station</p>
<p>Height Top of Vanes to Top Mark.....m.</p>			<p>Record of Station</p>
<p>Height of mark.....m. above rock/cont.....m. below G.L.</p>			<p>Record of Station</p>
<p>Diameter of Vanes.....m. Height of Cairn.....m.</p>			<p>Record of Station</p>
<p>Original Beacon has/has not been destroyed by me.</p>			<p>Record of Station</p>