


TS 6290
No. 2058

STATION: FISH GS.
MAP SHEET: SCALE 1:250 000 BATHURST
INSPECTED BY: N.KRANE
AUTHORITY: C.M.A.
DATE: 28-11-78
FIELD BOOK: -

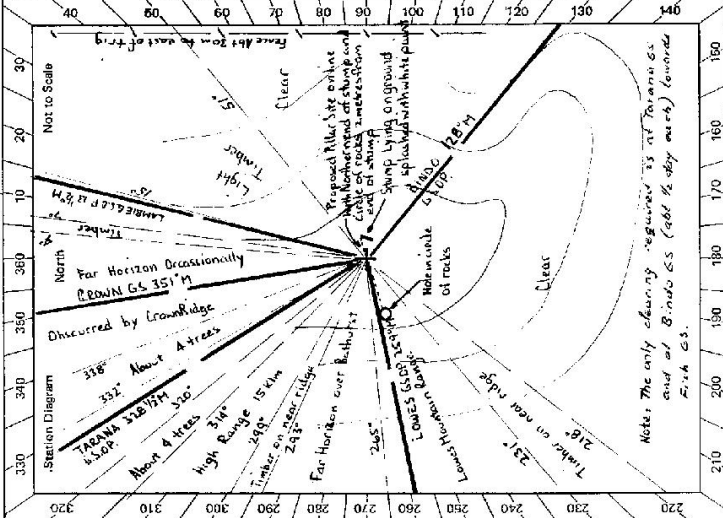


Description:

- 1. Cleared by lanes bearing... 2. Mast & Vanes have been painted white & black respectively
- 3. The station/pillar was unplaced/not supplied/constructed on
- 4. A... set in conc./rock has been placed/found, bearing... M from Mast/Plug/Pillar
- 5. A... set in conc./rock has been placed/found, bearing... M from Mast/Plug/Pillar
- 6. A... set in conc./rock has been placed/found, bearing... M from Mast/Plug/Pillar
- 7. A... set in conc./rock has been placed/found, bearing... M from Mast/Plug/Pillar
- 8. Action required: Pillar to be placed with 2 reference marks. See diagram over

STANDPOINT:

Mark	Direction	Horiz. Distance	Height Difference	Mark	Direction	Horiz. Distance	Height Difference
			above standpt.				above standpt.
			below				below
			above standpt.				above standpt.
			below				below
Prepared by: Munnels & Krane 28-11-78
Checked: W. Fisher 28/11/78
Printed on U.T.M. Card

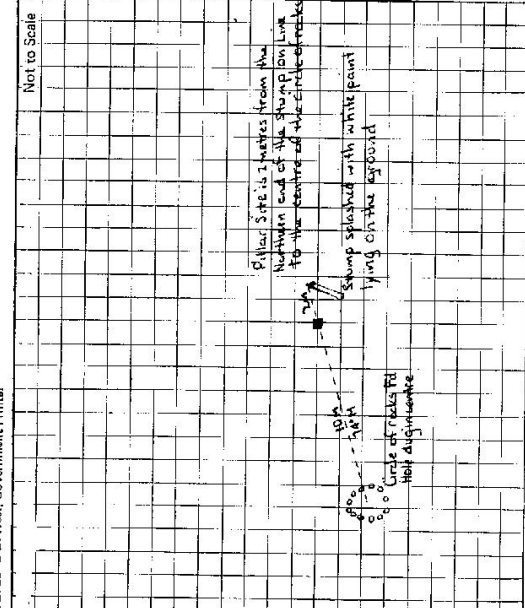STATION FISH G S TS 6290	Owner's Name: Address: Phone: Current Occupant: Address: Phone: ACCESS Access Report of <u>21/11/1988</u> was found suitable/unsuitable. 0-0 Intersection near Railway Hotel Tarana. Take the bitumen road to the south towards Lethgow 0-15 Turn right onto the gravel road which goes to Oberon 8-2 Turn left at cross roads and take Mt Olive Road 11-1 T-intersection take road to the left 11-7 Iron gate-follow track through gate 12-1 Leave road and head up grassy slope for about 150 metres to the trig on top of the hill See Tarana 1:25000 topo map for access
Not to Scale 	This section to be completed by officer constructing pillar. Original station mark found/not found. Description of mark: Original beacon found/not found. Description of beacon: Height Top of Vanes to Top Mark m. Height of mark m. above / below G.L. Diameter of Vanes m. Height of Cairn m. Original Beacon has/has not been destroyed by me.
	Date Record of Station

CENTRAL MAPPING AUTHORITY

GEODETIC STATION RECONNAISSANCE and MAINTENANCE REPORT

STATION: FISH (P) TS No.: 6290

MAP SHEET SCALE 1:250 000 BATHURST

INSPECTED BY: D. KINLYSIDE DATE: 17-1-79


AUTHORITY: LMA 472/J FIELD BOOK: C.004

Description: Note: Cross out word or words which do not apply

1. Cleared by lances bearing..... 0° → 340°
2. Mast & Vanes have been painted white & black respectively.
3. The station/pillar was ~~unplaced/not supplied~~/constructed on..... 15.1..... 1972....., dimensions now being: Description of mark. S/Steel..... P.C..... should be explicit. e.g., S/Steel Pillar Plate, Steel plug, Brass plug, Bolt, G.I. Pipe Height of mark..... 1.345 m..... above ~~below~~ ~~feet~~/concrete/plate/beam Mark is..... 1.52..... m..... above ~~below~~ G.L.
- Height of Top Vanes to Top Mark/Pillar plate..... 4.49..... m..... Diameter of Vanes (vertical)..... 0.750..... m.
- Height of Cairn..... m..... Diameter of Cairn..... m..... Name Plate ~~feet~~/not ~~feet~~/placed.
- Length of Mast..... 1.530..... m..... (approximate if not unplaced)
4. A..... Copper Nail..... set in conc/feet has been placed/~~feet~~, bearing..... 250..... °M from Mast/Plug/Pillar
5. A..... G.I. Pipe..... set in conc/rock has been placed/~~feet~~, bearing..... 328..... °M from Mast/Plug/Pillar
6. A..... set in conc/rock has been placed/~~found~~, bearing..... °M from Mast/Plug/Pillar
7. A..... set in conc/rock has been placed/~~found~~, bearing..... °M from Mast/Plug/Pillar
8. Action required: Name plate to be placed

STANDPOINT: S/Steel Pillar Plate				STANDPOINT: Copper Nail in conc.			
Mark	Direction	Horiz. Distance	Height Difference	Mark	Direction	Horiz. Distance	Height Difference
LOWES GSOP	359 55 60		above standpt.	LOWES GSOP	359 55 60		above standpt.
G.I. Pipe in conc.	67 14 30	3.069	above standpt.	LAMBIE GSOP	114 20 11		above standpt.
LAMBIE GSOP	114 05 44		below standpt.	G.I. Pipe in conc.	125 40 20	4.211	above standpt.
Copper Nail in conc.	350 47 00	3.690	below standpt.	S/Steel pillar plate	170 46 30	3.690	above standpt.
			above standpt.				below standpt.
			below standpt.				below standpt.
			below standpt.				below standpt.
			below standpt.				below standpt.

Prepared by: D. Kinlyside Checked: W. Pease 19/1/79 Noted on U.T.M. Card

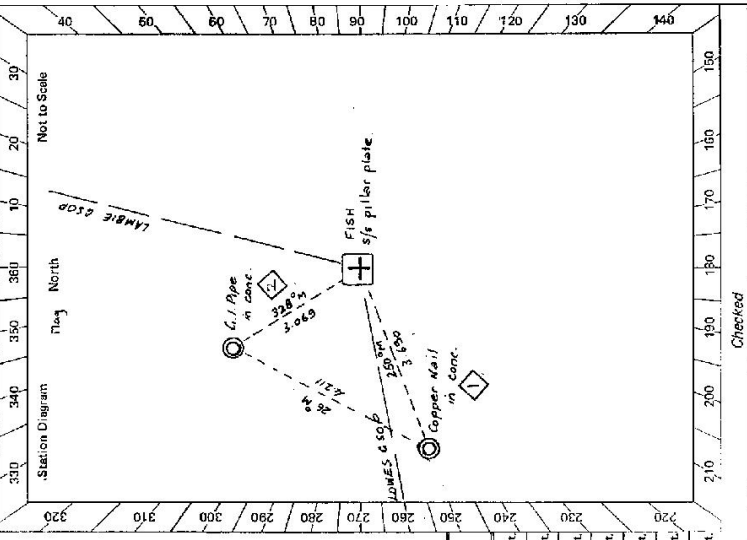

STATION FISH (P) TS 6290


Owner's Name:
 Address:
 Phone:
 Current Occupant:
 Address:
 Phone:

ACCESS

Access Report of 28/11/1978 was found suitable/acquirable.

- 0-0 T-intersection near Railway Hotel, Tarana. Take bitumen road to south towards Lithgow
- 0-15 Turn RIGHT onto gravel road towards Oberon
- 8-2 Turn LEFT at cross-roads Mt Olive Road
- 11-1 T-intersection turn LEFT
- 11-7 Through iron gate
- 12-1 Leave road and head up grassy slope to Trig

Sr: 2752 - 2 D. West, Government Printer

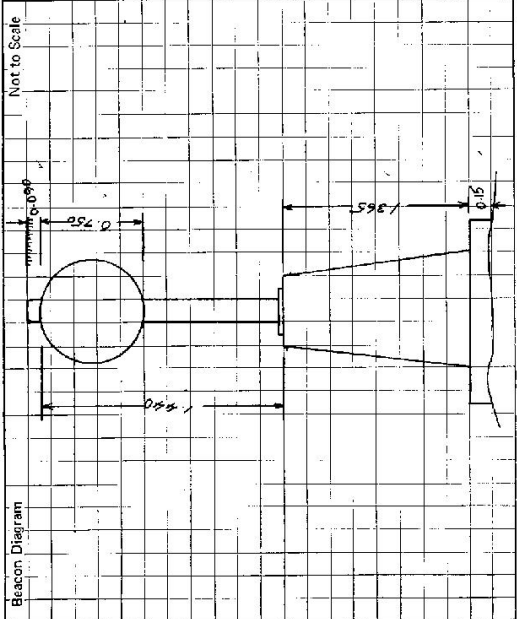

This section to be completed by officer constructing pillar:

Original station mark ^{not} found/~~not found~~.

Description of mark:

Original beacon found/not found.

Description of beacon:

Height Top of Vanes to Top Mark.....m.

Height of mark.....m. above G.L.
 below

Diameter of Vanes.....m. Height of Cap.....m.

Original Beacon has/had not been destroyed by me.

Date	Factor of Station

CENTRAL MAPPING AUTHORITY


GEODETIC SURVEY OF N.S.W. GEODETIC STATION RECONNAISSANCE and MAINTENANCE REPORT

STATION: EISH (P) TS No.: 6290

MAP SHEET SCALE 1:250 000 BATHURST

INSPECTED BY: DATE: MAY 1979

AUTHORITY: FIELD BOOK:

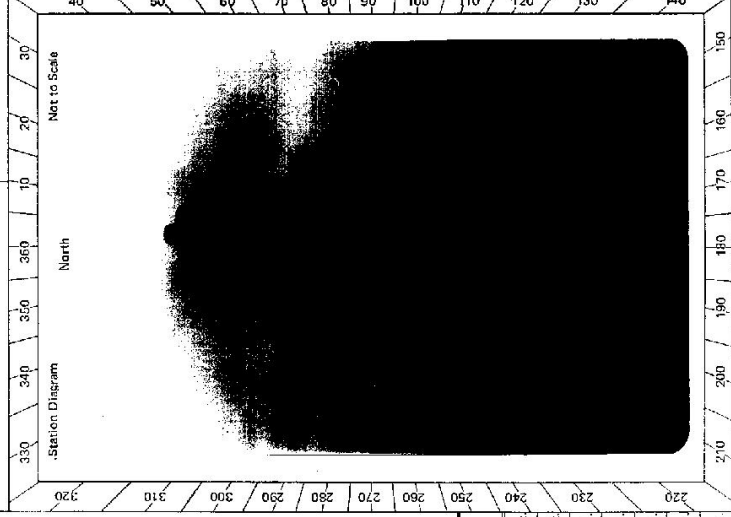

- Description:
- Note: Cross out word or words which do not apply
- Cleared by lanes bearing..... from Trig. Mast
 - Mast & Vanes have been painted white & black respectively.
 - The station/pillar was unplied/not unplied/constructed on.....19....., dimensions now being: Description of mark.....should be explicit, e.g., S/Steel Pillar Plate, Steel plug, Brass plug, Bolt, G.I. Pipe
 - Height of mark.....m. ^{above} _{below} rock/concrete; Mark is.....m. ^{above} _{below} G.I.
 - Height of Top Vanes to Top Mark/Pillar platem. Diameter of Vanes (vertical).....m.
 - Height of Cairn.....m. Diameter of Cairn.....m. Name Plate found/not found/placed.
 - Length of Mastm. (approximate if not unplied)
 - A.....set in conc/rock has been placed/found, bearing.....° M from Mast/Plug/Pillar
 - A.....set in conc/rock has been placed/found, bearing.....° M from Mast/Plug/Pillar
 - A.....set in conc/rock has been placed/found, bearing.....° M from Mast/Plug/Pillar
 - A.....set in conc/rock has been placed/found, bearing.....° M from Mast/Plug/Pillar
 - Action required:.....

STANDPOINT:

Mark	Direction	Horiz. Distance	Height Difference	Mark	Direction	Horiz. Distance	Height Difference
			above standpt				above standpt
			below				below
			above standpt				above standpt
			below				below
Prepared by: Checked: Noted on U.T.M. Card