

CENTRAL MAPPING AUTHORITY *Bach* **1566**
 GEODETIC SURVEY OF N.S.W.
 GEODETIC STATION RECONNAISSANCE and MAINTENANCE REPORT

STATION: **TULLOCH (G.P.)** No.: **6291**
 MAP SHEET SCALE 1:250 000 **TULLOCH**
 INSPECTED BY: **Peris** DATE: **15-2-79**
 AUTHORITY: **DMMA** FIELD BOOK: **1167**

Station Diagram
 North
 Not to Scale

- Description: *Note: Cross out word or words which do not apply*
- Cleared by lanes bearing **300° 00'** *to S.E. 100m* **EXTENDED** *to 100m* from Trig. Mast
 - Mast & Vanes have been painted white & black respectively.
 - The **pillar** was **re-constructed on 19/7/79**, dimensions now being:
 Description of mark: **S.R. PILLAR** should be explicit, e.g., S/Steel Pillar Plate, Steel plug, Brass plug, Bolt, G.I. Pipe
 Height of mark: **1.350** m. ^{above} **1.350** m. ^{above} G.L.
 Height of Top Vanes to Top **Pillar plate 1.140** m. Diameter of Vanes (vertical): **0.75** m.
 Height of Cairn: **0.0** m. Diameter of Cairn: **0.0** m. Name Plate: **not placed**.
 - Length of Mast: **0.0** m. (approximate if not unplied)
 - A. **Corrected** *set in conc/rock* has been placed/ **found**, bearing **5** ° M from **WIRE MOUNTED MOUNTAIN**/Pillar
 - A. **Corrected** *set in conc/rock* has been placed/ **found**, bearing **65** ° M from **WIRE MOUNTED MOUNTAIN**/Pillar
 - A. **Corrected** *set in conc/rock* has been placed/ **found**, bearing **0** ° M from Mast/Plug/Pillar
 - A. **Corrected** *set in conc/rock* has been placed/ **found**, bearing **0** ° M from Mast/Plug/Pillar

STANDPOINT: **CONCRETE OBS. PILLAR** STANDPOINT: **AIR PILE IN CONE**

Mark	Direction	Horiz. Distance	Height Difference	Mark	Direction	Horiz. Distance	Height Difference
STAINLINE (P)	0 80 00		above standpt.	STAINLINE (P)	0 00 00		above standpt.
Corrected Nail in Cone	06 00 50	3.00	below standpt.	Corrected Nail in Cone	06 00 50	3.00	below standpt.
Corrected Nail in Cone	18 17 30	2.55	below standpt.	Corrected Nail in Cone	18 17 30	2.55	below standpt.
Corrected Nail in Cone	18 5 35	1.35	below standpt.	Corrected Nail in Cone	18 5 35	1.35	below standpt.
			above standpt.				above standpt.
			below standpt.				below standpt.
			above standpt.				above standpt.
			below standpt.				below standpt.

Prepared by: **Peris** Checked: **Peris** *Note: Noted on U.T.M. Card*



STATION TULLOCHHEAD (S.O.) TS 6291


Owner's Name: Mr J. HEAL
 Address:
 Phone: 223 311 511

Current Occupant:
 Address:
 Phone:

ACCESS

Access Report of 15/3/1979 was found suitable/unsuitable.
kill
Central Hotel Hotel JUBILEE HEAD WEST ALONG MAIN STREET TOWARDS WADSWORTH
ROAD
ROADS AHEAD UNLIT/NO ROAD
TRUCKS/VEHICLES ENTER FROM ROAD
ROAD - TAKE LEFT FOR
ROAD
AMONG HOUSE NO. 11, 12, 13, 14 FROM HERE GO
BETWEEN HOUSE NO. 11 & 12
DOUBLE LINE MARKS GO THROUGH THEN MAKE LEFT AND FOLLOW TRACK
FORCE DOWN AND ROAD ALONG ON LEFT, STRAIGHT AHEAD.
TULLOCHHEAD (S.O.)

NOTE
MAKE SURE TO MAKE CONTACT WITH OWNERS
BEFORE GOING TO TRIP!

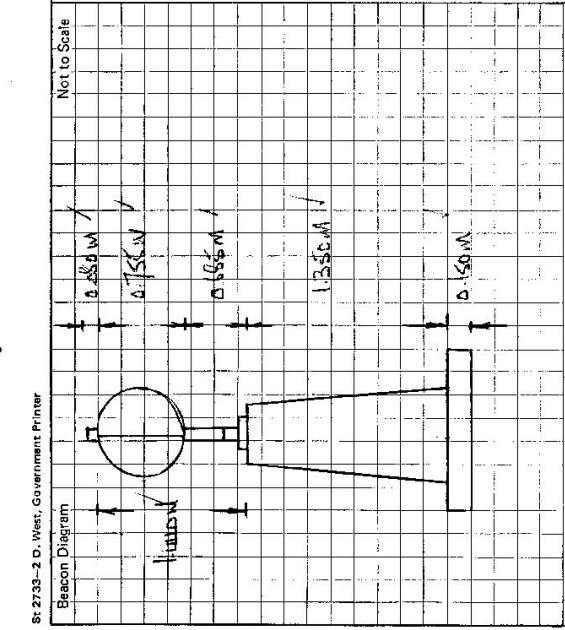

This section to be completed by officer constructing pillar.

Original station mark found/not found.

Description of mark:

Original beacon found/not found.

Description of beacon:

Height Top of Vane to Top Mark 1.15 m. above G.L.

Height of mark 1.15 m. above rock/conc. below

Diameter of Vane 0.288 m. Height of Cairnm.

Original Beacon has/has not been destroyed by me.

Date:

Record of Station:

STATION TULLORCHARD (P) TS 6291	Owner's Name: MR M WILLIAMS. 2/93 Address: MR M S. WILLIAMS Phone: 067 22 3454 Current Occupant: Address: Phone: ACCESS Access Report of 21/7/1982 was found suitable/unsuitable.
Beacon Diagram Not to Scale	<p>This section to be completed by officer constructing pillar.</p> <p>Original station mark found/not found.</p> <p>Description of mark:</p> <p>Original Beacon found/not found.</p> <p>Description of beacon:</p> <p>Height Top of Vanes to Top Mark:m.</p> <p>Height of mark:m. above G.L. below G.L.</p> <p>Diameter of Vanes:m. Height of Cairn:m.</p> <p>Original Beacon has/has not been destroyed by me.</p>
	Date Record of Station

