

CENTRAL MAPPING AUTHORITY

GEODETTIC SURVEY OF N.S.W.

GEODETTIC STATION RECONNAISSANCE and MAINTENANCE REPORT

STATION: HICKNEY (Pillar) No.: 6293  
 MAP SHEET SCALE 1:250 000  
 INSPECTED BY: D. KANG DATE: 23 February 1979  
 AUTHORITY: C.M.A. FIELD BOOK: 01659

Description:  
 1. Cleared by lanes bearing 10 - 26.3 M. Note: Cross out word or words which do not apply  
 2. Mast & Vanes have been painted white & black respectively.  
 3. The station/pillar was reconstructed/constructed on concrete.  
 Description of mark: S. Pillar should be explicit, e.g., S/Steel Pillar Plate, Steel plug, Brass plug, Bolt, G.I. Pipe  
 Height of mark: 1.315 m. above concrete/concrete; Mark is 1.435 m. above G.L.  
 Height of Top Vanes to Top concrete/Pillar plate 1.440 m. Diameter of Vanes (vertical) 150 m.  
 Height of Cairn 0 m. Diameter of Cairn 0 m. Name Plate None (placed) 1.3 M  
 Length of Mast 1.530 m. (approximate if not unipled)  
 4. Brooklands G.I. pipe set in concrete/rock has been placed/found, bearing 52° M from North Bearing/Pillar  
 5. S.S.M. set in concrete/rock has been placed/found, bearing 145° M from North Bearing/Pillar  
 6. G.I. pipe set in concrete/rock has been placed/found, bearing 82° M from North Bearing/Pillar  
 7. A set in concrete/rock has been placed/found, bearing 0° M from Mast/Plug/Pillar  
 8. Action required: Name plate to be applied. Name plate placed 17 March 79

STANDPOINT: Concrete Pillar      STANDPOINT: 1816 Pin

Mark	Direction	Horiz. Distance	Height Difference	Mark	Direction	Horiz. Distance	Height Difference
<u>Brooklands G.S.</u>	<u>0 00 00</u>		<u>above</u> standpt.	<u>Brooklands G.S.</u>	<u>0 00 00</u>		<u>above</u> standpt.
<u>1816 Pin</u>	<u>37 54 49</u>	<u>1.704</u>	<u>below</u> standpt.	<u>G.I. pipe</u>	<u>94 13 17</u>	<u>1.845</u>	<u>above</u> standpt.
<u>G.I. pipe</u>	<u>67 17 42</u>	<u>3.129</u>	<u>above</u> standpt.	<u>Brooklands G.S.</u>	<u>177 42 11</u>		<u>above</u> standpt.
<u>S.S.M.</u>	<u>130 37 39</u>	<u>1.345</u>	<u>below</u> standpt.	<u>S.S.M.</u>	<u>180 40 49</u>	<u>2.272</u>	<u>above</u> standpt.
<u>Brooklands G.S.</u>	<u>177 41 43</u>		<u>above</u> standpt.	<u>Conc. Pillar</u>	<u>211 53 37</u>	<u>1.705</u>	<u>above</u> standpt.
			<u>below</u> standpt.				<u>below</u> standpt.
			<u>below</u> standpt.				<u>below</u> standpt.
			<u>below</u> standpt.				<u>below</u> standpt.

Prepared by: D. Kang      Checked: D. Kang  
 Note: \* Noted on U.T.M. Card

STATION HICKES (Pillar) / TS 6293

Owner's Name: S. MATEO AN BOUNDARY  
 Address: OF COLUMBATTI STATE FOREST  
 Adjoining Block Owned by: B.G.D. COMINE  
 Phone: 67 1227

Current Occupant: .....  
 Address: 1080KA  
 Phone: .....  
 ACCESS 23-2-1979  
 Access Report of 25.11.1966 was found suitable/unsuitable.


At Post Office West Kempsey At 0.0 Kilometres Travel West  
 Along Willowweird Armidale Road toward Armidale.

FEATURE:

Turn right onto Gravel Road at Signpost, Mungay Creek 9.  
 Pass Abandoned mine ENTRANCE on your R.H.S.  
 Take Left Fork in Tracks.  
 Travel straight ahead.  
 Pass over gully near old house.  
 Pass over gully at top of hill.  
 Over steel grid.  
 Turn left onto "Dennis Road" signposted.  
 Turn left onto KENNEDY'S ROAD signposted, follow Road through THICK LANTANA.  
 Pass faint tracks on your L.H.S.  
 Turn sharp right up through slip rails, follow track with fence on your right northward up ridge to concrete Obs.  
 pillar at 37.30 Kilometres.

Record of Station

Date

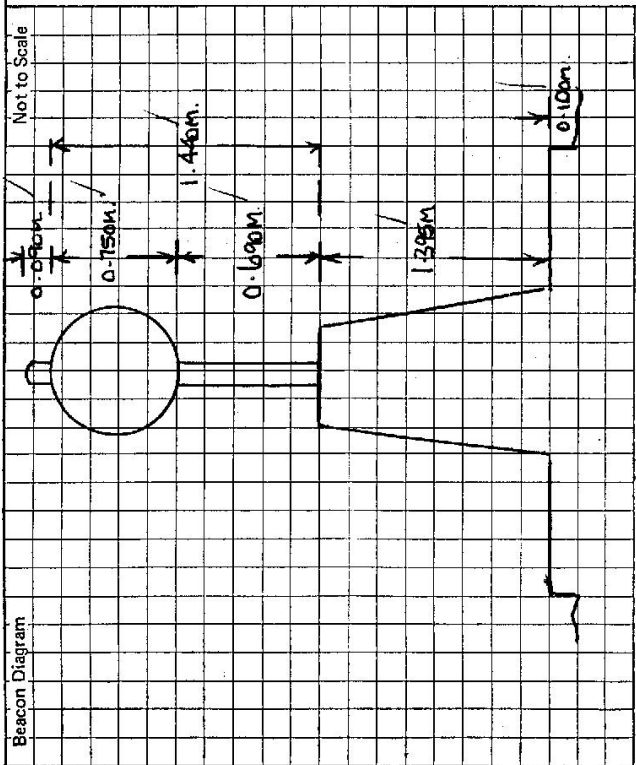

This section to be completed by officer constructing pillar.

Original station mark found/~~not found~~.

Description of mark: BRONZE large pin

Original beacon found/~~not found~~.

Description of beacon: Small Capon Wood Quadruped Brass Vane

Height Top of Vane to Top Mark: 3.652 m.

Height of mark: 0.18 m. above rock/below G.L.

Diameter of Vane: 6.10 m. Height of Cairn 0.100 m.

Original Beacon has/~~not~~ been destroyed by me.