

CENTRAL MAPPING AUTHORITY
 Department of Lands
 Trigonometric Survey of N.S.W.
RECONNAISSANCE and MAINTENANCE REPORT

This Trig. Station has been:-

1. ~~Completely cleared to permit 360° vision to surrounding Trigs.~~
2. Cleared by lanes bearing from Trig. Mast
3. ~~Trig. Mast & Vanes have been painted white & black respectively.~~
4. The Trig. was unpiled/not unpiled, dimensions now being: _____

Note: Cross out word or words which do not apply

Description of mark..... should be explicit, e.g. Steel plug, Brass plug, Bolt, G.L. Pipe
 Height of mark..... m ^{above} _{below} rock/concrete m G.L.
 Height of Top Vanes to Top Mark..... m. Diameter of Vanes (vertical) 0.76 m.
 Height of Cairn..... m. ^{1.20 top} _{1.90 base} Diameter of Cairn..... m.
 Length of Mast 3.53 m. (approximate if not unpiled)


5. A..... set in conc./rock ~~has~~ been placed..... m. bearing..... °M from Trig. Mast
6. A..... set in conc./soil has been placed..... m. bearing..... °M from Trig. Mast
7. A..... set in conc./soil has been placed..... m. bearing..... °M from Trig. Mast
8. A..... set in conc./rock has been placed..... m. bearing..... °M from Trig. Mast
9. Connection..... to..... m. bearing..... °M
10. Connection..... to..... m. bearing..... °M
11. Connection..... to..... m. bearing..... °M
12. Connection..... to..... m. bearing..... °M
13. Diff. Ht. is..... m. ^{known} _{above} _{below}
14. Diff. Ht. is..... m. ^{above} _{below}
15. Diff. Ht. is..... m. ^{above} _{below}
16. Diff. Ht. is..... m. ^{above} _{below}

Prepared by: M.L. Morrison Checked: _____

Noted on U.T.M. Card

STATION PARADISE TS 6295
 Co: VERNON | PI: BENDITTI
 Map Sheet: COWARRAL | No: 9335
 Inspected by: M.L. Morrison | Date: 15th AUGUST 1977
 Authority: _____ | Field Book: 1581

Beacon Diagram Not to Scale

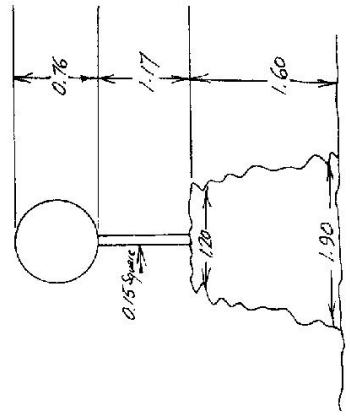

Date _____ Record of Station _____

*TRIG PD IN GOOD CONDITION. NEEDS PAINTING.
 5500 IN CASE FD. APT 1/2 DAY CLEARING REQUIRED
 FOR FILE 080 VISION.*

Checked _____

GEODETTIC SURVEY OF N.S.W.

CENTRAL MAPPING AUTHORITY

GEODETTIC STATION RECONNAISSANCE and MAINTENANCE REPORT

STATION: **WARRISE G.S. (P)** No.: **6295**
 MAP SHEET SCALE 1:250 000 **HASTINGS**
 INSPECTED BY: **L.R. HOLLIS** DATE: **24.3.19**
 AUTHORITY: **CPMHA** FIELD BOOK: **1668**

- Description: **360°** Note: Cross out word or words which do not apply
- Cleared by lanes bearing..... **360°**..... from Trig. Mast
 - Mast & Vanes have been painted white & black respectively. ✓
 - The ~~station~~/pillar was ~~reconstructed~~/constructed on..... **23.4.19**....., dimensions now being: Description of mark: **S. Steel Pillar Plate, Steel plug, Brass plug, Bolt, G.I. Pipe**
 - Height of mark..... **1.70**.....m. Mark is **1.70**.....m. ^{above} ~~below~~ G.L.
 - Height of Top Vanes to Top ~~Mark~~/Pillar plate **1.100**.....m. Diameter of Vanes (vertical): **0.150**.....m.
 - Height of Cairn.....m. Diameter of Cairn.....m. Name Plate ~~found~~/not ~~found~~/placed.
 - Length of Mast.....m. (approximate if not unplied)
 - BRASS TRIG PILLAR**.....set in conc/~~rock~~ has been ~~placed~~/found, bearing..... **0**.....°M from ~~Mark~~/Trig/Pillar
 - Collet Nail in**.....set in conc/~~rock~~ has been placed/~~found~~, bearing..... **270**.....°M from ~~Mark~~/Trig/Pillar
 - A.....**.....set in conc/rock has been placed/~~found~~, bearing.....°M from Mast/Plug/Pillar
 - A.....**.....set in conc/rock has been placed/~~found~~, bearing.....°M from Mast/Plug/Pillar

STANDPOINT: **BRASS TRIG PILLAR**

Mark	Direction	Horiz. Distance	Height Difference	Mark	Direction	Horiz. Distance	Height Difference
MOONLA G.S. (P)	0 00 00	0 00 00	above standpt.	MOONLA G.S. (P)	0 00 00	0 00 00	below standpt.
Collet Nail in (hole)	83 17 25	5.446	below standpt.	Collet Nail in (hole)	52 23 40	372.9	above standpt.
BRASS TRIG PILLAR	115 04 20	3.110	below standpt.	BRASS NEST G.S.	202 14 10		below standpt.
BRASS NEST G.S.	212 10 30		below standpt.	Point obs. house	215 04 30.117		below standpt.
			below standpt.				below standpt.
			below standpt.				below standpt.
			below standpt.				below standpt.

Prepared by: **L.R. HOLLIS** Checked: **L.R. HOLLIS** Noted on U.T.M. Card



Station Diagram North Not to Scale

Checked

GS

STATION PARADISE C.S. RISE TS 6295

Owner's Name: MR BILL WALKER
 Address: 4110 BAYS HOME
 Phone: WAKARA

Current Occupant:
 Address:
 Phone:

ACCESS

Access Report of 23/10/21 was found suitable/unsuitable.

FEET/TRACE

0.00 PO. WAKARA HEAD NORTH TOWARDS WAKARA.

0.75 TURN RIGHT SIGN 'WAKARA PLAINS'

1.00 TURN RIGHT SIGN 'WAKARA PLAINS'

2.00 PASS ROAD ON LEFT

2.80 PASS ROAD ON RIGHT

3.00 CROSS ROAD TO RIGHT

3.30 CROSS ROAD TO RIGHT SIGN 'BULIMBA DOWNS'

3.40 FOLLOW ROAD STRAIGHT AHEAD SIGN 'BULIMBA DOWNS'

3.40 CROSS SIGN 'BULIMBA DOWNS'

3.50 TAKE LEFT HAND TRACE

3.60 CROSS

3.70 TAKE LEFT HAND TRACE

3.80 THROUGH DOOR POOR FENCE IN GULLY

3.90 PASS TRACE ON RIGHT

4.00 TAKE RIGHT HAND TRACE

4.10 FIRE BREAK FOLLOW BURNED TRACE

4.20 GEODETIC STATION PARADISE

Not to Scale

Beacon Diagram

This section to be completed by officer constructing pillar.

Original station mark found/.....

Description of mark: BRASS TRIP PIN

Original beacon found/.....

Description of beacon: CEMENT POLE x DISC

Height Top of Vanes to Top Mark 3.630 m.

Height of mark 0.75 m. above G.L. / below m. below

Diameter of Vanes 0.76 m. Height of Cairn 1.500 m.

Original Beacon has/..... been destroyed by me.