

GEODETTIC SURVEY OF N.S.W.

CENTRAL MAPPING AUTHORITY


GEODETTIC STATION RECONNAISSANCE and MAINTENANCE REPORT

STATION: ANTHILL No.: 630

MAP SHEET SCALE 1:250 000 SINGLETON

INSPECTED BY: M. HYMAN DATE: 1st Feb 80

AUTHORITY: C.M.A. NSW 289 FIELD BOOK: 1837

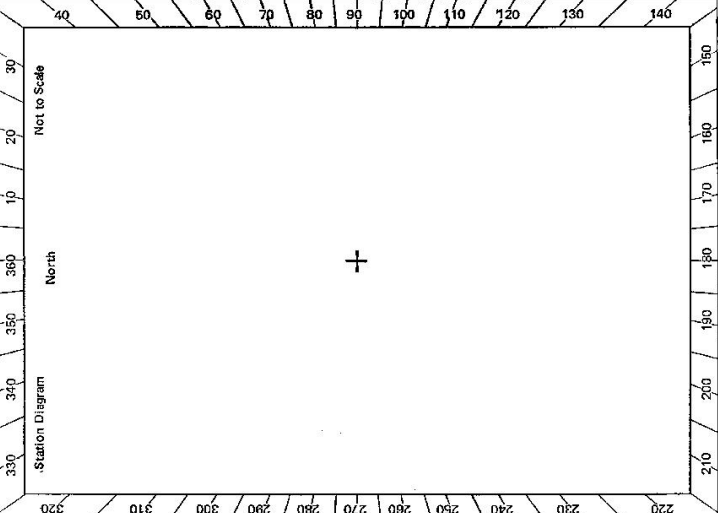

- Description: *360* Note: Cross out word or words which do not apply
1. Cleared by lanes bearing *360*..... from Trig. Mast
  2. Mast & Vanes have been painted white & black respectively.
  3. The station ~~found~~ *found* ~~unplied~~ *unplied* constructed on *1st Feb 1980*..... dimensions now being: Description of mark. *S.I. Plat. in conc.* should be explicit, e.g., S/Steel Pillar Plate, Steel plug, Brass plug, Bolt, G.I. Pipe  
Height of mark.....m. <sup>above</sup>/<sub>below</sub> rock/concrete; Mark is.....m. <sup>above</sup>/<sub>below</sub> G.L.  
Height of Top Vanes to Top Mark/Pillar plate.....m. Diameter of Vanes (vertical).....m.  
Height of Cairn.....m. Diameter of Cairn.....m. Name Plate ~~found~~ *not found*
  - Length of Mast.....m. (approximate if not unplied)  
*No witness marks found.*
  4. A..... set in conc/rock has been placed/found, bearing.....° M from Mast/Plug/Pillar
  5. A..... set in conc/rock has been placed/found, bearing.....° M from Mast/Plug/Pillar
  6. A..... set in conc/rock has been placed/found, bearing.....° M from Mast/Plug/Pillar
  7. A..... set in conc/rock has been placed/found, bearing.....° M from Mast/Plug/Pillar
  8. Action required *To be re-surveyed*.....

STANDPOINT:			
Mark	Grid Direction	Horiz. Distance	Height Difference
Bunnan	91°	7.0	above standpt.
Braybey	55	15.0	below
Cuan	72	16.2	below
Myall	94	21.3	below
Webimble	152	3.1	below
Myralven	143	4.8	below
Gundabri	201	12.8	below

STANDPOINT:			
Mark	Grid Direction	Horiz. Distance	Height Difference
Diamond	714	10.5	below standpt.
Tered	350	19.9	below standpt.
Wagar	185°	33	below standpt.
Bunnan west	355°	17	below standpt.

Checked: O. Nicks

Checked: O. Nicks

Prepared by: J. Jammy

SR 2733-1

