

GEODETTIC SURVEY OF M.S.W.

CENTRAL MAPPING AUTHORITY

GEODETTIC STATION RECONNAISSANCE and MAINTENANCE REPORT

Description:

Note: Cross out word or words which do not apply

- Cleared by lanes bearing... 347° - 359° M, 80° - 86° M, 168° M - 173° M, 268° - 279° M, 308° - 313° M
- Mast & Vanes have been painted white & black respectively. ✓
- The station/pillar was ~~upplied~~ ~~not supplied~~ / constructed on ~~353~~ ~~1975~~ ~~1975~~ m, dimensions now being: Description of mark... ~~1975~~ ~~1975~~ should be explicit, e.g., S/Steel Pillar Plate, Steel plug, Brass plug, Bolt, G.I. Pipe
- Height of mark... 1.360 m. ~~above~~ ~~below~~ ~~rock~~ / concrete; Mark is 2.130 m. ~~above~~ ~~below~~ G.L.
- Height of Top Vanes to Top ~~Mark~~ / Pillar plate ... 4.50 m. Diameter of Vanes (vertical) ... 7.50 m.
- Height of Cairn... m. Diameter of Cairn... m. Name Plate ~~found~~ / ~~not found~~ / placed. ✓
- Length of Mast... m. (approximate if not uplied)
- A... ~~1975~~ ~~1975~~ set in conc/rock has been ~~placed~~ / found, bearing... 233° M from ~~Mast~~ / ~~Plug~~ / Pillar
- A... ~~1975~~ ~~1975~~ set in conc/rock has been ~~placed~~ / found, bearing... 150° M from ~~Mast~~ / ~~Plug~~ / Pillar
- A... ~~1975~~ ~~1975~~ set in ~~conc~~ / ~~rock~~ has been ~~placed~~ / found, bearing... 303° M from ~~Mast~~ / ~~Plug~~ / Pillar
- A... set in conc/rock has been placed / found, bearing... $^{\circ}$ M from Mast / Plug / Pillar

8. Action required:

STANDPOINT: ~~1975~~ ~~1975~~


Mark	Direction	Horiz. Distance	Height Difference	Mark	Direction	Horiz. Distance	Height Difference
Vertical Marker P	0° $00'$		above standpt.	Vertical Marker P	0° $00'$		above standpt.
Brass Trig. Peg	58° $24'$	2.657	below standpt.	Moona P	98° $22'$	0.00	above standpt.
Moona P	98° $21'$	55	above standpt.	G.I. Pipe P	157° $38'$	50	below standpt.
G.I. Pipe	117° $58'$	5.415	below standpt.	Pillar Plate	238° $05'$	30	above standpt.
Cairn Wall	311° $07'$	3.215	below standpt.	Cairn Wall	246° $10'$	20	below standpt.

Prepared by: ~~1975~~ ~~1975~~

Checked:

Noted on U.T.M. Card

St: 2733-1

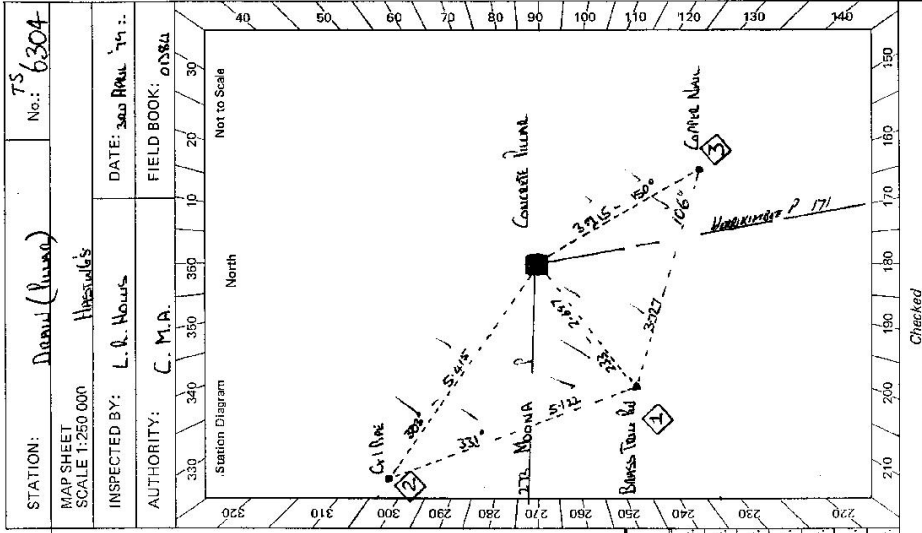

Checked

Station Diagram

North

Not to Scale

STATION: ~~1975~~ ~~1975~~ No.: 6304

MAP SHEET: H1950/000

INSPECTED BY: L. R. HOURS

DATE: 30th April 74

AUTHORITY: C. M.A.

FIELD BOOK: 01584

TS 6304
No.: 4338

CENTRAL MAPPING AUTHORITY
GEODEIC SURVEY OF N.S.W.

GEODEIC STATION RECONNAISSANCE and MAINTENANCE REPORT

Description:
Note: Cross out word or words which do not apply

1. Cleared by lanes bearing..... from Trig, Mast
2. Mast & Vanes have been painted white & black respectively.
3. The station/pillar was unpiled/not unpiled/constructed on..... 19....., dimensions now being:
Description of mark..... should be explicit, e.g., S/Steel Pillar Plate, Steel plug, Brass plug, Bolt, G.I. Pipe
Height of mark.....m. ^{above} rock/concrete; Mark is.....m. ^{above} G.I.P.
- Height of Top Vanes to Top Mark/Pillar plate.....m. Diameter of Vanes (vertical).....m.
- Height of Cairn.....m. Diameter of Cairn.....m. Name Plate found/not found/placed.
- Length of Mast.....m. (approximate if not Copied)
4. A..... set in conc/rock has been placed/found, bearing.....° M from Mast/Plug/Pillar
5. A..... set in conc/rock has been placed/found, bearing.....° M from Mast/Plug/Pillar
6. A..... set in conc/rock has been placed/found, bearing.....° M from Mast/Plug/Pillar
7. A..... set in conc/rock has been placed/found, bearing.....° M from Mast/Plug/Pillar
8. Action required:.....

STANDPOINT:

Mark	Direction	Horiz. Distance	Height Difference	Mark	Direction	Horiz. Distance	Height Difference
			above standpt.				above standpt.
			below				below
			above standpt.				above standpt.
			below				below
Prepared by: AS 14-3-80

Checked:

17/7/80

Noted on U.T.M. Card


St. 2733-1

STATION: DRAIN

MAP SHEET SCALE 1:250 000

INSPECTED BY: N. Krahe

AUTHORITY: CMA
DATE: 2-8-79
amended on FIELD BOOK, xerox, field copy

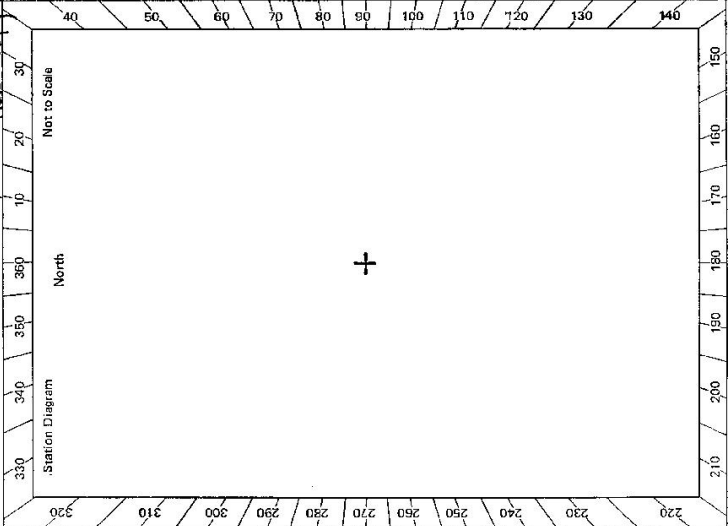

Checked

SI 2733-2 D. West, Government Printer

Beacon Diagram	Not to Scale	STATION
		<p style="font-size: 1.2em; font-weight: bold;">DRAIN TS 6304</p> <p>Current Occupant:</p> <p>Address:</p> <p>Phone:</p> <p style="text-align: center;">ACCESS 4WD 2-8-1979</p> <p>Access Report of 3/4/1979 was found unsuitable (unsuitable).</p> <p>From WALCHA travel east along Oxley Hwy towards Fort Macquarie for about 54km. Just after Yarowitch take Kangaroo Flat Rd (SP) to left at 0.0km</p> <p>15.6 Through gate</p> <p>20.0 Take right fork towards "Burraki"</p> <p>22.5 Through gate & turn right</p> <p>27.1 Pass track on right near hut & bus</p> <p>29.3 Take right fork</p> <p>31.8 Pass "Moorsback" road on right</p> <p>36.8 Take right fork</p> <p>38.1 Take left fork through gate following track to right of buildings</p> <p>38.5 Through gate</p> <p>39.3 Pass track on right</p> <p>39.6 Turn right off main track</p> <p>39.7 DRAIN Δ</p>
<p>This section to be completed by officer constructing pillar.</p> <p>Original station mark found/not found.</p> <p>Description of mark:</p> <p>Original beacon found/not found.</p> <p>Description of beacon:</p> <p>Height Top of Vanes to Top Markm.</p> <p>Height of markm. above rock/concm. below G.L.</p> <p>Diameter of Vanesm. Height of Cairnm.</p> <p>Original Beacon has/has not been destroyed by me.</p>		
		<p>Date</p> <p>Record of Station</p>