


STATION	WANDELLA (P) TS 6307
Owner's Name: <u>CROWN LANDS</u> Address: <u>FORESTY COMMISSION</u> <u>NAROOMA</u> Phone: Current Occupant: Address: Phone:	ACCESS Access Report of 27/10/1978 was found suitable/unsuitable. from Colargo Hotel 0.0 km take road opposite hotel to YORRIE (westward) Wandellaw Rd. passing Miralme lane on L.H.S at 2.2 km then into intersection FANDELOW 4% - YORRIE 10. at 6.6 km take YORRIE road to left passing County Boy Rd on L.H.S at 8.1 km then passing link road on R.H.S at 8.9 km then across ILANABARA creek at 11.8 km still following YORRIE road to turn right at 15.1 km onto forestry track and through gate at 16.8 km then through next gate at 17.3 km then on to intersection at 18.4 km take track to right, follows track to top of ridge at 23.5 km turn right up steep grade to Cons. Pillar at 23.8 km

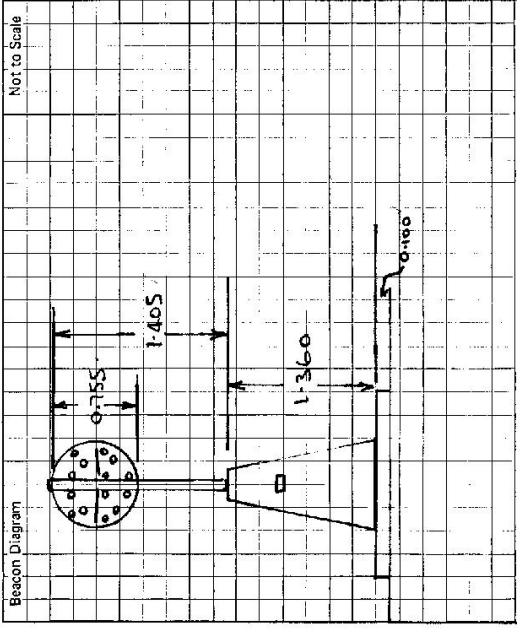

This section to be completed by officer constructing pillar.

Original station mark found/~~not found~~.

Description of mark: Orange Tin Pole for mark
below five towers.

Original beacon ~~found~~/not found.

Description of beacon:

Height Top of Vane to Top Mark.....m.

Height of mark 0.25 m. above rock below above G.L. below

Diameter of Vane.....m. Height of Cairn.....m.

Original Beacon ~~has~~ has not been destroyed by me.

Date	Record of Station

CENTRAL MAPPING AUTHORITY

GEODETTIC SURVEY OF N.S.W.

GEODETTIC STATION RECONNAISSANCE and MAINTENANCE REPORT

Description:

1. Cleared by lanes bearing.....
Note: Cross out word or words which do not apply
..... from Trig. Mast
2. Mast & Vanes have been painted white & black respectively.
3. The station/pillar was unpiled/~~not used~~ on 25th Sept. 1984, dimensions now being:
Description of mark: 45. Pillar Plate should be explicit, e.g., S/Steel Pillar Plate. Steel plug, Brass plug, Bolt, G.I. Pipe

- Height of mark.....m. above rock/concrete; Mark is.....m. above G.L.
 Height of Top Vanes to Top Mark/Pillar plate.....m. Diameter of Vanes (vertical).....m.
 Height of Cairn.....m. Diameter of Cairn.....m. Name Plate found/not found/placed.
 Length of Mast.....m. (approximate if not unpiled)
 4. A...Trig. Plug.....set in ~~conc~~/rock has been placed/found, bearing.....°M from Mast/Plug/Pillar
 5. A...SSM.....set in ~~conc~~/rock has been placed/found, bearing.....°M from Mast/Plug/Pillar
 6. A...G.I. Pipe.....set in ~~conc~~/rock has been placed/found, bearing.....°M from Mast/Plug/Pillar
 7. A.....set in ~~conc~~/rock has been placed/found, bearing.....°M from Mast/Plug/Pillar

8. Action required:.....

STANDPOINT: <u>Conc. Pillar</u>				STANDPOINT: <u>Trig. Plug</u>			
Mark	Direction	Horiz. Distance	Height Difference	Mark	Direction	Horiz. Distance	Height Difference
<u>Trig. Plug</u>		<u>6.629/1.547</u>	<u>above standpt.</u>	<u>Pillar Plate</u>		<u>6.631/1.547</u>	<u>above standpt.</u>
<u>G.I. Pipe</u>		<u>2.432/1.439</u>	<u>below</u>	<u>SSM</u>		<u>4.011/0.071</u>	<u>below standpt.</u>
<u>SSM</u>		<u>7.658/1.618</u>	<u>below</u>	<u>G.I. Pipe</u>		<u>5.107</u>	<u>above standpt.</u>
STANDPOINT:							
<u>SSM</u>	<u>G.I. Pipe</u>	<u>7.369</u>	<u>below</u>				<u>below standpt.</u>
<u>Trig. Plug</u>		<u>5.107</u>	<u>below</u>				<u>below standpt.</u>
<u>Pillar Plate</u>		<u>2.432/1.439</u>	<u>below</u>				<u>below standpt.</u>

Prepared by: J. R. Wallace

Checked: KA

9/11/84

Noted on U.T.M. Card

9.10.84

Checked: KA

9/11/84

STATION: WANDELLA (P) No.: 6307
 MAP SHEETS SCALE 1:100 000 COBARGO
 INSPECTED BY: J. R. WALLACE DATE: 25.9.84
 AUTHORITY: CMA FIELD BOOK: —

Station Diagram
 North
 Not to Scale

ST 2733-2 D. West, Government Printer Beacon Diagram Not to Scale	<p style="text-align: center;">STATION WANDELLA (P) TS 6307</p> <p>Owner's Name: Address: Phone:</p> <p>Current Occupant: Address: Phone:</p> <p>Phone: 25-9-1984</p> <p>ACCESS 25-9-1984</p> <p>Access Report of 27/10/1978 was found unsuitable unsuitable.</p> <p><i>Access as previously reported, except that at 19.5 km take left hand track 23.5 km take track to right, up steep grade to 23.8 km Wandella Pillar</i></p>	This section to be completed by officer constructing pillar. Original station mark found/not found. Description of mark: Original beacon found/not found. Description of beacon: Height Top of Vanes to Top Markm. Height of markm. above G.L. below Diameter of Vanesm. Height of Cairnm. Original Beacon has/has not been destroyed by me.
		Date Record of Station