

CENTRAL MAPPING AUTHORITY

GEODETIC SURVEY OF N.S.W.


GEODETIC STATION RECONNAISSANCE and MAINTENANCE REPORT

STATION: BOSIA (Pillar) No.: 6314

MAP SHEET SCALE 1:250 000 DORRIGO

INSPECTED BY: W M Gillivray DATE: 9-7-79

AUTHORITY: CMA FIELD BOOK: 662

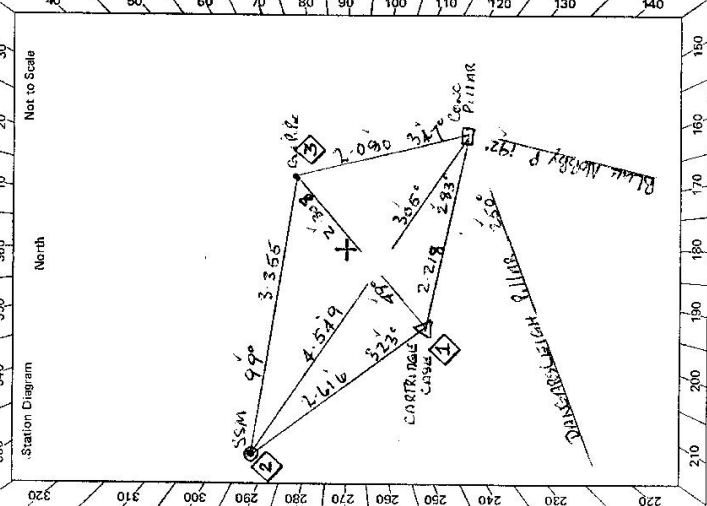

- Description:
- Cleared by lanes bearing 36.0°. Note: Cross out word or words which do not apply
 - Mast & Vanes have been painted white & black respectively.
 - The station/pillar was unplied/not unplied/constructed on 7.7.1979, dimensions now being: Description of mark S.S.M. Pillar should be explicit, e.g., S/Steel Pillar Plate, Steel plug, Brass plug, Bolt, G.I. Pipe
Height of mark 1.375 m. above rock/concrete; Mark is 3.95 m. above G.L. ✓
Height of Top Vanes to Top Mark/Pillar plate 1.437 m. ✓ Diameter of Vanes (vertical) 0.755 m.
Height of Cairn 0.571 m. Diameter of Cairn 0.571 m. Name Plate found/not found/placed.
Length of Mast 1.571 m. (approximate if not unplied)
 - CARRIDGE CASE set in conc/rock has been placed/found, bearing 283.6° M from Mast/Plug/Pillar
 - S.S.M. set in conc/rock has been placed/found, bearing 305.6° M from Mast/Plug/Pillar
 - G.I. Pipe set in conc/rock has been placed/found, bearing 347.0° M from Mast/Plug/Pillar
 - A. set in conc/rock has been placed/found, bearing 219.0° M from Mast/Plug/Pillar
 - Action required:

Mark	Direction	Horiz. Distance	Height Difference	Mark	Direction	Horiz. Distance	Height Difference
<u>Black Mercury P.</u>	<u>359 69 60</u>	<u>359 69 60</u>	above standpt.	<u>Black Mercury P.</u>	<u>359 69 60</u>	<u>359 69 60</u>	above standpt.
<u>DARRIGAN P.</u>	<u>58 25 50</u>	<u>58 25 50</u>	above standpt.	<u>DARRIGAN P.</u>	<u>58 25 50</u>	<u>58 25 50</u>	above standpt.
<u>CARRIDGE CASE</u>	<u>91 23 25</u>	<u>2.217</u>	above standpt.	<u>S.S.M.</u>	<u>131 13 05</u>	<u>2.616</u>	above standpt.
<u>S.S.M.</u>	<u>113 02 05</u>	<u>4.549</u>	above standpt.	<u>G.I. Pipe</u>	<u>216 43 50</u>	<u>2.308</u>	above standpt.
<u>G.I. Pipe</u>	<u>156 21 00</u>	<u>2.030</u>	above standpt.	<u>BOSIA Pillar</u>	<u>271 25 00</u>	<u>2.219</u>	above standpt.
			below standpt.				below standpt.
			below standpt.				below standpt.


STANDPOINT: CONCRETE PILLAR STANDPOINT: CARRIDGE CASE
 Prepared by: W M Gillivray 20/4/79 Noted on U.T.M. Card
 Checked: W M Gillivray

STATION **BORA (VILLAGE) 6314**

Owner's Name: **M.A. I.M.A.R.**
 Address:
 Phone:
 Current Occupant:
 Address:
 Phone:

ACCESS
 Access Report of:/19..... was found suitable/unsuitable.

- 0.0 FROM ARMADALE TAKE DORRIGO ROAD FOR 23 KM TURN RIGHT ONTO GRAVEL ROAD SIGN HILLEROVE, BAKERS CREEK FALLS
- 4.5 TURN RIGHT SIGN HILLEROVE, KEMBRAY GRANITON
- 6.8 TURN LEFT SIGN LONGE POINT ROAD
- 9.0 TURN LEFT SIGN EDGARS ROAD, GATE.
- 10.6 GATE.
- 10.8 GATE. FOLLOW TRACK PAST HOUSE.
- 11.1 OWNERS HOUSE
- 11.2 GATE.
- 11.5 GATE
- 11.7 GATE GO THROUGH + TURN SHARP LEFT FOLLOW POINT TRACK.
- 13.0 G.S.

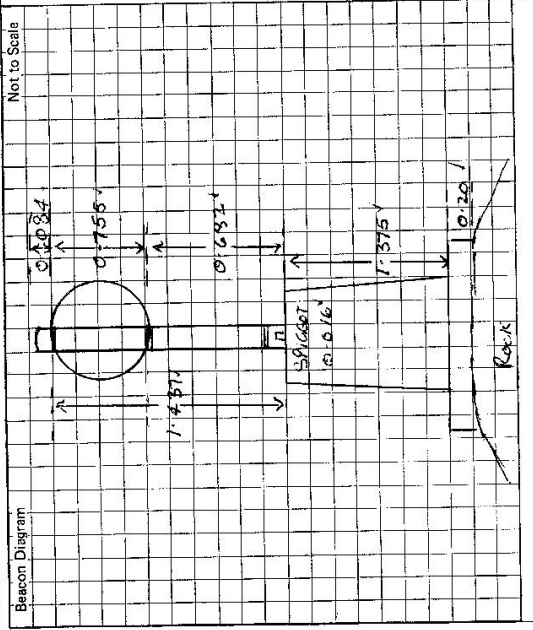

Beacon Diagram Not to Scale

This section to be completed by officer constructing pillar.
 Original station mark found/~~not found~~.
 Description of mark: **CARRIAGE CASE**
 Original beacon found/~~not found~~.
 Description of beacon: **CAIRN MARK V. V. MARKS**
 Height Top of Vanes to Top Mark: **3.398** m.
 Height of mark: **0.022** m. above rock/~~cont~~ **0.150** m. above G.L. below
 Diameter of Vanes: **0.975** m. Height of Cairn: **1.50** m.
 Original Beacon has/~~has not been~~ destroyed by me.

Date	Record of Station

CENTRAL MAPPING AUTHORITY

GEODETIC SURVEY OF N.S.W.

GEODETIC STATION RECONNAISSANCE and MAINTENANCE REPORT

Description:

1. Cleared by lanes bearing.....
Note: Cross out word or words which do not apply
2. Mast & Vanes have been painted white & black respectively.
from Trig. Mast
3. The station/pillar was unpiled/not unpiled/constructed on.....
19....., dimensions now being:
- Description of mark.....
should be explicit, e.g., Steel Pillar Plate, Steel plug, Brass plug, Bolt, G.I. Pipe
- Height of mark.....
above rock/concrete; Mark is.....m. below G.L.
- Height of Top Vanes to Top Mark/Pillar plate.....
Diameter of Vanes (vertical).....m.
- Height of Cairn.....
Diameter of Cairn.....m. Name Plate found/not found/placed.
- Length of Mast.....
(approximate if not-empiled)
4. A.....
set in conc/rock has been placed/found, bearing.....° M from Mast/Plug/Pillar
5. A.....
set in conc/rock has been placed/found, bearing.....° M from Mast/Plug/Pillar
6. A.....
set in conc/rock has been placed/found, bearing.....° M from Mast/Plug/Pillar
7. A.....
set in conc/rock has been placed/found, bearing.....° M from Mast/Plug/Pillar
8. Action required.....

STANDPOINT:

Mark	Direction	Horiz. Distance	Height Difference	Mark	Direction	Horiz. Distance	Height Difference
			above standpt				above standpt
			below standpt				below standpt
			above standpt				above standpt
			below standpt				below standpt
Prepared by: *m. v. red.*

Checked: *W. J. 13/14*

Noted on U.T.M. Card


SR 2733-1

STATION: BORA USDP No.: 6314-1064

MAPSHEET SCALE 1:250 000 DORRIGO

INSPECTED BY: C. ZAHRA DATE: 23-10-19

AUTHORITY: CMA FIELD BOOK: *xxxx*

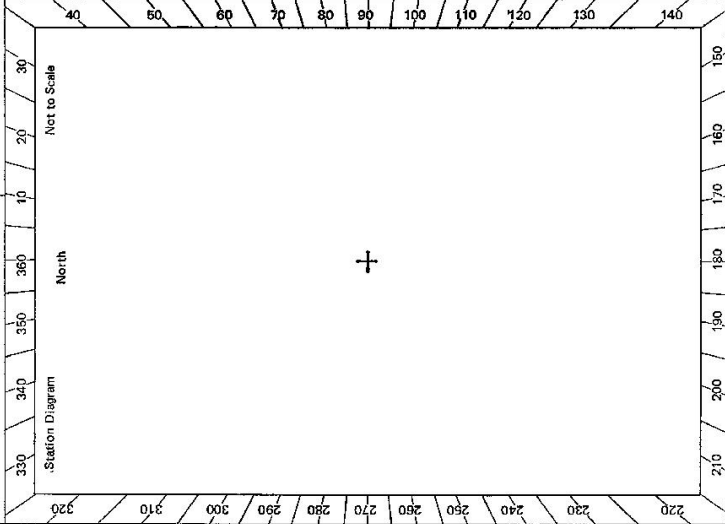

Checked

