


6316  
 STATION **TS 10571 MARTINS LOOKOUT (P)**  
 Co: **GOUGH** Ph: **GLEN INNES**  
 Map Sheet: **GLEN INNES** No: **9238**  
 Inspected by: **E.J.GARVIN & R.CUBIS** Date: **14/7/16 & 3/5/1979**  
 Authority: **INTEGRATION SURVEYS** Field Book: **11724 & 1357**

Beacon Diagram  
 Not to Scale

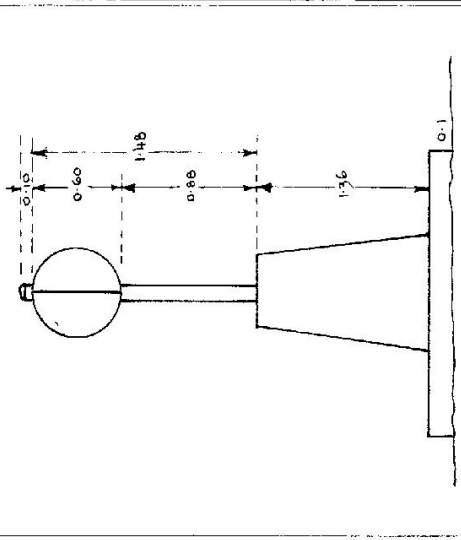

Date	Record of Station
28.8.78	PILLARS ERECTED - J. CARTER.

Department of Lands  
 Integral Survey of N.S.W.  
 RECONNAISSANCE and MAINTENANCE REPORT

This Trig. Station has been:-  
 Note: Cross out word or words which do not apply

1. Completely cleared to permit 360° vision to surrounding Trigs.
2. Cleared by lances bearing 160° M - 345° M from Trig. Mast
3. Trig. Mast & Vanes have been painted white & black respectively.
4. The Trig. was unpiled/not unpiled, dimensions now being:

Description of mark: **CONCRETE OBSERVING PILLAR** should be explicit, e.g. Steel plug, Brass plug, Bolt, Concrete Pillar  
 Height of mark: 1.36 m above rock concrete 1.5 m above G.L.  
 Height of Top Vanes to Top Mark/Top pillar plate: 1.48 m Diameter of Vanes (vertical): 0.60 m.

- Height of Centre: Diameter of Centre
5. A **Copper Spike** set in conc./soil has been placed/d 15.754 m. bearing 327° M from Trig. Mast/pillar
  6. A **Copper Spike** set in conc./soil has been placed/d 3.749 m. bearing 119° M from Trig. Mast/pillar
  7. A set in conc./soil has been placed/d ..... m. bearing .....° M from Trig. Mast/pillar
  8. A set in conc./rock has been placed/d ..... m. bearing .....° M from Trig. Mast/pillar

9. Connection: **55M** to **Copper Spike**: 18.970 m. bearing 112° M
10. Connection: to ..... m. bearing .....° M
11. Connection: to ..... m. bearing .....° M
12. Connection: to ..... m. bearing .....° M
13. Diff. Ht. **55M 36064** is 1.770 m. above Pillar Plate
14. Diff. Ht. **Copper Spike** is 1.201 m. below Pillar Plate
15. Diff. Ht. **Copper Spike** is 0.569 m. above
16. Diff. Ht. is ..... m. below

Prepared by: **R. Cubis (Trig. Surveyor)** Checked: **[Signature]**



GEODETIC SURVEY OF A.S.W.

CENTRAL MAPPING AUTHORITY

GEODETIC STATION RECONNAISSANCE and MAINTENANCE REPORT

Description: *Note: Cross out word or words which do not apply*

1. Cleared by lanes bearing *160° 0' - 345° 0'* from Trig. Mast
2. Mast & Vanes have been painted white & black respectively.
3. The station/pillar was unpiled/~~re-constructed~~ on *29.9*..... *1981*....., dimensions now being: Description of mark: *STEEL PILLAR PLATE* could be explicit, e.g., S/Steel Pillar Plate, Steel plug, Brass plug, Bolt, G.I. Pipe  
Height of mark *1.360*.....m. <sup>above</sup> rock/concrete; Mark is *1.450*.....m. <sup>above</sup> G.L.  
Height of Top Vanes to Top Mast/Pillar plate *1.435*.....m. Diameter of Vanes (vertical) *0.750*.....m.  
Height of Cairn.....m. Diameter of Cairn.....m. Name Plate ~~found~~/not found/~~placed~~.  
Length of Mast.....m. (approximate if not unpiled)
4. A. *SSM 3484* set in conc/rock has been ~~placed~~/found, bearing *32.7*.....° M from Mast/~~Trig~~/Pillar
5. A. *Cap. Sp. 6* set in conc/rock has been ~~placed~~/found, bearing *113*.....° M from Mast/~~Trig~~/Pillar
6. A..... set in conc/rock has been placed/~~found~~, bearing.....° M from Mast/~~Trig~~/Pillar
7. A..... set in conc/rock has been placed/~~found~~, bearing.....° M from Mast/~~Trig~~/Pillar
8. Action required: *Name plate to be placed*

STANDPOINT:

Mark	Direction	Horiz. Distance	Height Difference	Mark	Direction	Horiz. Distance	Height Difference
			above standpt.				above standpt.
			below standpt.				below standpt.
			above standpt.				above standpt.
			below standpt.				below standpt.
Prepared by: *[Signature]*

Checked: *[Signature]*

Noted on U.T.M. Card

Checked

STATION: *MARTINS LOOKOUT (P)* No.: *6316*

MAP SHEET SCALE 1:250 000

INSPECTED BY: *D SHARDELL* DATE: *29/9/81*

AUTHORITY: *CMA* FIELD BOOK:

Station Diagram

North

Not to Scale

*NEW MAST & VANES PLACED*

ST: 2733-2 D. West, Government Printer Beacon Diagram		STATION <b>MARTINS LOCKERT (P) TS 6316</b>  Owner's Name: ..... Address: ..... Phone: ..... Current Occupant: ..... Address: ..... Phone: ..... Access Report of...../...../19.....was found suitable/unsuitable. <b>ACCESS</b>
This section to be completed by officer constructing pillar. Original station mark found/not found. Description of mark: ..... Original beacon found/not found. Description of beacon: ..... Height Top of Vanes to Top Mark.....m. Height of mark.....m. above rock/cond.....m. above G.L., below.....m. below.....m. Diameter of Vanes.....m. Height of Cairn.....m. Original Beacon has/has not been destroyed by me.		Date Record of Station

CENTRAL MAPPING AUTHORITY

GEODETTIC STATION RECONNAISSANCE and MAINTENANCE REPORT

Description:  
 Cleared by lances bearing NEW BEALON ONLY from Trig. Mast

Mast & Vanes have been painted white & black respectively.

The station/pillar was unpiled/~~not unpiled~~/~~constructed~~ on 3.1 - 8 dimensions now being:

Description of mark S/S. Pillar should be explicit, e.g., S/Steel Pillar Plate, Steel plug, Brass plug, Bolt, G.I. Pipe

Height of mark 1.42 m. <sup>above</sup>/<sub>below</sub> G.L. 0.75 m. Diameter of Vanes (vertical) 0.75 m.

Height of Cairn 0.75 m. Diameter of Cairn 0.75 m. Name Plate found/not found/placed.

Length of Mast 0.75 m. (approximate if not unpiled)

4. A. set in conc/rock has been placed/found, bearing 198.2 °M from Mast/Plug/Pillar

5. A. set in conc/rock has been placed/found, bearing 198.2 °M from Mast/Plug/Pillar

6. A. set in conc/rock has been placed/found, bearing 198.2 °M from Mast/Plug/Pillar

7. A. set in conc/rock has been placed/found, bearing 198.2 °M from Mast/Plug/Pillar

8. Action required: None

STANDPOINT:		STANDPOINT:		STANDPOINT:		STANDPOINT:	
Mark	Direction	Horiz. Distance	Height Difference	Mark	Direction	Horiz. Distance	Height Difference
			above standpt				above standpt
			below				below
			above standpt				above standpt
			below				below
Prepared by: SAHAB 30/3/87 Checked: U.T.M. Corp 11/5/87

ST 2733-1

STATION: MARTINS LOOKOUT No.: 6316  
 MAP SHEET GRAFTON  
 SCALE 1:250 000  
 INSPECTED BY: A. GARSDIE DATE: 31-8-82  
 AUTHORITY: C 171 A FIELD BOOK: ---

CENTRAL MAPPING AUTHORITY

GEODETIC SURVEY OF M.S.W.

GEODETIC STATION RECONNAISSANCE and MAINTENANCE REPORT

STATION: MARTINS LOOKOUT (P) No: 6316

Description:

1. Cleared by James bearing  $175^{\circ} 32'$  -  $322^{\circ} 33'$  -  $236^{\circ} 35'$  from Trig. Mast WEST SIDE OF HILL TO THE EAST ON THE HIGH POINT OF TRENCH IS THE TOWN WATER TREATMENT PLANT
2. Mast & Vanes have been painted white & black respectively. **See Skt Plats, Martins Lookout (P) SSM 36064.**
3. The station/pillar was unpiled/not unpiled/constructed on..... 19....., dimensions now being:

Description of mark/s: **PLANK PLATE** should be explicit, e.g., S/Steel Pillar Plate, **Steel plug**, **Blasest plug**, **Belt**, **G.I. Pipe**

Height of mark:  $1.360$  m. above reek/concrete; Mark is  $1.360$  m. above G.L.

Height of Top Vanes to Top Mark/Pillar plate:  $1.420$  m. Diameter of Vanes (vertical):  $0.750$  m.

Height of Cairn: ..... m. Diameter of Cairn: ..... m. Name Plate found/not found/placed.

Length of Mast: ..... m. (approximate if not unpiled)

4. A. **C.U. NAIL** set in conc/reek has been placed/found, bearing  $110^{\circ}$  M from Mast/Plug/Pillar

5. A. **SSM 36064** set in conc/reek has been placed/found, bearing  $332^{\circ}$  M from Mast/Plug/Pillar

6. A. set in conc/rock has been placed/found, bearing ..... M from Mast/Plug/Pillar

7. A. set in conc/rock has been placed/found, bearing ..... M from Mast/Plug/Pillar

8. Action required: **DALL HOLE IN CONC FOUND IN CONC AT 120 AND ABOUT 50 METRES RESPECTIVELY**


STANDPOINT:		CONC PILLAR		STANDPOINT:		C.U. NAIL	
Mark	Direction	Horiz. Distance	Height Difference	Mark	Direction	Horiz. Distance	Height Difference
ROSS (P)	0 00 00	✓	above standpt	ROSS	0 00 00	✓	above standpt
RURAL (P)	42 37 40	✓	above standpt	CONC PILLAR	39 26 20	3.757	1.203 below standpt
SSM 36064	75 17 00	15.753	1.712 above standpt	RURAL (P)	42 37 00	✓	above standpt
BULLOCK	91 41 20	✓	above standpt	SSM 36064	68 36 20	18.929	0.570 above standpt
C.U. NAIL	219 26 40	3.759	1.201 above standpt	BULLOCK (P)	91 40 00	✓	above standpt
NOTE: Bullock head to see.			above standpt				above standpt
			below standpt				below standpt
			below standpt				below standpt

Prepared by: *J. Stand* Checked: *AS 20/1/85* Noted on U.T.M. Card *MA*

MAP SHEET SCALE 1:250 000

INSPECTED BY: G. FORD DATE: 16-12-84


AUTHORITY: C.M.A. FIELD BOOK: C 377

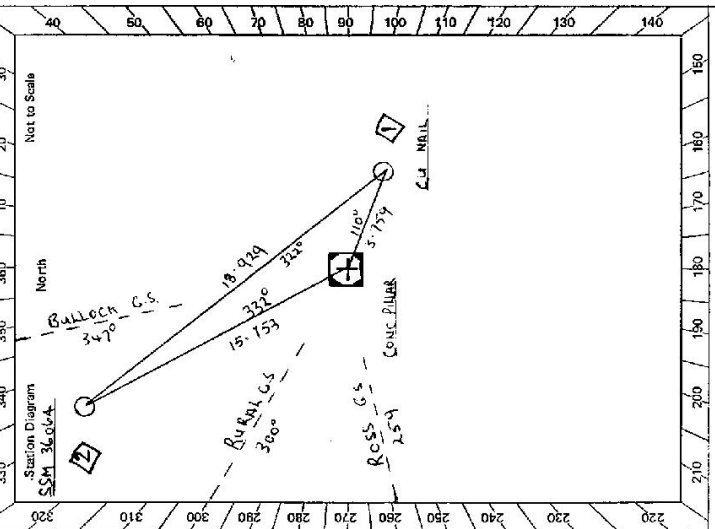

Checked: 14/2 7385

en 2739-2 D. West. Government Printer

Beacon Diagram

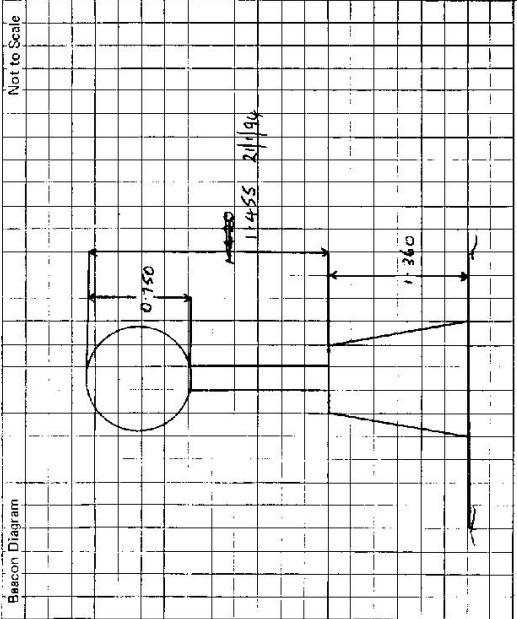

This section to be completed by officer constructing pillar.

Original station mark found/not found.

Description of mark: .....

Original beacon found/not found.

Description of beacon: .....

Height Top of Vanes to Top Mark.....m.

Height of mark.....m. above G.L. below rock/cant.

Diameter of Vanes.....m. Height of Cairn.....m.

Original Beacon has/has not been destroyed by me.

STATION MARTINS LOCKOUT (PTS 6316)

Owner's Name: PARKS, KES  
 Address: .....  
 Phone: .....  
 Current Occupant: .....  
 Address: .....  
 Phone: .....

ACCESS

Access Report of 10.12.1981 was found suitable/unsuitable.

- 0.00 GLEN JAMES P.O. HEAD ALONG MEAD ST. TOWARDS
- GRAFTEN CROSSING NEWENGLAND HWY.
- 1.50 TURN RIGHT INTO CENTENNIAL PARKLANDS ROAD FOLLOW MAIN ROAD
- 2.15 HEAD AROUND TO BACK OF THE WATER TREATMENT PLANT
- 3.35 MARTINS LOCKOUT GS

Time: - Glen James to A 10 Minutes.

Date	Record of Station