

GEODETIC SURVEY OF M.S.K.

CENTRAL MAPPING AUTHORITY

GEODETIC STATION RECONNAISSANCE and MAINTENANCE REPORT


- Description:
- Cleared by lanes bearing  $360^\circ$ . Note: Cross out word or words which do not apply from **Flag-Mast Pillar**.
  - Mast & Vanes have been painted white & black respectively. ✓
  - The **system/pillar** was ~~unplaced/not-erected~~/constructed on  $27^{\text{th}}$  APRIL 1979, dimensions now being: **S/S Pillar. Plate** should be explicit, e.g., S/Steel Pillar Plate, Steel plug, Brass plug, Bolt, G.I. Pipe  
Height of mark  $1.370$  m. above ~~rock~~/concrete; Mark is  $0.755$  m. above G.L.  
Diameter of Vanes (vertical)  $0.755$  m.  
Height of Top Vanes to Top ~~Mark~~/Pillar plate  $1.470$  m.  
Diameter of Cairn  $0.755$  m. Diameter of Cairn  $0.755$  m. Name Plate ~~found~~/not found/placed.  
Length of Mast  $1.450$  m. (approximate if not unipled)
  - A. **COPPER NAIL** set in conc/~~rock~~ has been placed/~~found~~, bearing  $330^\circ$  M from ~~Mast/Flag~~/Pillar
  - A. **G.I. NAIL** set in conc/~~rock~~ has been placed/~~found~~, bearing  $70^\circ$  M from ~~Mast/Flag~~/Pillar
  - A. set in conc/~~rock~~ has been placed/~~found~~, bearing  $0^\circ$  M from Mast/~~Plug~~/Pillar
  - A. set in conc/~~rock~~ has been placed/~~found~~, bearing  $0^\circ$  M from Mast/~~Plug~~/Pillar
  - Action required: ~~None~~ **None plate to be placed.**

Mark	Direction	Horiz. Distance	Height Difference	Mark	Direction	Horiz. Distance	Height Difference
OMEO	OP 0 00 00		above standpt	OMEO	OP 0 00 00		above standpt
YELLOWIN	OP 86 45 30		above standpt	YELLOWIN	OP 86 45 30		above standpt
COPPER NAIL	178 07 10	5.058	above standpt	COPPER NAIL	94 16 10	2.114	above standpt
G.I. NAIL	274 14 00	2.115	above standpt	COPPER NAIL	156 20 00	5.699	above standpt
			below				below
			below				below
			below				below
			below				below

STANDPOINT: CONCL. PILLAR      STANDPOINT: G.I. NAIL

Prepared by: **A.C. BORDER**      Checked: *[Signature]*      Noted on U.T.M. Card

SI 2733-1

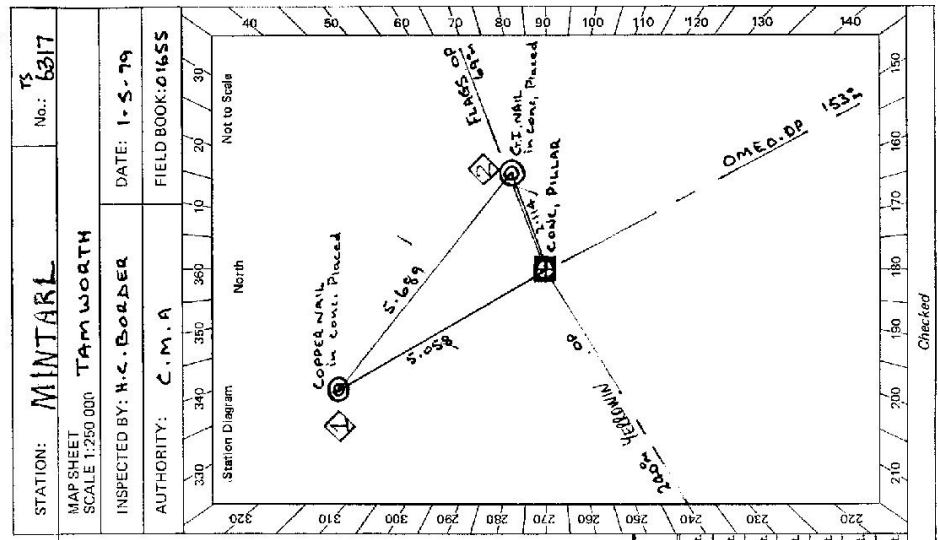


Checked

STATION: **MINTARL**      No.: **TS 6317**

MAP SHEET SCALE 1:250 000      **TAMWORTH**

INSPECTED BY: **A.C. BORDER**      DATE: **1-5-79**

AUTHORITY: **C.M.A**      FIELD BOOK: **01655**

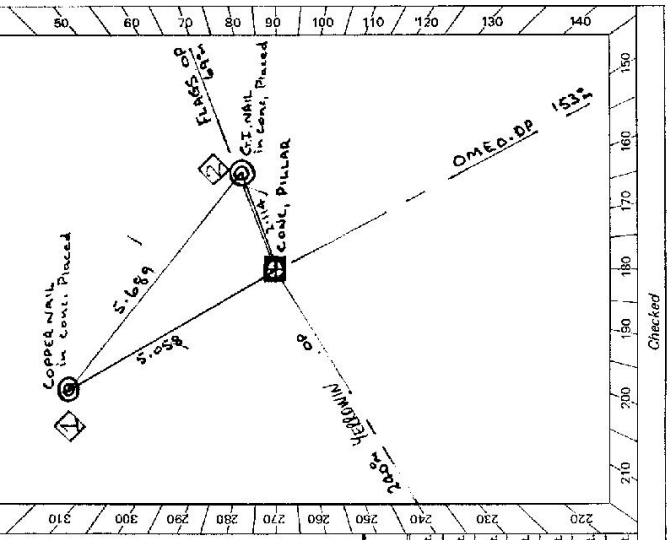







GEODETIC SURVEY OF N.S.W.

CENTRAL MAPPING AUTHORITY

GEODETIC STATION RECONNAISSANCE and MAINTENANCE REPORT

Description:

Note: Cross out word or words which do not apply

1. Cleared by lanes bearing..... from Trig, Mast
2. Mast & Vanes have been painted white & black respectively.
3. The station/pillar was unpiled/not unpiled/constructed on.....  
 Description of mark..... should be explicit, e.g., Steel/Ally/Plate, Steel plug, Brass plug, Bolt, G.I. Pipe  
 Height of mark.....m. <sup>above</sup> rock/concrete; <sub>below</sub> G.L.  
 Height of Top Vanes to Top Mark/Pillar plate.....m. Diameter of Vanes (vertical).....m.  
 Height of Cairn.....m. Diameter of Cairn.....m. Name Plate found/not found/placed.  
 Length of Mast.....m. (approximately not unpiled)
4. A..... set in conc./rock had been placed/found, bearing.....° M from Mast/Plug/Pillar
5. A..... set in conc./rock had been placed/found, bearing.....° M from Mast/Plug/Pillar
6. A..... set in conc./rock had been placed/found, bearing.....° M from Mast/Plug/Pillar
7. A..... set in conc./rock had been placed/found, bearing.....° M from Mast/Plug/Pillar
8. Action required:.....

STANDPOINT:

Mark	Direction	Horiz. Distance	Height Difference	Mark	Direction	Horiz. Distance	Height Difference
			above standpt.				above standpt.
			below standpt.				below standpt.
			above standpt.				above standpt.
			below standpt.				below standpt.
Prepared by: AS 14-3-80

Checked: 6/1/11 R

Noted on U.T.M. Card

SI 2735-1

STATION: MINTARL (P) MAP SHEET SCALE 1:250 000 INSPECTED BY: H. P. Jackson AUTHORITY: CMA	No.: 6317 DATE: 20-8-79 FIELD BOOK: 1766
--	--

Station Diagram

Not to Scale

Checked

