

7498

Trigonometrical Survey of N.S.W.

CENTRAL MAPPING AUTHORITY  
Department of Lands

RECONNAISSANCE and MAINTENANCE REPORT

This Trig. Station has been:-

Note: Cross out word or words which do not apply

1. Completely cleared to permit 360° vision to surrounding Trig.
2. Cleared by lanes bearing 236° m to 216° m from Trig. Mast
3. Trig. Mast & Vanes have been painted white & black respectively.
4. The Trig. was ~~unpiled~~/not unpiled, dimensions now being:
  - Description of mark..... should be explicit, e.g. Steel plug, Brass plug, Bolt, G.I. Pipe
  - Height of mark..... m above rock/concrete ..... m below G.L.
  - Height of Top Vanes to Top Mark..... m. Diameter of Vanes (vertical) 0.165 m.
  - Height of Cairn..... m. Diameter of Cairn 1.34 m.
  - Length of Mast 4.165 m. (approximate if not unpiled)

5. A..... set in conc/rock has been placed..... m. bearing.....°M from Trig. Mast
6. A..... set in conc/soil has been placed..... m. bearing.....°M from Trig. Mast
7. A..... set in conc/soil has been placed..... m. bearing.....°M from Trig. Mast
8. A..... set in conc/rock has been placed..... m. bearing.....°M from Trig. Mast
9. Connection..... to..... m. bearing.....°M
10. Connection..... to..... m. bearing.....°M
11. Connection..... to..... m. bearing.....°M
12. Connection..... to..... m. bearing.....°M
13. Diff. Ht. .... is..... m. <sup>above</sup>/<sub>below</sub>
14. Diff. Ht. .... is..... m. <sup>above</sup>/<sub>below</sub>
15. Diff. Ht. .... is..... m. <sup>above</sup>/<sub>below</sub>
16. Diff. Ht. .... is..... m. <sup>above</sup>/<sub>below</sub>

Prepared by: M.L. Morrison Checked: \_\_\_\_\_

Noted on U.T.M. Card

STATION BASALT \* 6320


Co: VERON Ph: TRINIDAD

Map Sheet: COUGARAL No: 5335

Inspected by: M.L. MORRISON Date: 11 AUGUST 1977

Authority: Field Book: 1581

Beacon Diagram Not to Scale

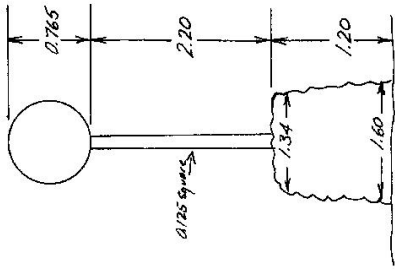

Date Record of Station

TRIG. STATION CARED FOR BY NEEDS PAINTING  
SSM M. BONE IS OFFICE IN CAROL


Checked

STATION BASALT 6320

Owners Name:.....  
 Current Occupant:.....  
 Address:.....  
 Address:.....

Access 17<sup>th</sup> August 1977

km	DIRECTION.
0.00	ON OXLEY HWY SIGN 'YARROWITCH' 0.5 km HEADWEST TOWARDS WALCWA.
6.00	TURN RIGHT INTO 'OAKLANDS RD'
12.05	DOGPOOF GATE AND FENCE
12.45	PASS RD ON LEFT.
13.25	GRID
15.80	TURN RIGHT THROUGH GATE INTO TRACK (JUST BEFORE GATE ON ROAD)
16.60	GATE
17.80	TAKE RIGHT HANDED TRACK.
17.85	GATE
17.95	TURN LEFT OFF TRACK MAKE ESNW WAY UP ROCKY HILL TO TRIG.
18.55	BASALT T.S.

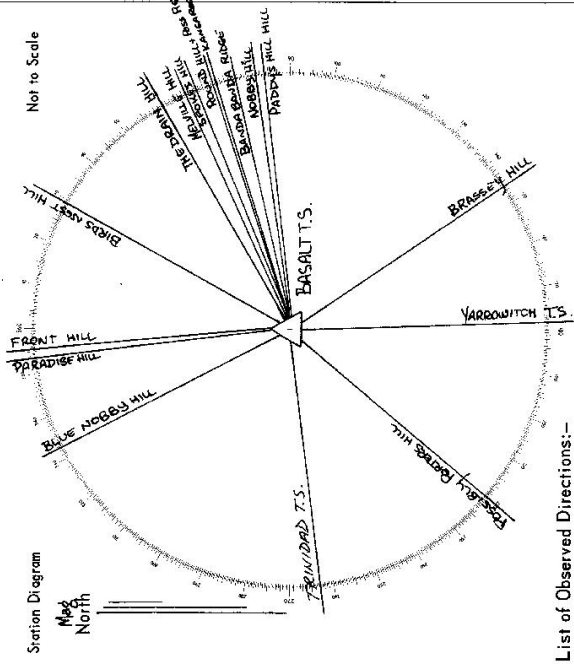

List of Observed Directions:-

Standpoint:	
Station	Direction


  

Standpoint:	
Station	Direction

CENTRAL MAPPING AUTHORITY

GEODETIC SURVEY OF M.S.W.  
 GEODETIC STATION RECONNAISSANCE and MAINTENANCE REPORT

STATION: Basant Road No.: 6320  
 MAP SHEET SCALE 1:250 000  
 INSPECTED BY: L.R. Naras DATE: 18th May 22  
 AUTHORITY: C.M.A. FIELD BOOK: 1671

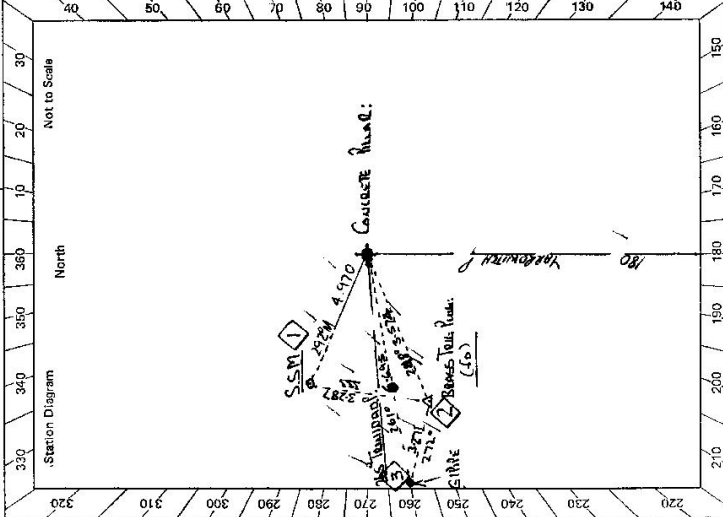

- Description: /   
 Note: Cross out word or words which do not apply
1. Cleared by lances bearing.....260.....217..... from Trig. Mast
  2. Mast & Vanes have been painted white & black respectively. ✓
  3. The ~~station~~/pillar was ~~unplaced/not unplaced~~/constructed on.....15th May 1979..... dimensions now being: Description of mark: S.S.M..... should be explicit, e.g., S/Steel Pillar Plate, Steel plug, Brass plug, Bolt, G.I. Pipe  
 Height of mark.....3.360.....<sup>above</sup> ~~below~~ 1.450.....<sup>above</sup> ~~below~~ m. Mark is: 1.450.....<sup>above</sup> ~~below~~ m.  
 Height of Top Vanes to Top ~~Mast~~/Pillar plate .....1.450..... m. Diameter of Vanes (vertical).....7.50.....m.  
 Height of Cairn..... m. Diameter of Cairn..... m. Name Plate ~~found/lost~~/found/placed. ✓  
 Length of Mast ..... m. (approximate if not unplied)
  4. A.....Basant Road..... set in conc/~~rock~~ has been ~~placed~~/found, bearing 248.....° M from ~~Mast/Plug~~/Pillar
  5. A.....S.S.M..... set in conc/~~rock~~ has been ~~placed~~/found, bearing 252.....° M from ~~Mast/Plug~~/Pillar
  6. A.....Concrete Pillar..... set in conc/~~rock~~ has been ~~placed~~/found, bearing 261.....° M from ~~Mast/Plug~~/Pillar
  7. A..... set in conc/~~rock~~ has been placed/.....° M from Mast/Plug/Pillar
- Action required:.....

STANDPOINT: <u>Concrete Pillar</u>			STANDPOINT: <u>Basant Road</u>				
Mark	Direction	Horiz. Distance	Height Difference	Mark	Direction	Horiz. Distance	Height Difference
<u>Concrete Pillar</u>	<u>0 00</u>	<u>0</u>	<u>0</u>	<u>Concrete Pillar</u>	<u>0 00</u>	<u>0</u>	<u>0</u>
<u>S.S.M</u>	<u>28 28</u>	<u>4.970</u>	<u>1.348</u>	<u>G.I. Pipe</u>	<u>11 18</u>	<u>3.271</u>	<u>3.514</u>
<u>Basant Road Plug</u>	<u>275 07</u>	<u>20</u>	<u>1.608</u>	<u>S.S.M</u>	<u>74 23</u>	<u>3.387</u>	<u>3.202</u>
<u>G.I. Pipe</u>	<u>358 38</u>	<u>30</u>	<u>1.256</u>	<u>Concrete Pillar</u>	<u>167 05</u>	<u>3.575</u>	<u>1.645</u>
				<u>Basant Road</u>	<u>275 00</u>	<u>40</u>	

Prepared by: 18/5/22 Checked: 18/5/22  
 Noted on U.T.M. Card

SI 2733-2 D. West, Government Printer

STATION Russell Island / 6320


Owner's Name: M. D. ...  
 Address: BULLOCKS  
 Phone: ...

Current Occupant: ...  
 Address: ...  
 Phone: ...

ACCESS

Access Report of 17.5/19.7.77 was found suitable/unavailable.

- 000 On Outlet Highway, Side KARAWATTA P.O. 0.5km, Tenet West, Townships Wharara
- 6.00 Turn Right Side DUNDAS RD.
- 12.65 Pass Rd on LEFT
- 13.25 CRP
- 15.80 Turn Right Through Island Gate (Just before Gap) - House to the left of house
- 16.10 CRP
- 17.80 Turn R.L. Road
- 17.85 FREQUENT LEAD LINE THROUGH GAP
- 18.55 RUSSELL IS.

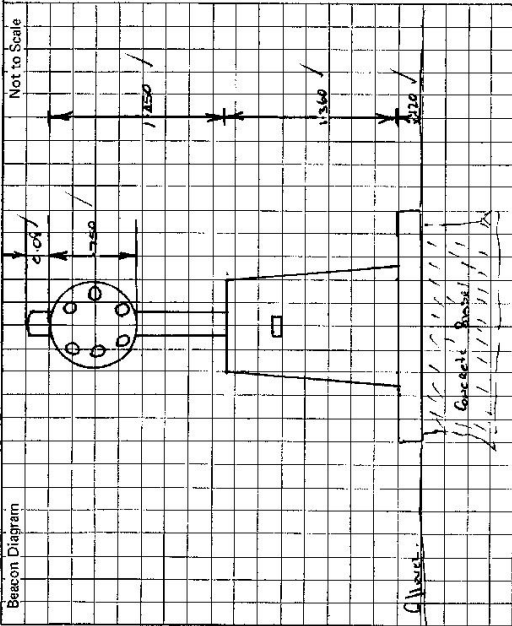

This section to be completed by officer constructing pillar.

Original station mark found/~~not found~~.

Description of mark: Stone with mark on top

Original beacon found/~~not found~~.

Description of beacon: Cast iron monument

Height Top of Vanes to Top Mark: 4.25 m.

Height of mark: 3.90 m. above / 3.90 m. below G.L.

Diameter of Vanes: 1.60 m. Height of Cairn: 1.30 m.

Original Beacon has/~~not~~ been destroyed by me.

Date	Record of Station

GEODETTIC SURVEY OF N.S.W.

CENTRAL MAPPING AUTHORITY

**GEODETTIC STATION RECONNAISSANCE and MAINTENANCE REPORT**


STATION: **BASALT GSOP** No.: **6320**

MAP SHEET SCALE 1:250 000 **HASTINGS**

INSPECTED BY: **I.W. Robins** DATE: **1-6-79**

AUTHORITY: **C.M.A.** ANGLE BOOK: **1761**

- Description:
- Note: *Cross out word or words which do not apply*
1. Cleared by lanes bearing..... from Trig. Mast
  2. Mast & Vanes have been painted white & black respectively.
  3. The station/pillar was unpiled/not unpiled/constructed on....., dimensions now being: Description of mark..... should be explicit, e.g., S/Steel Pillar Plate, Steel plug, Brass plug, Bolt, G.L. Pipe
  - Height of mark.....m. <sup>above</sup> <sub>below</sub> rock/concrete; Mark is.....m. <sup>above</sup> <sub>below</sub> G.L.
  - Height of Top Vanes to Top Mark/Pillar plate.....m. Diameter of Vanes (vertical).....m.
  - Height of Cairn.....m. Diameter of Cairn.....m. Name Plate found/not found/placed.
  - Length of Mast.....m. (approximate if not unpiled)
  4. A..... set in conc./rock has been placed/found, bearing.....° M from Mast/Plug/Pillar
  5. A..... set in conc./rock has been placed/found, bearing.....° M from Mast/Plug/Pillar
  6. A..... set in conc./rock has been placed/found, bearing.....° M from Mast/Plug/Pillar
  7. A..... set in conc./rock has been placed/found, bearing.....° M from Mast/Plug/Pillar
  8. Action required:.....

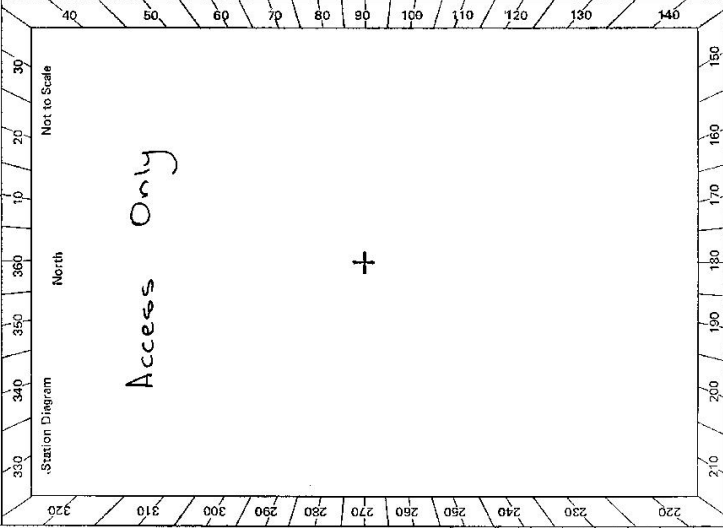

STANDPOINT:							
Mark	Direction	Horiz. Distance	Height Difference	Mark	Direction	Horiz. Distance	Height Difference
			above standpt.				above standpt.
			below				below
			above standpt.				above standpt.
			below				below
Prepared by: **I. Robins 29/2/79** Checked: **I.W. Robins** Noted on U.T.M. Card

